


BERLIN TOWNSHIP  
 1ST. QTR., LOT 9  
 T-9 N R-6 W  
 HOLMES COUNTY, OHIO

VOL 18 PAGE 498

SURVEYED FOR: LEVI SOMMERS

200300020555  
 Filed for Record in  
 HOLMES COUNTY, OH  
 SALLY MILLER  
 01-10-2003 03:09 pm.  
 SMALL PLAT 20.00  
 DR Book 18 Page 498 - 498  
 or vol 135 page 33

INDEXED

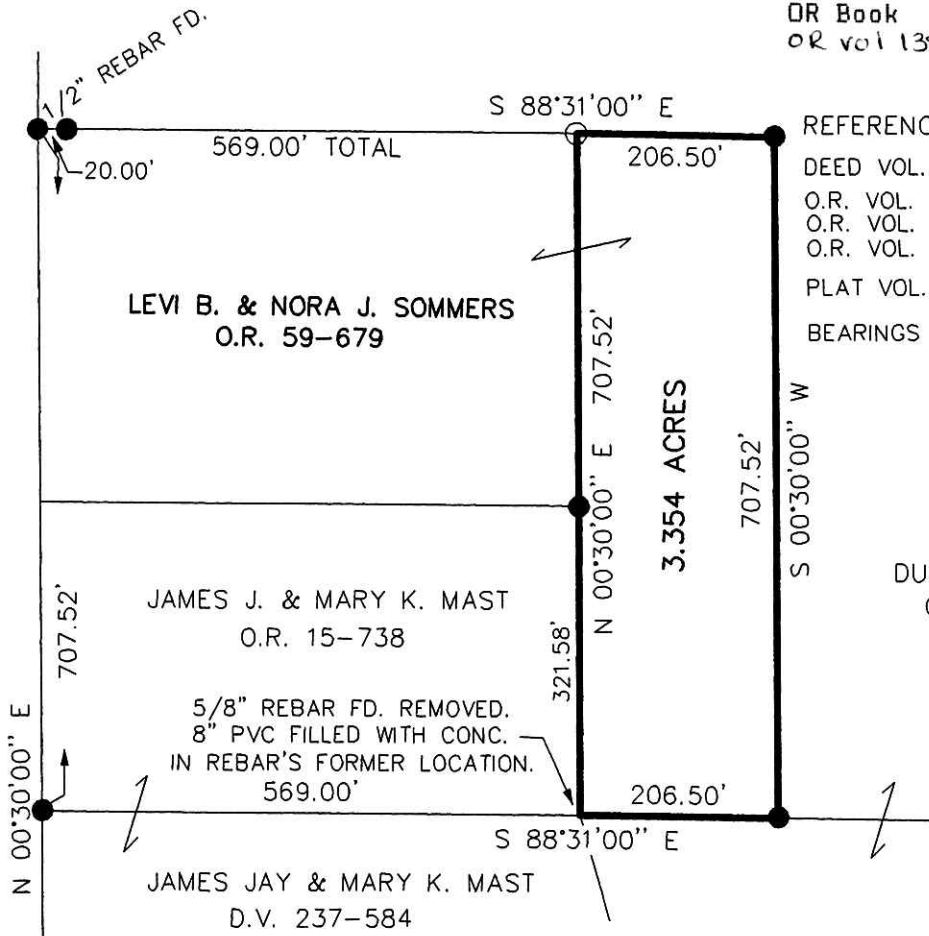


REFERENCES:  
 DEED VOL. 237 PAGE 584  
 O.R. VOL. 15 PAGE 738  
 O.R. VOL. 59 PAGE 679  
 O.R. VOL. 68 PAGE 567  
 PLAT VOL. 16 PAGE 846  
 BEARINGS FROM PLAT VOL. 16 PAGE 846

200300020555  
 PAUL A  
 MILLER LAW  
 MILLERSBURG,

DUANE L. MILLER  
 O.R. 68-567

020221  
 APPROVED FOR TRANSFER ONLY  
 NO SUBDIVISION PLAT REQUIRED  
 (O.R.C. 711.001 & 711.131)  
 Lot(s) not for building unless  
 approved by Board of Health.  
 HOLMES CO. PLANNING COMM.  
 By AO Date 12/20/02

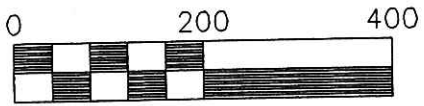

Scale 1" = 200'

- 5/8" REBAR FOUND UNLESS OTHERWISE NOTED
- 5/8" REBAR WITH I.D. CAP SET I.D. CAP MARKED "BAKER 6938"



PLAT APPROVED  
 12/23/2002

10 9  
 15 14

● DONALD C. BAKER SURVEYING  
 138 N. CLAY ST.  
 MILLERSBURG, OHIO 44654  
 PH. 330-674-4788  
 FAX 330-674-6027

I CERTIFY THIS SURVEY TO BE CORRECT TO THE BEST OF MY KNOWLEDGE.  
Donald C Baker  
 DONALD C. BAKER P.S. 6938  
 KES/ FCC DATE: NOV. 4, 2002  
 File name: C:\JOBS1\S-812-02\ERZ