


**PRAIRIE TOWNSHIP
S.W. QTR., SECTION 29
T-14 N; R-13 W
HOLMES COUNTY, OHIO**

SURVEYED FOR: GALEN YODER



200300022835
Filed for Record in
HOLMES COUNTY, OH
SALLY MILLER
04-25-2003 11:11 am.
SMALL PLAT 20.00
OR Book 18 Page 598 - 598
OR 146pg 611

REFERENCES:

- DEED VOL. 226 PAGES 272 & 274
- DEED VOL. 251 PAGE 795
- DEED VOL. 252 PAGE 276
- DEED VOL. 254 PAGE 604
- PLAT VOL. 10 PAGE 374
- PLAT VOL. 12 PAGES 176, 680 & 871
- BEARINGS FROM PLAT VOL. 12 PAGE 176

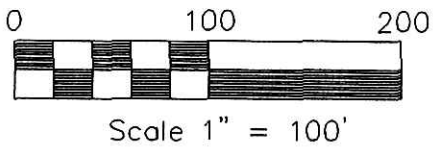

- ▲ R.R. SPIKE FOUND
- 5/8" REBAR FOUND
- 5/8" REBAR WITH I.D. CAP SET
I.D. CAP MARKED "BAKER 6938"

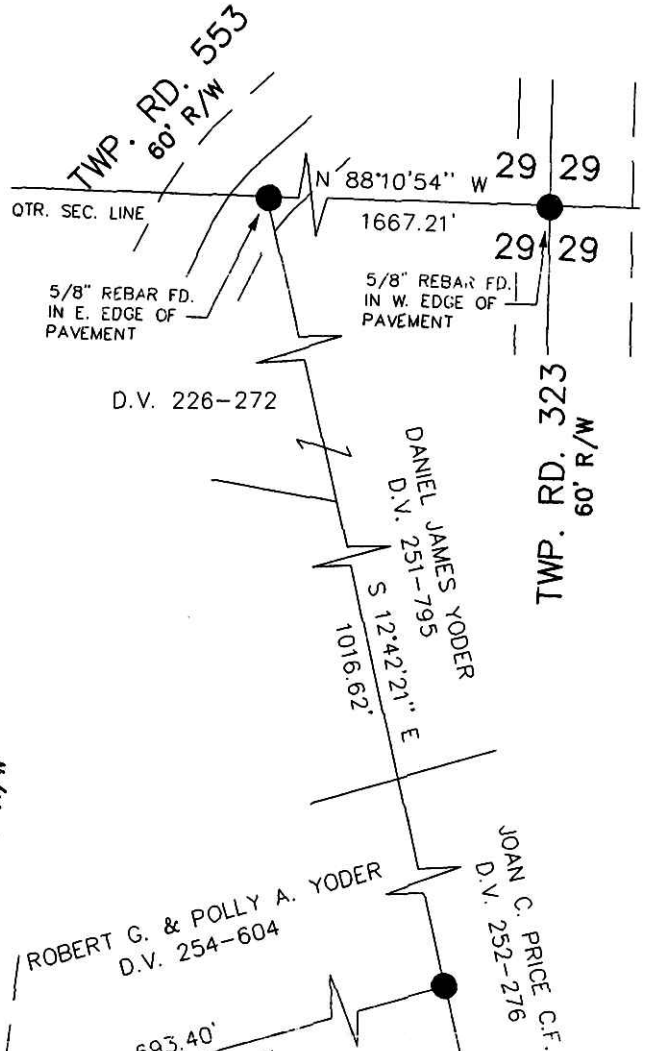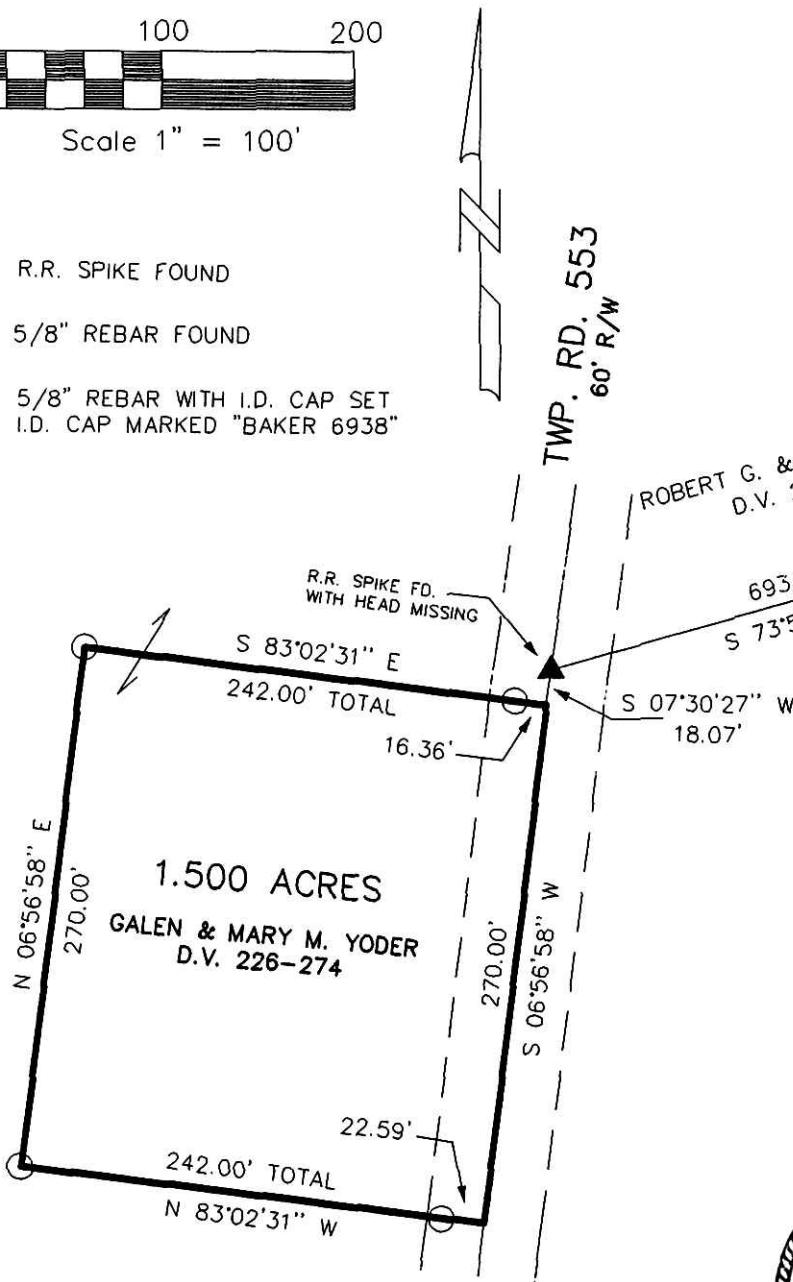

030070
APPROVED FOR TRANSFER ONLY
NO SUBDIVISION PLAT REQUIRED
(O.R.C. 711.001 & 711.131)
Lot(s) not for building unless
approved by Board of Health.
HOLMES CO. PLANNING COMM.

By AO Date 4/23/03



200300022835
M RICHARD COLDREN
GAYLA S COLDREN
912 W MAIN ST
WESTERVILLE, OH 43081

PLAT APPROVED

4/24/2003



DONALD C. BAKER SURVEYING
138 N. CLAY ST.
MILLERSBURG, OHIO 44654
PH. 330-674-4788
FAX 330-674-6027

I CERTIFY THIS SURVEY TO BE CORRECT
TO THE BEST OF MY KNOWLEDGE.

Donald C. Baker
DONALD C. BAKER P.S. 6938