


REFERENCES:
Deed Vol. 252 Page 952

CLARK TOWNSHIP
S.E. QTR. SECTION 4
T. 8 N; R. 5 W
HOLMES COUNTY, OHIO
(SURVEYED FOR: ROY MILLER)

200300025904
Filed for Record in
HOLMES COUNTY, OH
SALLY MILLER
09-05-2003 At 01:43 pm.
SMALL PLAT 40.00
OR Book 18 Page 719 - 719
OR vol 163 p 479


INDEXED

200300025904
SAMUEL M
STEIMEL ATTY
MILLERSBURG,

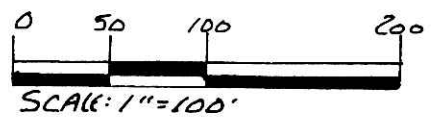

- STONE FOUND
- 5/8" REBAR FOUND
- 5/8" REBAR WITH I.D. CAP SET
I.D. CAP MARKED "BAKER 6938"

REBAR FD. DESTROYED
BY FENCE BUILDING
RESET AS SHOWN

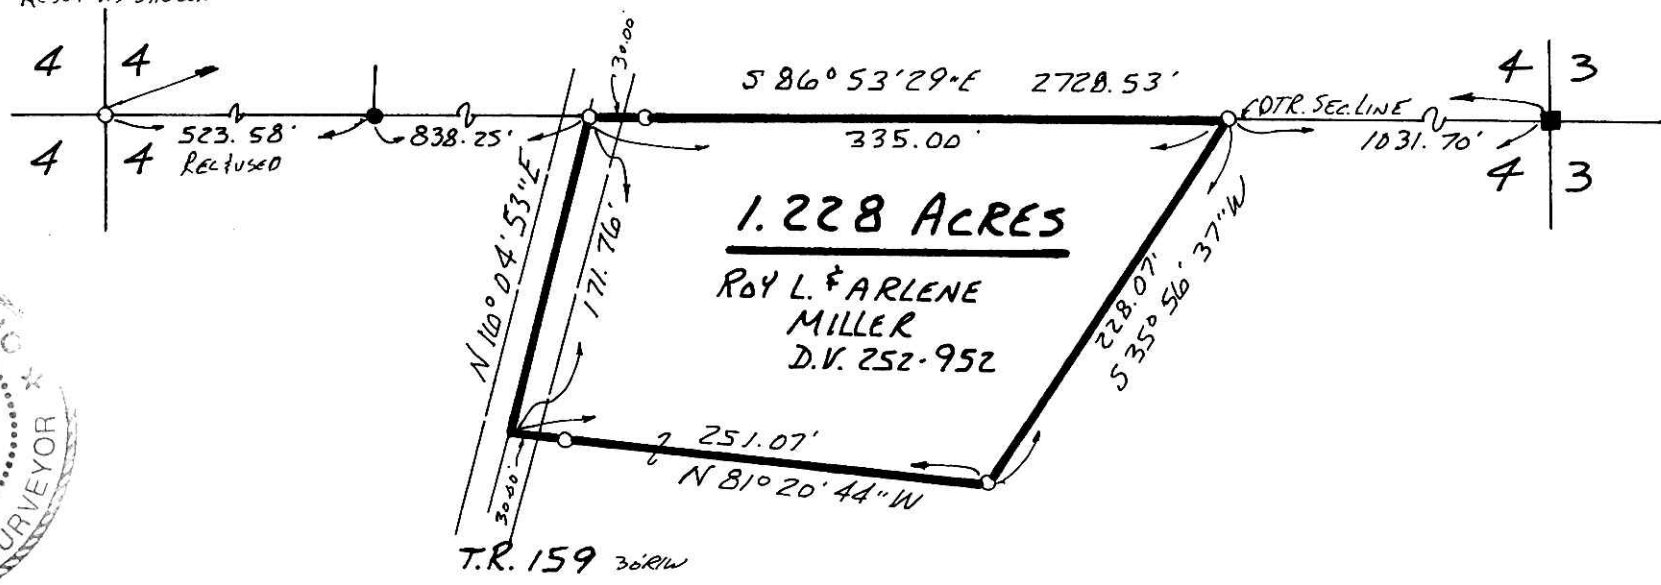

I CERTIFY THIS SURVEY TO BE CORRECT
TO THE BEST OF MY KNOWLEDGE.

Donald C Baker
DONALD C. BAKER P.S. 6938
DONALD C. BAKER SURVEYING
138 N. CLAY ST.
MILLERSBURG, OHIO 44654
PH. 330-674-4788
APRIL 19, 2002

PLAT APPROVED

9/3/2003

030186
APPROVED FOR TRANSFER ONLY
NO SUBDIVISION PLAT REQUIRED
(O.R.C. 711.001 & 711.131)
Lot(s) not for building unless
approved by Board of Health.
HOLMES CO. PLANNING COMM.

By AD Date 9/2/03

#17502-211D.
fcc - dcb