

SCALE: 1" = 60'

- IRON PIN FOUND
- 5/8" Re BAR WITH I.D. CAP SET
- I.D. CAP MARKED "BAKER 6938"
- P.K. NAIL SET

REFERENCES:

- DEED VOL. 272 PAGE 875
- " " 128 " 190
- " " 277 " 112
- " " 241 " 213
- " " 185 " 610
- " " 174 " 421

O.R. VOL. 28 PAGE 733

- PLAT VOL. 3 PG. 73
- " " 3 " 84
- " " 7 " 716
- " " 7 " 317

BEARINGS FROM PLAT VOL. 3 PG. 84


WALNUT CREEK TOWNSHIP
 S.W. QTR. SECTION 24
 T. 9 N.; R. 4 W
 HOLMES COUNTY, OHIO
 (SURVEYED FOR: JOHN SHETLER & JOHN WEAVER)

PLAT OF CORRECTION
 OF PLAT VOL. 17 PAGE 307

200300026624
 PAUL A
 MILLER LAW
 MILLERSBURG, OH

200300026624
 Filed for Record in
 HOLMES COUNTY, OH
 SALLY MILLER
 10-08-2003 At 03:30 pm.
 PLAT MED 43.20
 OR Book 18 Page 755 - 755
 OR vol 167 pg 765

INDEXED

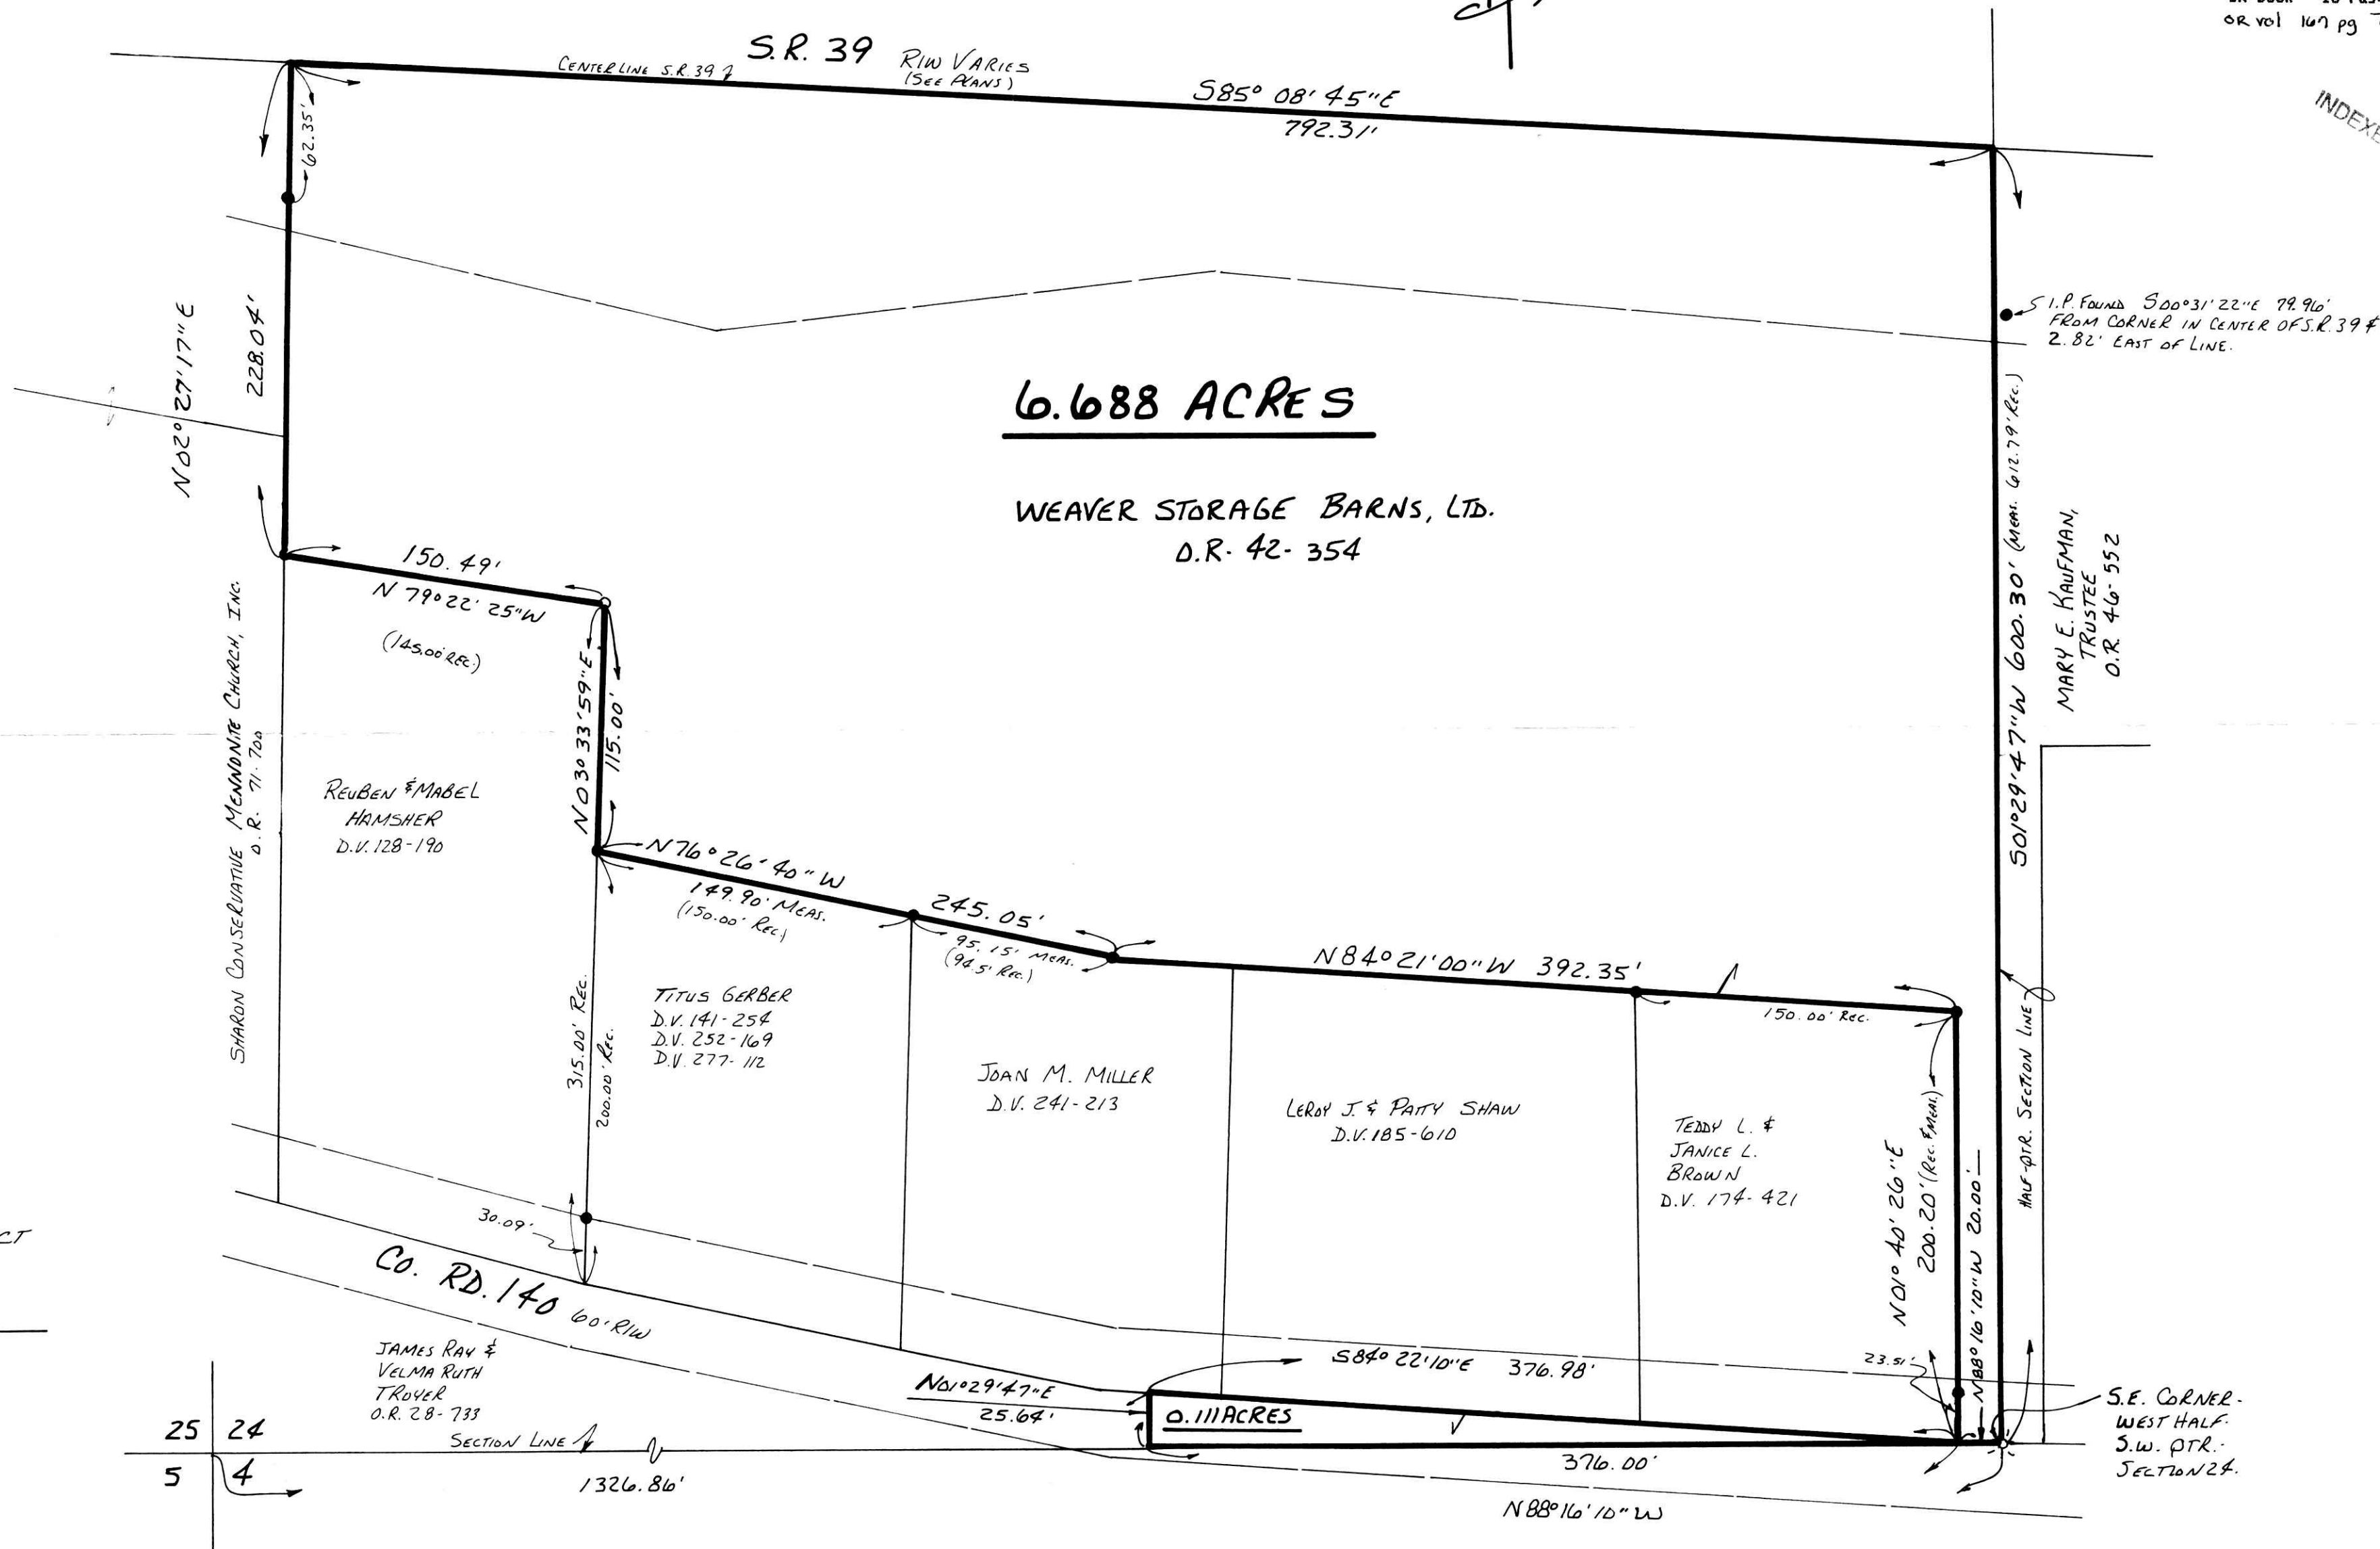

I CERTIFY THIS SURVEY TO BE CORRECT TO THE BEST OF MY KNOWLEDGE.

Donald C. Baker

DONALD C. BAKER P.S. 6938

DONALD C. BAKER SURVEYING
 138 N. CLAY ST.
 MILLERSBURG, OHIO 44654

PH. (330) 674-4788

OCTOBER 11, 1999

#63499 - M.L. DAVIS
 (#69799 - DW)

F.C.C. - F.D. BAKER

REVISED JUNE 26, 2003

PLAT APPROVED

10/8/2003