

Instrument Book Page
200300026982 DR 18 776

RETRACEMENT SURVEY OF O.R. 137-881

PAINT TOWNSHIP
3RD. QTR., LOT 34
T-10 N; R-4 W
HOLMES COUNTY, OHIO

SURVEYED FOR: UNITED STATES of AMERICA

REFERENCES:



DEED VOL. 260 PAGE 933
DEED VOL. 253 PAGE 446
DEED VOL. 263 PAGE 566
DEED VOL. 277 PAGE 580

O.R. VOL. 64 PAGE 727
O.R. VOL. 57 PAGE 620
O.R. VOL. 102 PAGE 662
O.R. VOL. 137 PAGE 881
O.R. VOL. 142 PAGE 237

PLAT VOL. 2 PAGE 315
PLAT VOL. 2A PAGE 165
PLAT VOL. 8 PAGE 658
PLAT VOL. 15 PAGE 136
PLAT VOL. 17 PAGE 739


BEARINGS FROM PLAT VOL. 17 PAGE 739

AMANDA L. TROYER
D.V. 193-259
D.V. 266-742
O.R. 27-719
O.R. 142-237

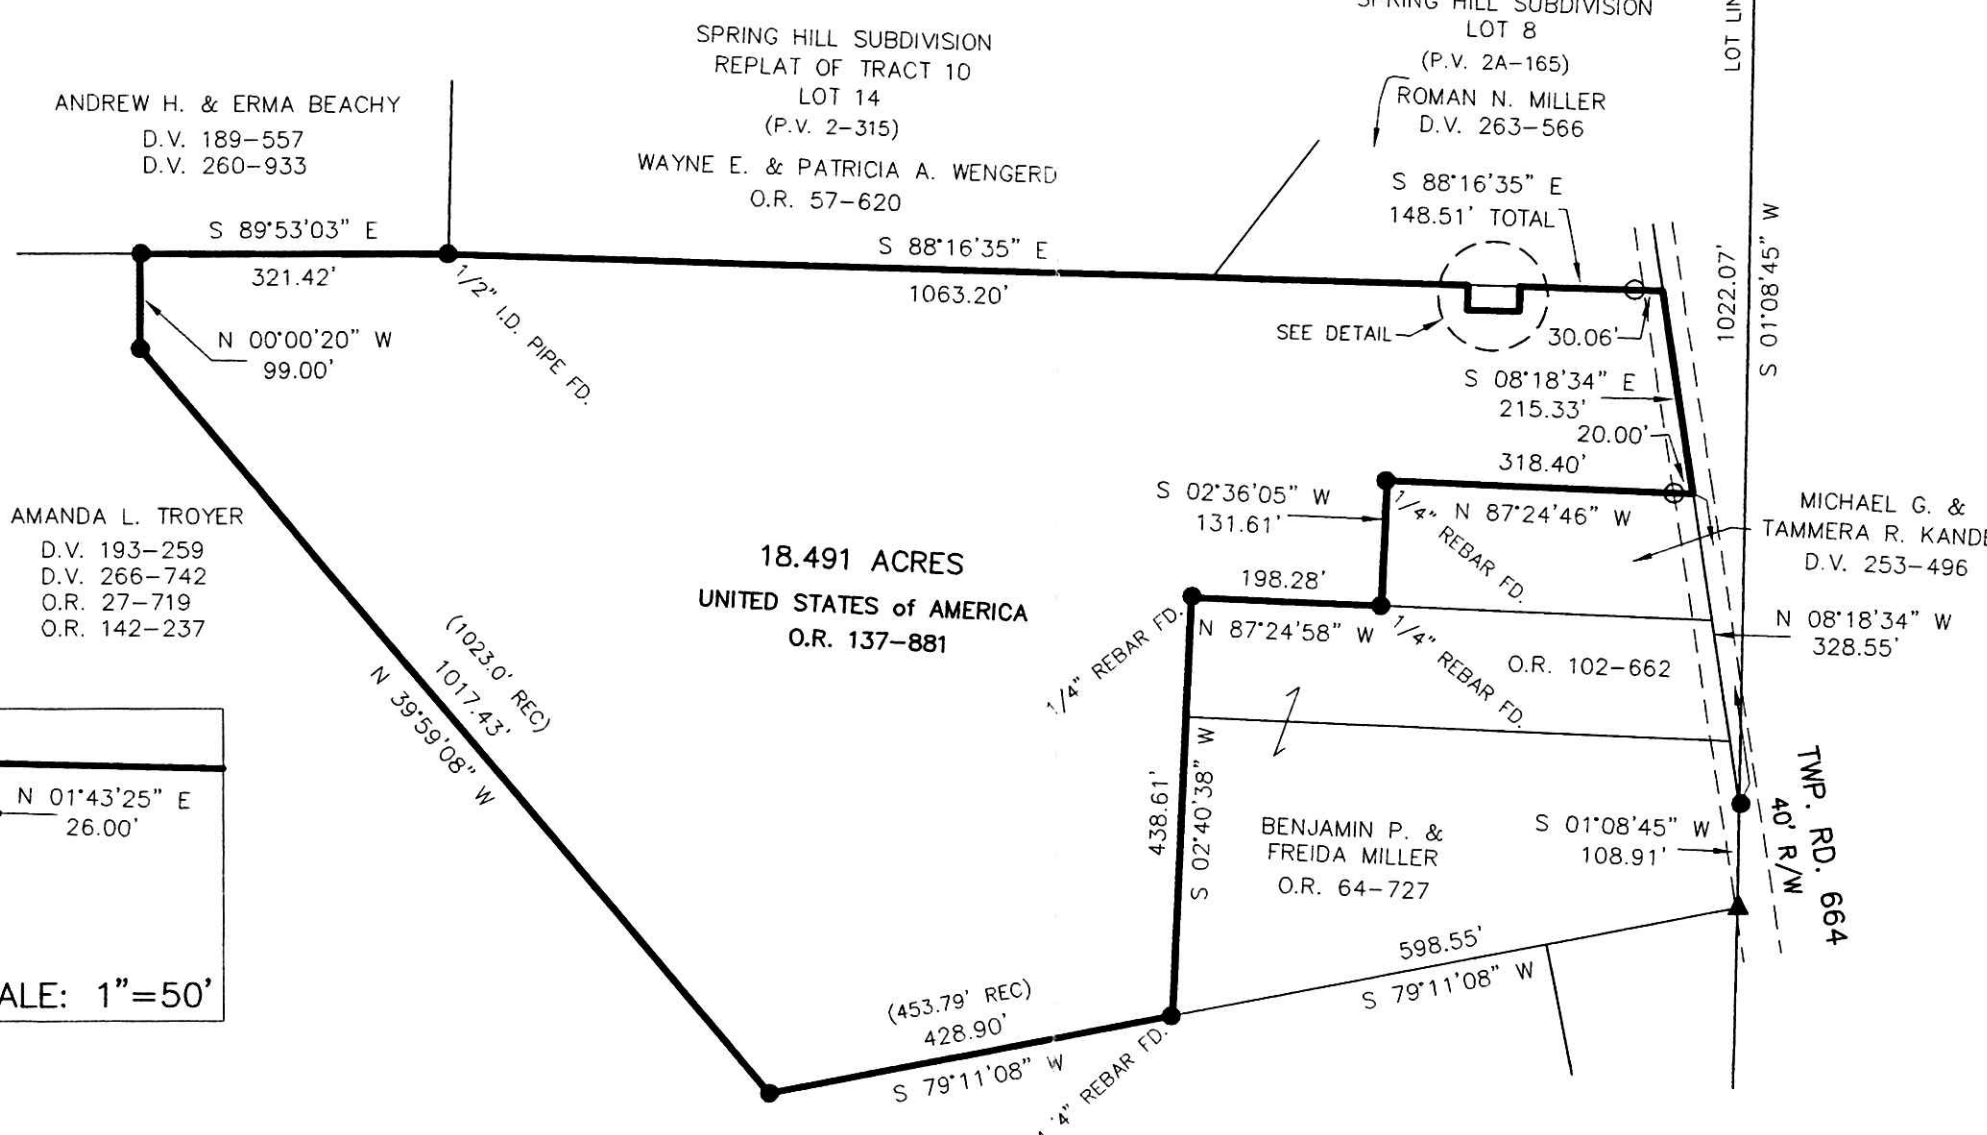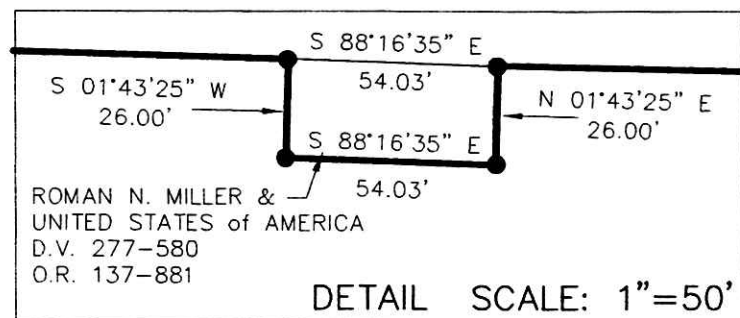

INDEXED

200300026982
Filed for Record in
HOLMES COUNTY, OH
SALLY MILLER
10-28-2003 At 02:32 PM.
SMALL PLAT 40.00
DR Book 18 Page 776 - 776
OK vol 167 page 2308

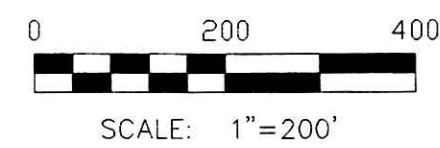

- STONE FOUND
- ▲ R.R. SPIKE FOUND
- 5/8" REBAR FOUND
- UNLESS OTHERWISE NOTED
- 5/8" REBAR WITH I.D. CAP SET I.D. CAP MARKED "BAKER 6938"

PLAT APPROVED

10/28/2003




I CERTIFY THIS SURVEY TO BE CORRECT TO THE BEST OF MY KNOWLEDGE.

Donald C. Baker
DONALD C. BAKER PS 6938
DATE: AUG. 18, 2003

FDB\LAB
File Name: C:\WORK\S-192-03\ERZ

200300026982
TOWER CITY
TITLE
HIGHLAND HTS, OH

 DONALD C. BAKER SURVEYING
138 N. CLAY ST.
MILLERSBURG, OH 44654
PH. 330-674-4788
FAX: 330-674-6027