

200400029402
 Filed for Record in
 HOLMES COUNTY, OH
 SALLY MILLER
 03-16-2004 At 01:14 pm.
 SMALL PLAT 40.00
 OR Book 19 Page 16 - 16

OR vol 170 page 2319

Instrument Book Page
 200400029402 OR 19 16

040038

APPROVED FOR TRANSFER ONLY
 NO SUBDIVISION PLAT REQUIRED
 (O.R.C. 711.001 & 711.131)
 Lot(s) not for building unless
 approved by Board of Health.
 HOLMES CO. PLANNING COMM.

By Date 3/15/04

INDEXED

VOL 0019 PAGE 016


I.P.(F) N.W. cor' N.E. 1/4 Sec. 9, T8N, R6W
 Mec. Twp., Hol. Co., Ohio

David A. & Amanda Troyer
 D.V. 269 Pg. 460


Data used:
 Tax Map
 D.V. 269 Pg. 460
 D.V. 280 Pg. 392

All section pins
 are 5/8" x 30" rebar
 with I.O. cap
 R.L.K. 5193.

Wayne L. & Barbara Raber D.V. 280 Pg. 392 (Bearing Basis)
 D.V. 280 Pg. 392

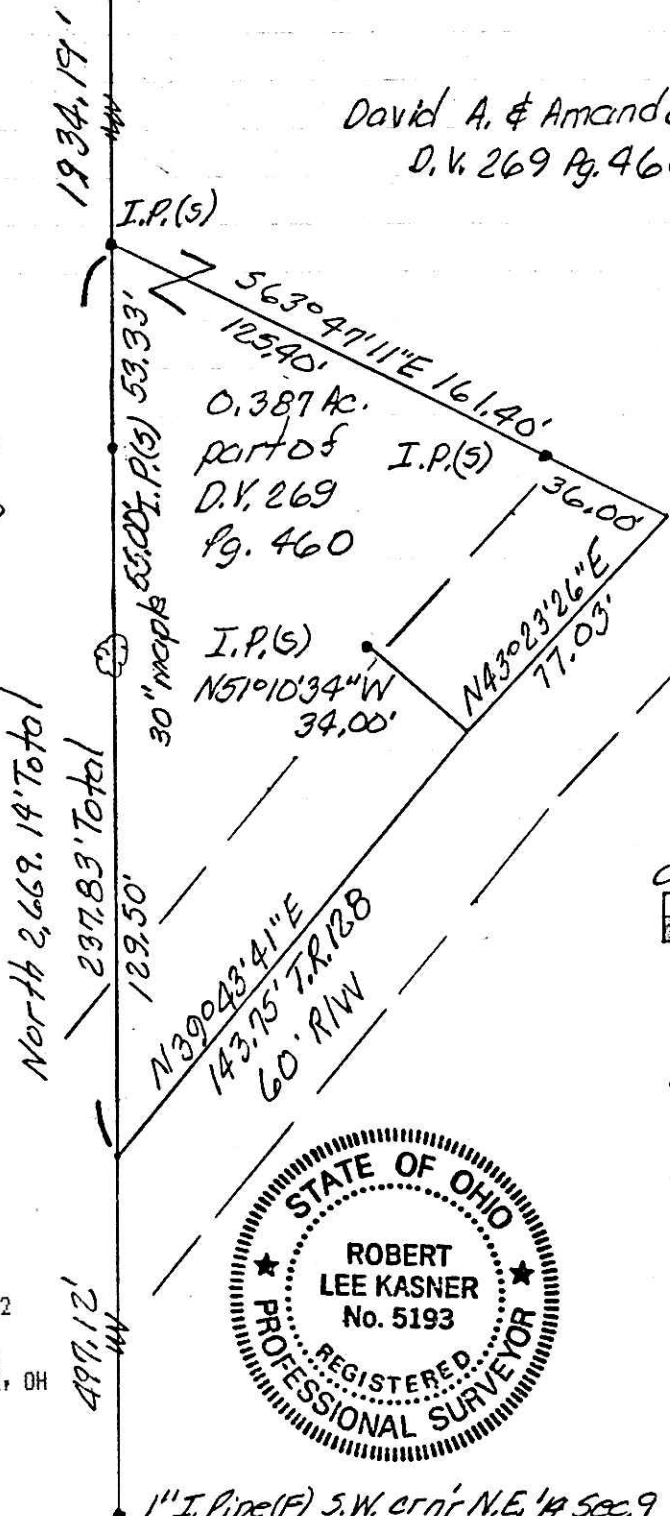

Scale: 1" = 50'

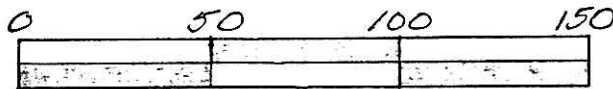

GRAPHIC SCALE IN FEET

Plot of a survey for Wayne L.
 & Barbara Raber (Grantees)
 known as part of the N.E. 1/4
 Sec. 9, T8N, R6W of Mechanic
 Twp., Holmes Co., Ohio
 Robert L. Kasner P.E., P.S.
 7007 S.R. 39
 Millersburg, Oh. 44654
 3306749146 1/29/04
 Robert L. Kasner P.E., P.S.



1" I. Pipe (F) S.W. cor' N.E. 1/4 Sec. 9
 T8N, R6W Mec. Twp. Hol. Co., Ohio

200400029402
 PAUL A
 MILLER LAW
 MILLERSBURG, OH

PLAT 19

3/16/2004