

PRAIRIE TOWNSHIP
N.E. QTR. SECTION 13
T-13 N; R-13 W
HOLMES COUNTY, OHIO


SURVEYED FOR: JONAS HOCHSTETLER

200400031763
MILLER &
MAST ATTYS
MILLERSBURG, OH

200400031763
Filed for Record in
HOLMES COUNTY, OH
SALLY MILLER
07-16-2004 At 01:36 pm.
SMALL PLAT 40.00
OR Book 19 Page 128 - 128
OR vol 173 page 2955

REFERENCES:

- O.R. VOL. 9 PAGES 203 & 212
- PLAT VOL. 16 PAGE 729
- PLAT VOL. 18 PAGE 250
- BEARINGS FROM PLAT VOL. 16 PAGE 729

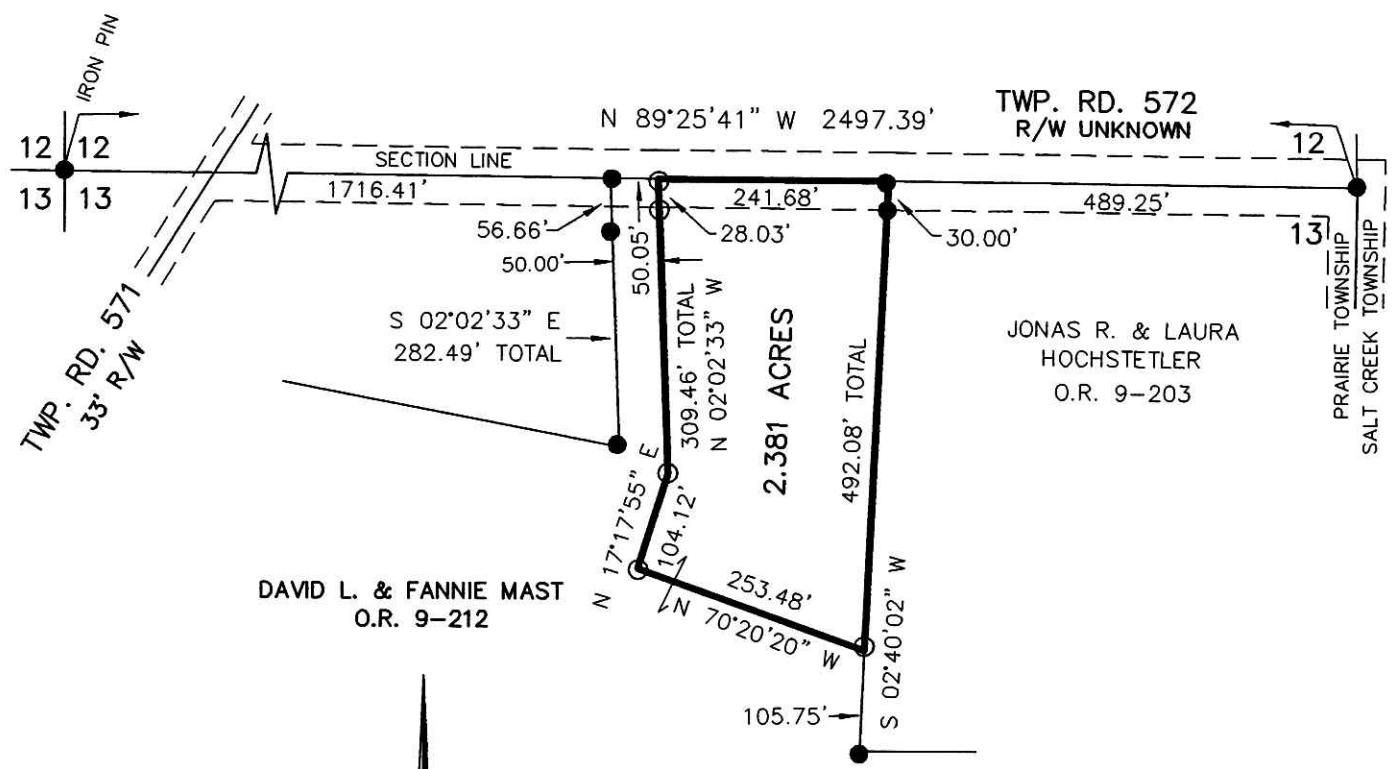


040121

APPROVED FOR TRANSFER ONLY
NO SUBDIVISION PLAT REQUIRED
(O.R.C. 711.001 & 711.131)
Lot(s) not for building unless
approved by Board of Health.
HOLMES CO. PLANNING COMM.

By DC Date 7/14/04



DONALD C. BAKER SURVEYING
138 N. CLAY ST.
MILLERSBURG, OH 44654
PH. 330-674-4788
FAX: 330-674-6027

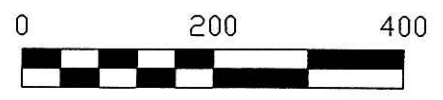

SCALE: 1"=200'

- 5/8" REBAR FOUND
UNLESS OTHERWISE NOTED
- 5/8" REBAR WITH I.D. CAP SET
I.D. CAP MARKED "BAKER 6938"

I CERTIFY THIS SURVEY TO BE CORRECT
TO THE BEST OF MY KNOWLEDGE.

Donald C. Baker

DONALD C. BAKER PS 6938
DATE: JUNE 1, 2004
REVISED: JUNE 17, 2004
FDB\AEG
File Name: C:\WORK\S-356-04\ERZ
REVISED # S-475-04

PLAT APPROVED
7/16/2004

Instrument
200400031763 OR
Book Page
19 128