

VILLAGE OF MILLERSBURG  
PART OF OUTLOT 37  
HOLMES COUNTY, OHIO

SURVEYED FOR: BETTY EMMONS

200400032304  
BLAIR BOWER, ATTY

200400032304  
Filed for Record in  
HOLMES COUNTY, OH  
SALLY MILLER  
08-16-2004 At 12:10 pm.  
SMALL PLAT 40.00  
OR Book 19 Page 155 - 155  
OR VOL 174 pg 1714


REFERENCES

- DEED VOL. 229 PAGE 169
- DEED VOL. 231 PAGE 8
- O.R. VOL. 7 PAGE 366
- PLAT VOL. 16 PAGE 701
- BEARINGS FROM PLAT VOL. 16 PAGE 701



Scale 1" = 30'

- 5/8" REBAR FOUND UNLESS OTHERWISE NOTED
- △ R.R. SPIKE SET
- 5/8" REBAR WITH ID CAP SET ID CAP MARKED "BAKER 6938"

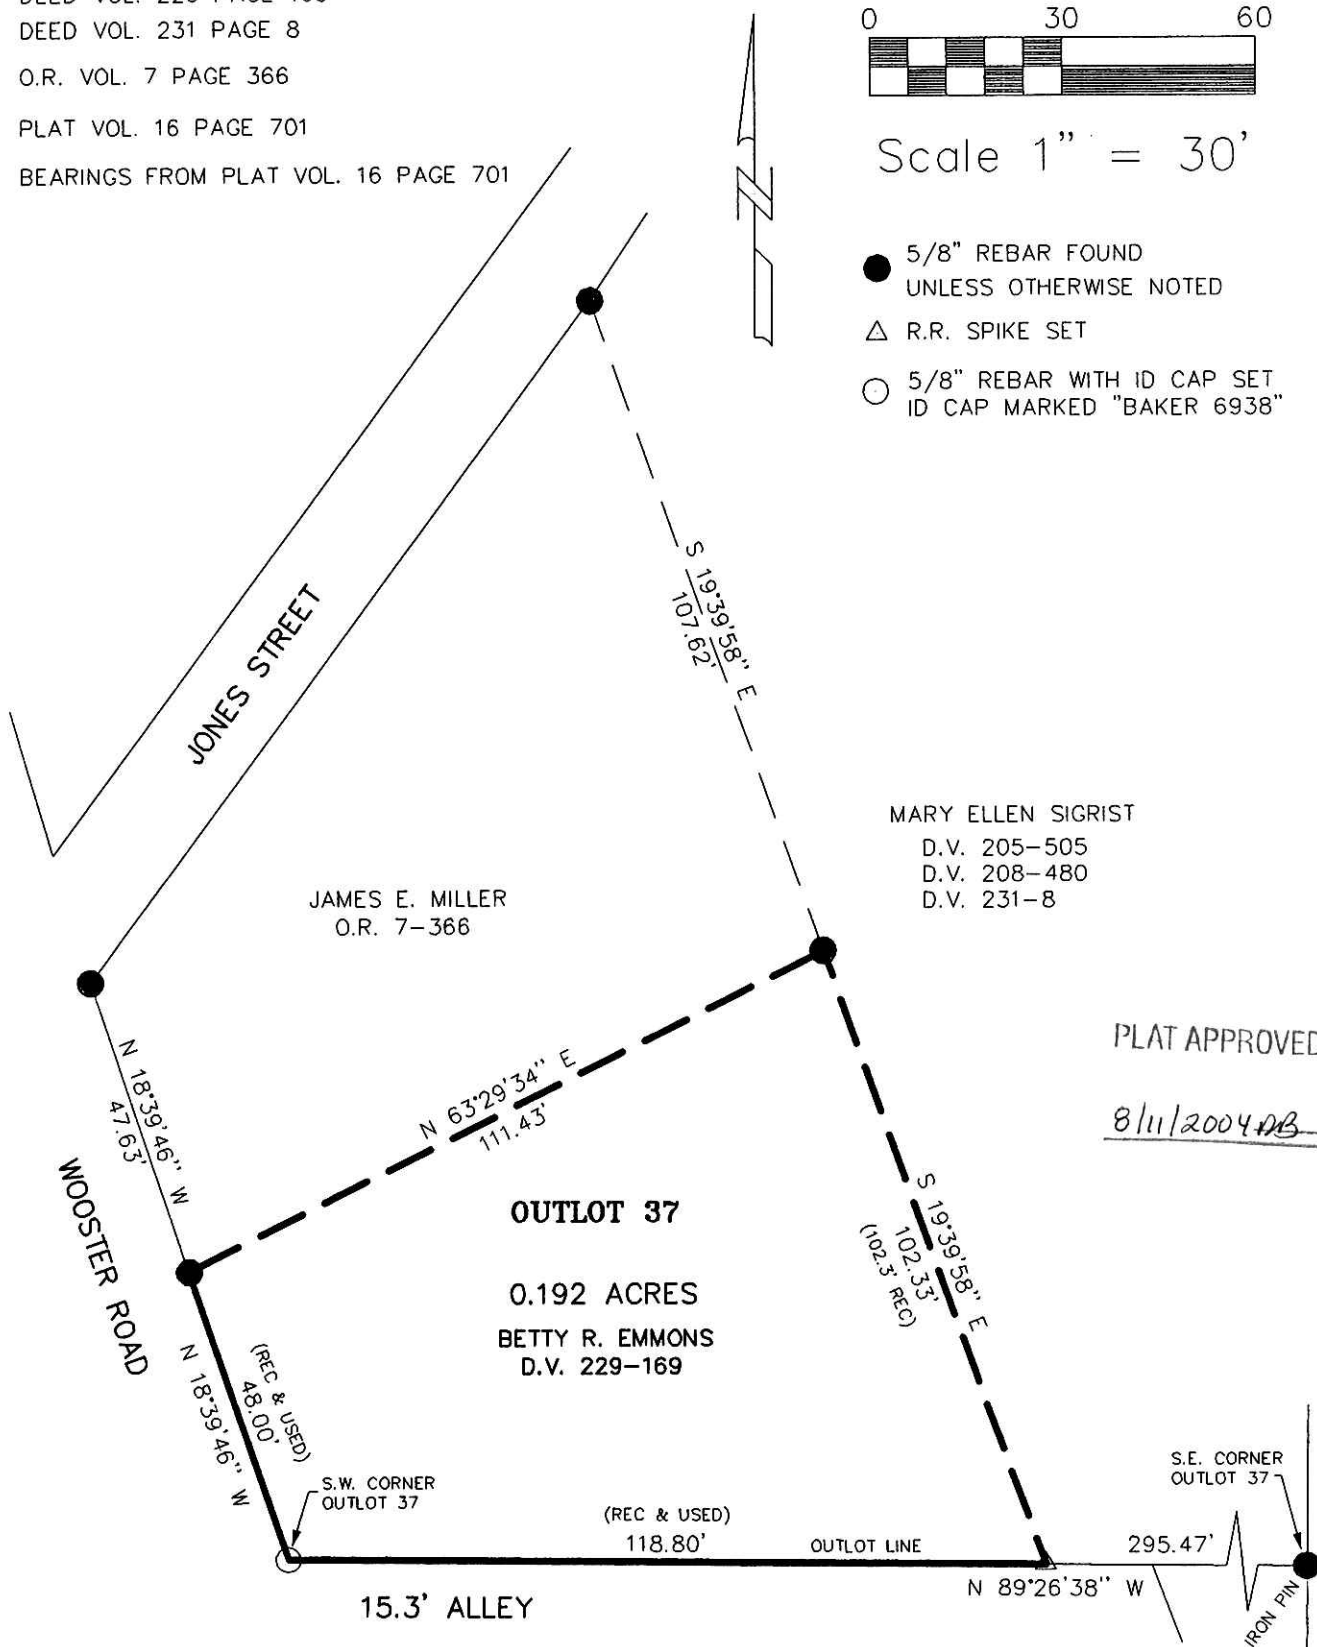

MARY ELLEN SIGRIST  
D.V. 205-505  
D.V. 208-480  
D.V. 231-8

PLAT APPROVED

8/11/2004 DB



CERTIFY THIS SURVEY TO BE CORRECT TO THE BEST OF MY KNOWLEDGE.

*Jamie D. Darr*  
 JAMIE D. DARR P.S. 7755  
 DATE: JULY 27, 2004  
 JDD\JAH  
 File Name: C:\JOBS1\S-574-04\ERZ



DONALD C. BAKER SURVEYING  
 138 N. CLAY ST.  
 MILLERSBURG, OHIO 44654  
 PH. 330-674-4788  
 FAX. 330-674-6027