

WASHINGTON TOWNSHIP
 N.W. QTR. SECTION 6
 T-19 N; R-15 W
 HOLMES COUNTY, OHIO

SURVEYED FOR: JERALD QUICKLE

REFERENCES:

DEED VOL. 236 PAGE 305

O.R. VOL. 82 PAGE 441
 O.R. VOL. 84 PAGE 248
 O.R. VOL. 169 PAGE 806
 O.R. VOL. 170 PAGE 1382
 O.R. VOL. 171 PAGES 137 & 288


PLAT VOL. 17 PAGE 488

BEARINGS FROM PLAT VOL. 17 PAGE 488

Instrument Book Page
 200400033320 DR 19 213


200400033320
 LANCE LOWE
 JERRICA LOWE
 16478 RT 39
 LOUDONVILLE, OH 44842

200400033320
 Filed for Record in
 HOLMES COUNTY, OH
 SALLY MILLER
 10-19-2004 At 08:38 am.
 SMALL PLAT 40.00
 DR Book 19 Page 213 - 213
 OR vol 175 page 2642

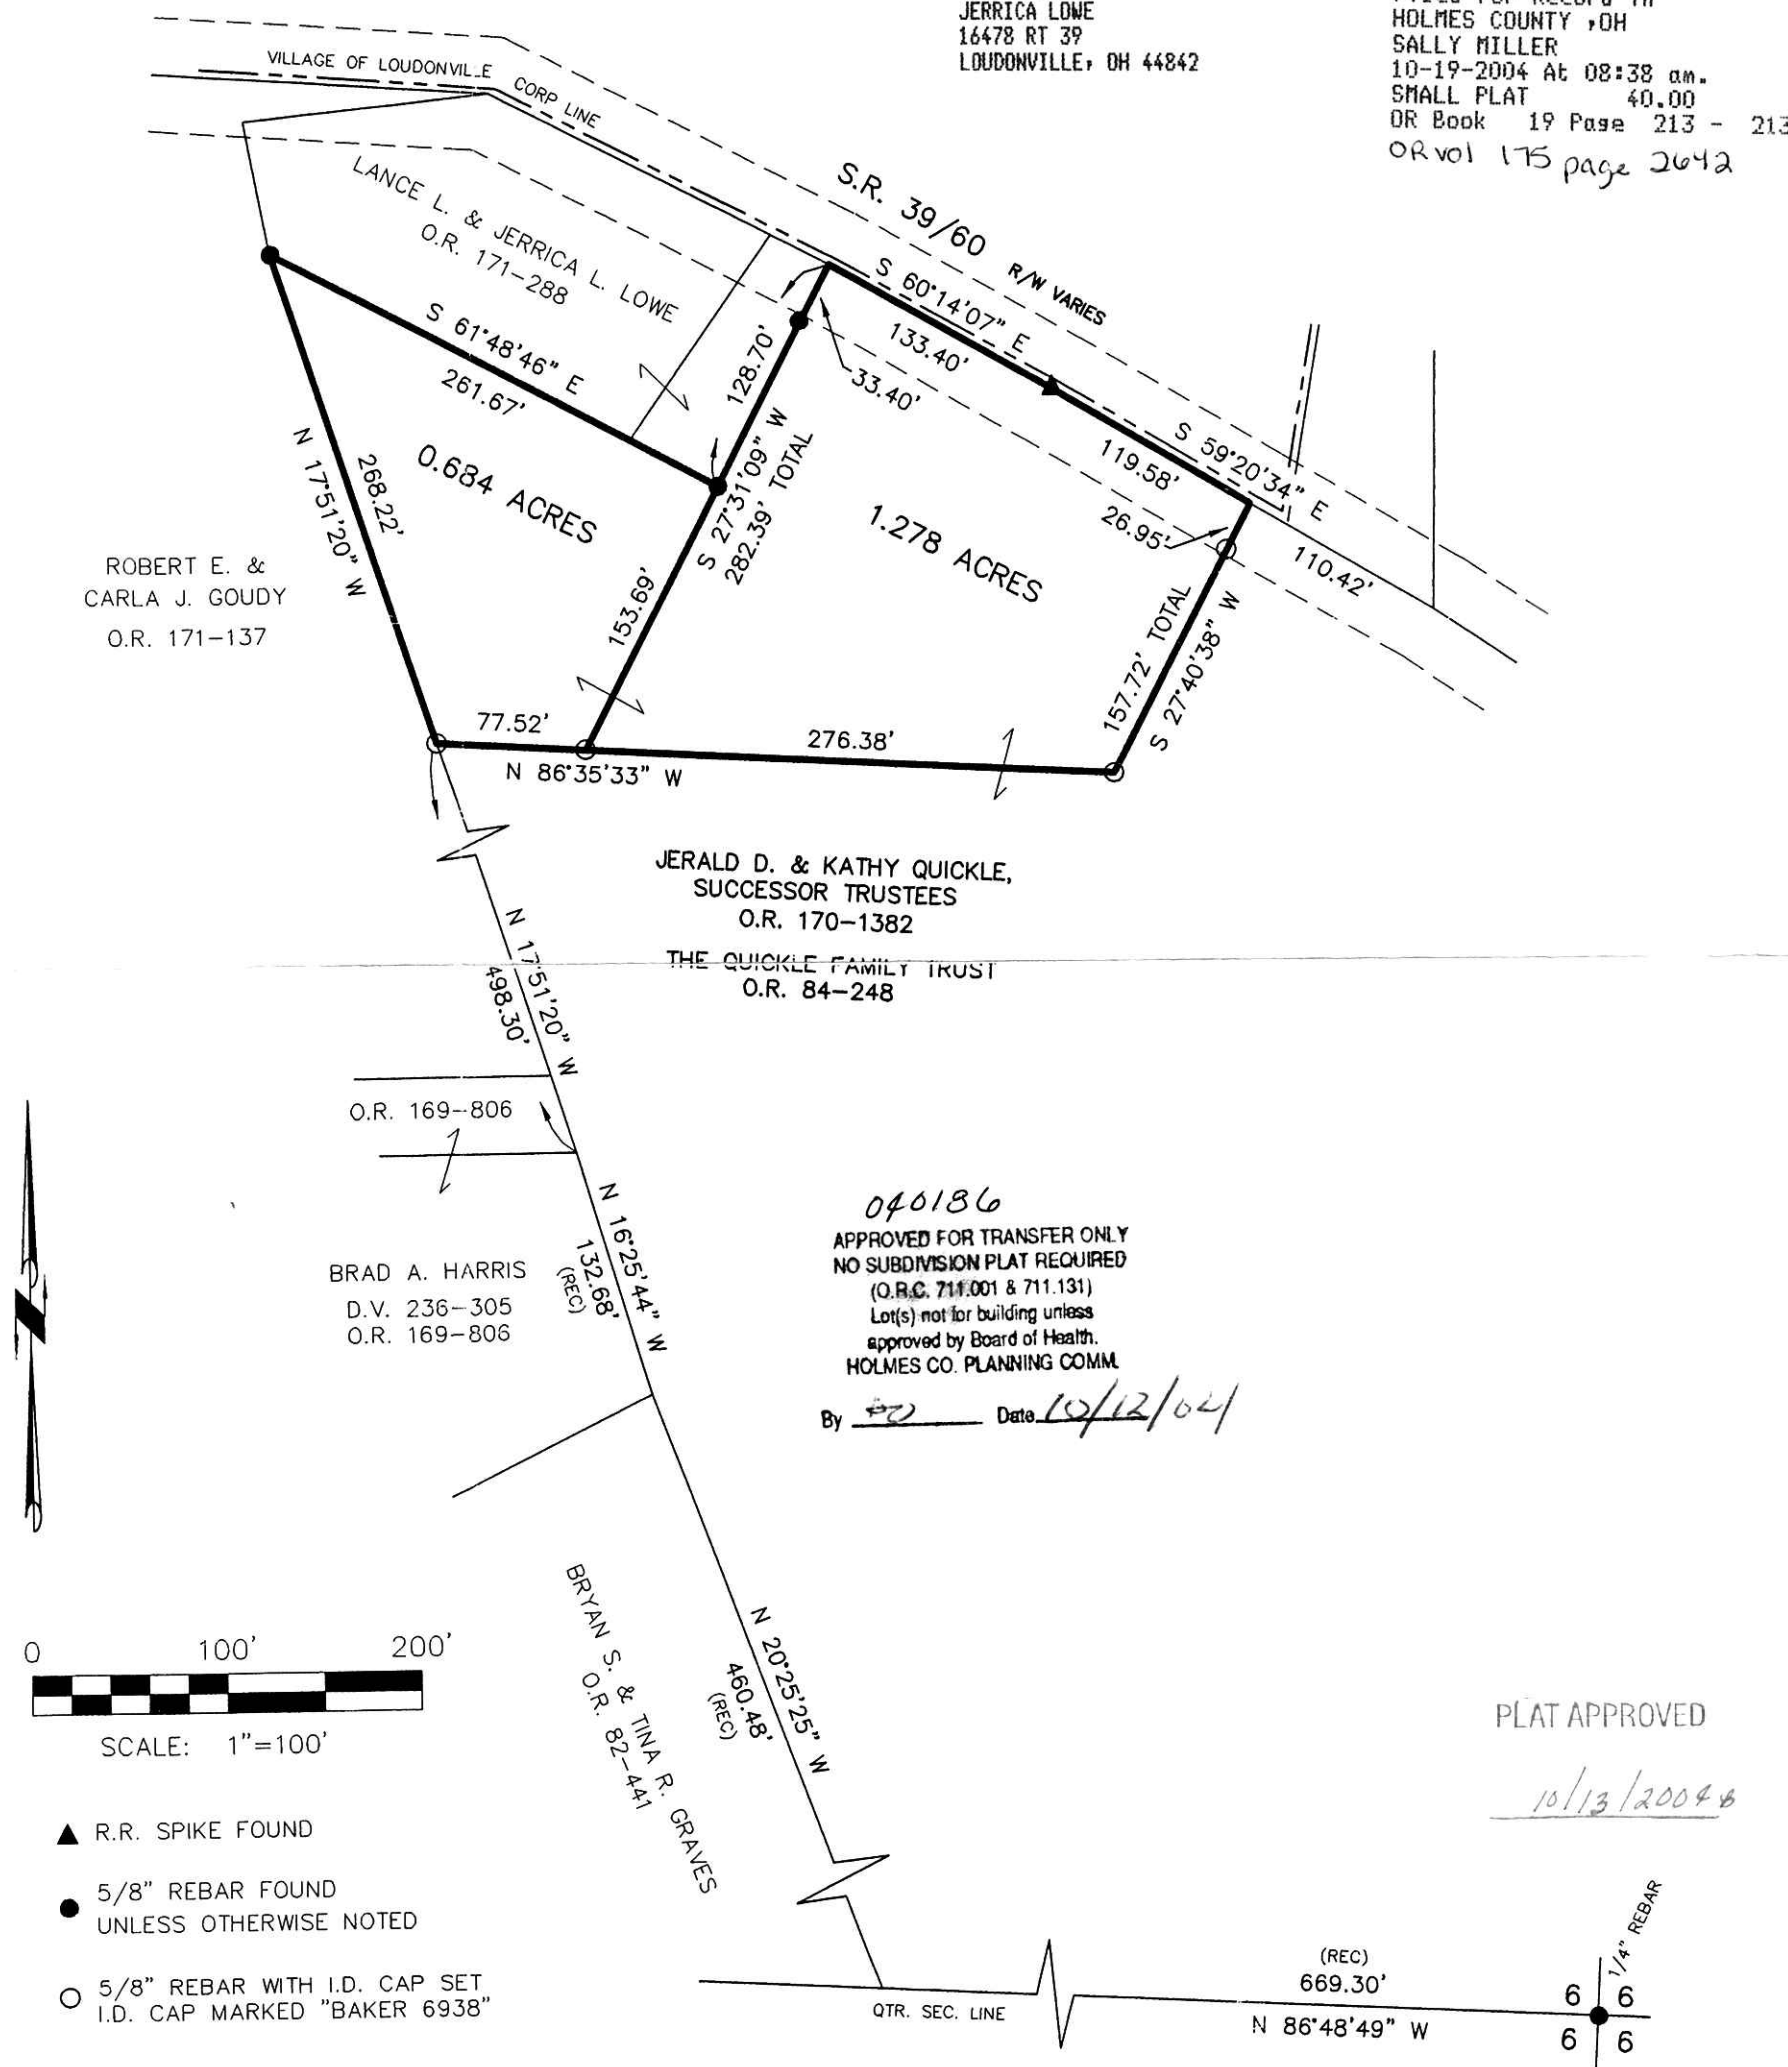

040186
 APPROVED FOR TRANSFER ONLY
 NO SUBDIVISION PLAT REQUIRED
 (O.R.C. 711.001 & 711.131)
 Lot(s) not for building unless
 approved by Board of Health.
 HOLMES CO. PLANNING COMM.
 By [Signature] Date 10/12/04

PLAT APPROVED
10/13/2004

 DONALD C. BAKER SURVEYING
 138 N. CLAY ST.
 MILLERSBURG, OH 44654
 PH. 330-674-4788
 FAX: 330-674-6027



I CERTIFY THIS SURVEY TO BE CORRECT
 TO THE BEST OF MY KNOWLEDGE.
Donald C. Baker
 DONALD C. BAKER PS 6938
 DATE: JUNE 1, 2004
 FDB\AEG
 File Name: C:\WORK\S-357-04\ERZ