

200400033478  
 Filed for Record in  
 HOLMES COUNTY, OH  
 SALLY MILLER  
 10-28-2004 At 10:03 am.  
 PLAT MED 43.20  
 DR Book 19 Page 225 - 225  
 CR vol 175 page 3333+3335

KNOX TOWNSHIP  
 4TH. QTR., LOTS 26 & 27  
 T-9 N; R-9 W  
 HOLMES COUNTY, OHIO



SURVEYED FOR: LUTHER LAHM

REFERENCES:

O.R. VOL. 24 PAGE 692  
 O.R. VOL. 48 PAGE 4  
 O.R. VOL. 100 PAGE 781  
 DEED VOL. 179 PAGE 522

PLAT VOL. 2 PAGE 330  
 PLAT VOL. 7 PAGE 200  
 PLAT VOL. 18 PAGE 335

BEARINGS FROM PLAT VOL. 7 PAGE 200

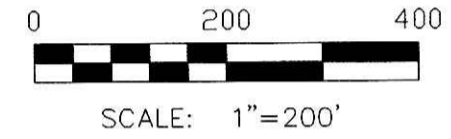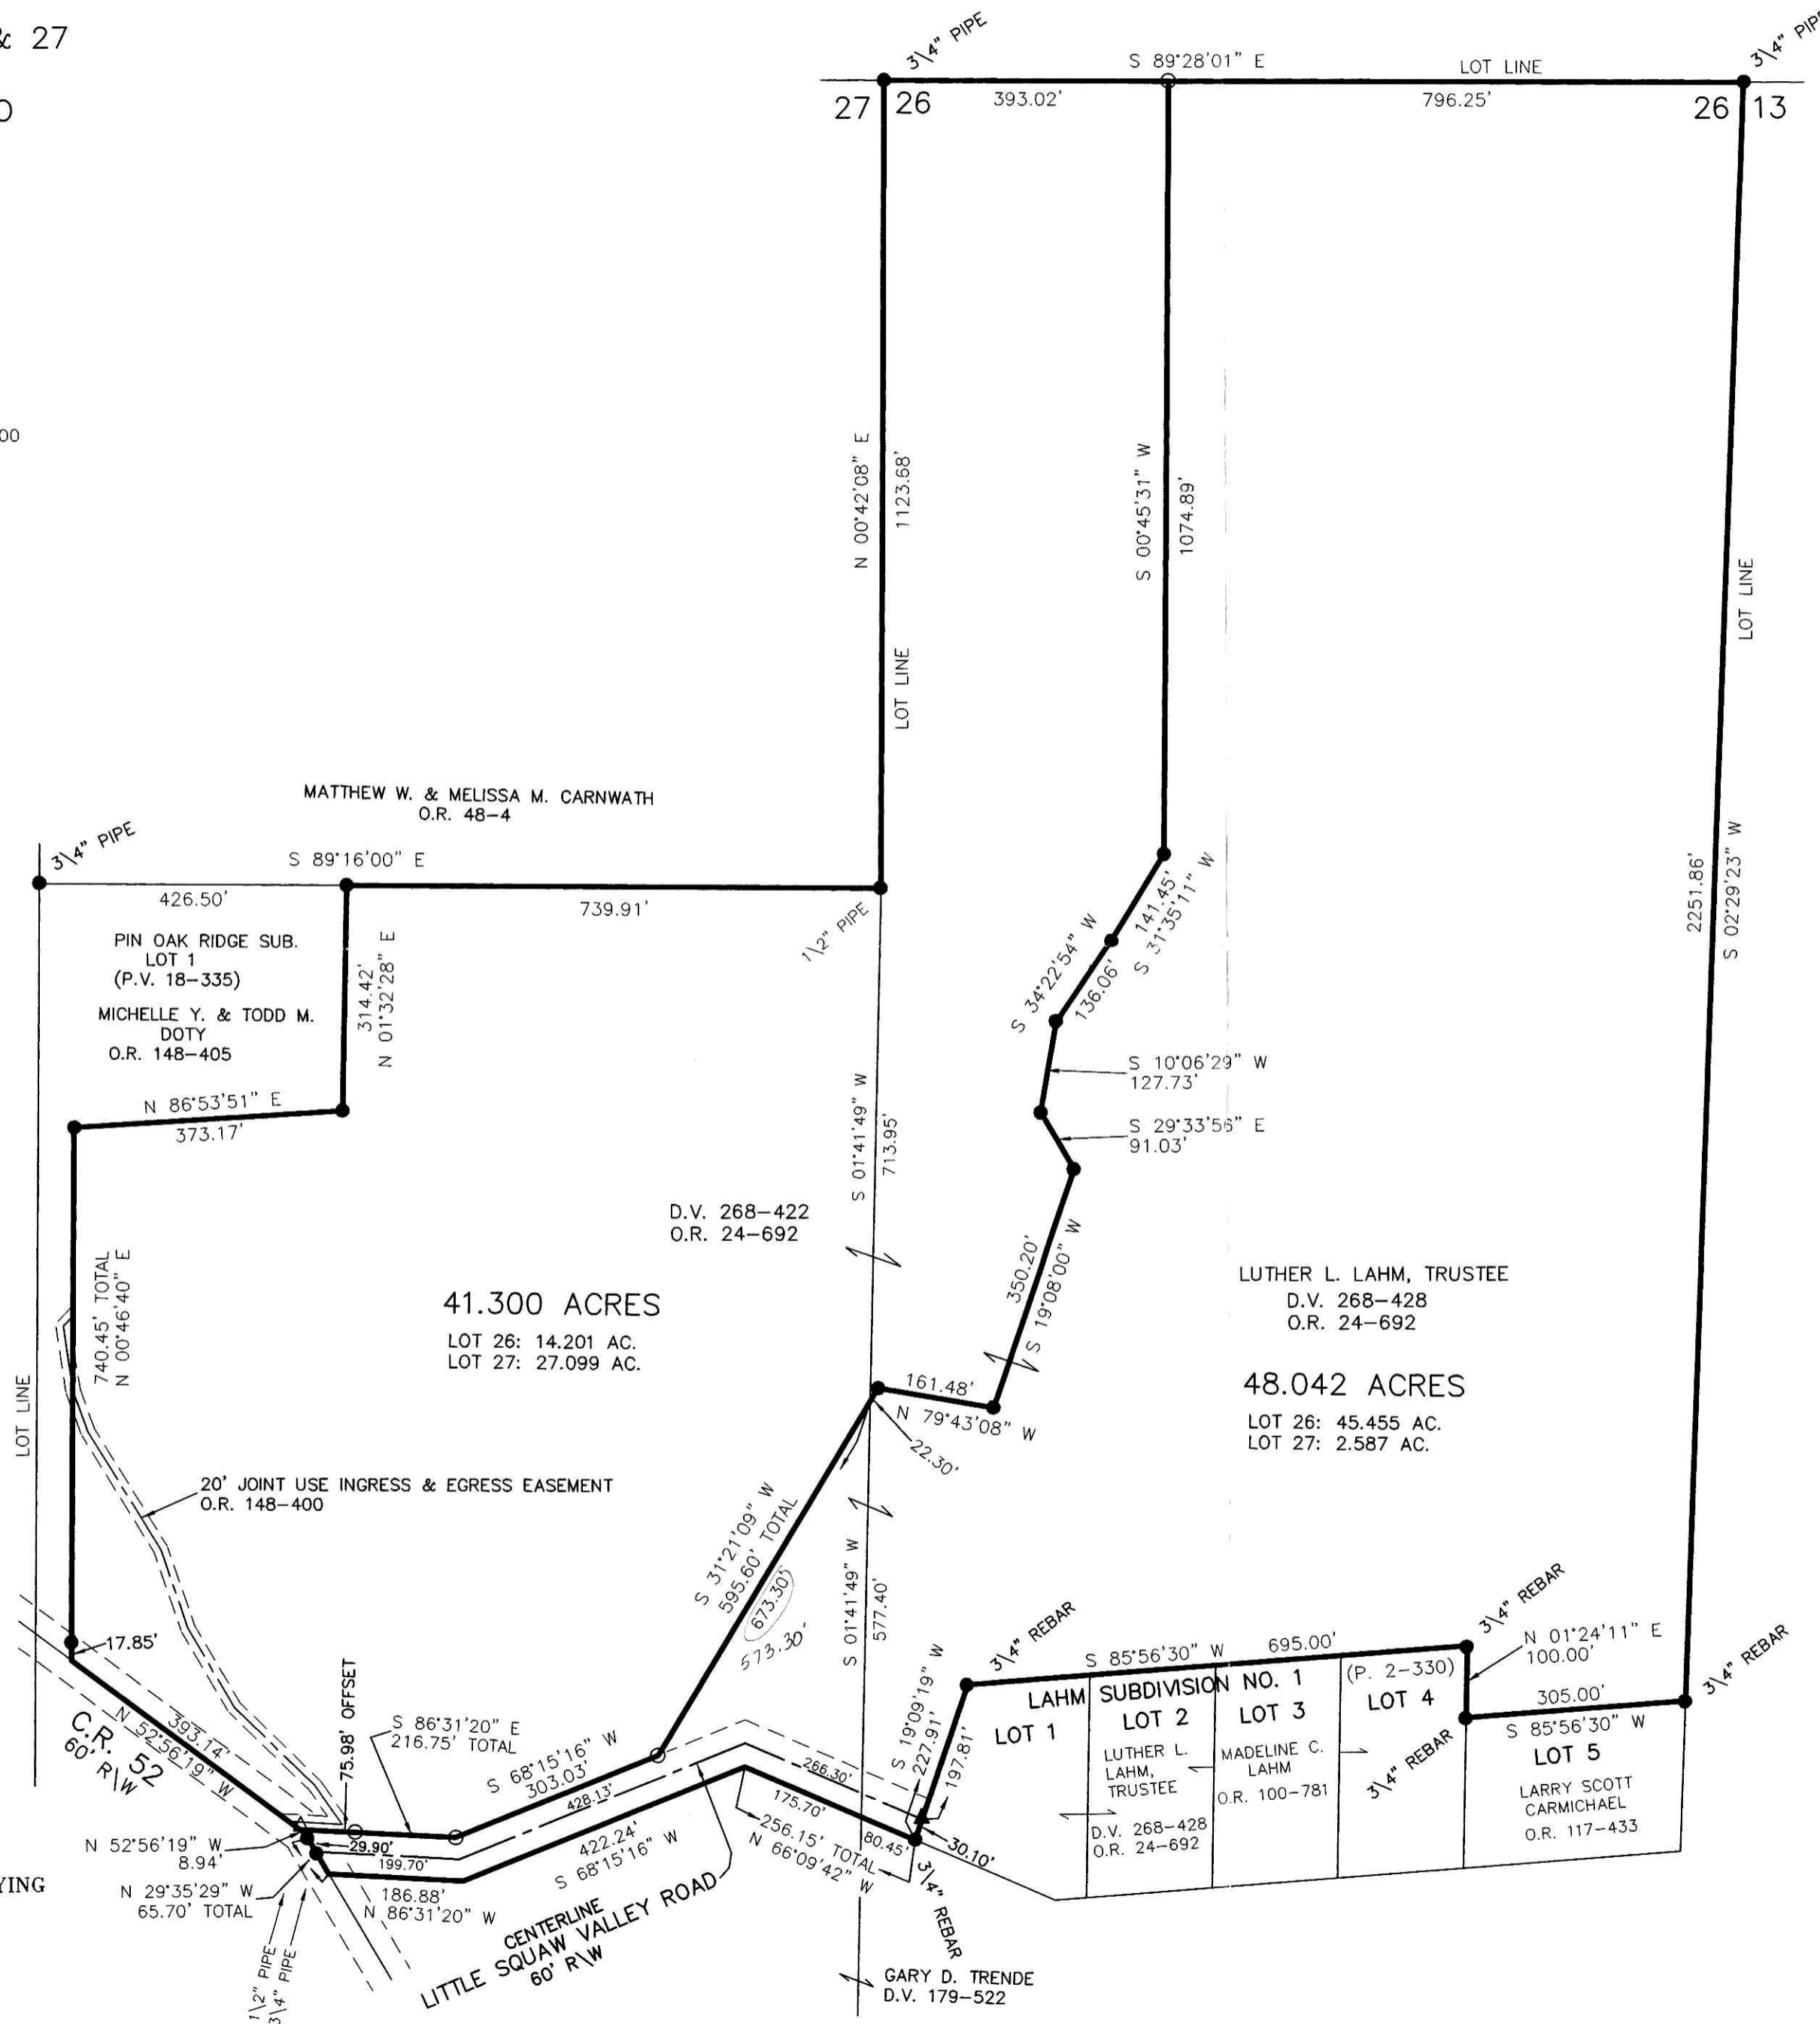

- ▲ R.R. SPIKE FOUND
- 5/8" REBAR FOUND
- △ R.R. SPIKE SET
- 5/8" REBAR WITH I.D. CAP SET, I.D. CAP MARKED "BAKER 6938"

200400033478  
 HEARLAND TITLE AGENCY  
 138 E JACKSON ST  
 MILLERSBURG, OH 44654



I CERTIFY THIS SURVEY TO BE CORRECT TO THE BEST OF MY KNOWLEDGE.

Donald C. Baker PS 6938

FDB/KES DATE: SEPT. 14, 2004  
 File Name: C:\JOBS\S-582-04

DONALD C. BAKER SURVEYING  
 138 N. CLAY ST.  
 MILLERSBURG, OH 44654  
 PH. 330-674-4788  
 FAX: 330-674-6027

PLAT APPROVED

10/14/2004