


MONROE TOWNSHIP
4TH. QTR. LOT 16
T-9 N; R-8 W
HOLMES COUNTY, OHIO

SURVEYED FOR: RICHARD LOXTERMAN

REFERENCES

DEED VOL. 250 PAGE 6
O.R. VOL. 174 PAGE 1349
O.R. VOL. 59 PAGE 100
PLAT VOL. 17 PAGE 640
BEARINGS FROM PLAT VOL 17 PAGE 640

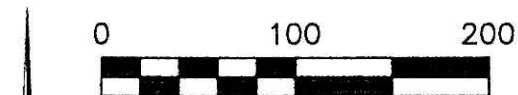


SCALE: 1"=100'

- STONE FOUND
- 5/8" REBAR FOUND UNLESS OTHERWISE NOTED
- ▲ R.R. SPIKE FOUND
- △ R.R. SPIKE SET
- 5/8" REBAR WITH I.D. CAP SET
- I.D. CAP MARKED "BAKER 6938"

200500035460
RICHARD M LOXTERMAN
SUSAN C LOXTERMAN
4842 BAILEY RD
MADISON, OH 44057

200500035460
Filed for Record in
HOLMES COUNTY, OH
SALLY MILLER
02-28-2005 At 03:09 pm.
SMALL PLAT 40.00
OR Book 19 Page 321 - 321
okv 178 pgs 1797 - 1801

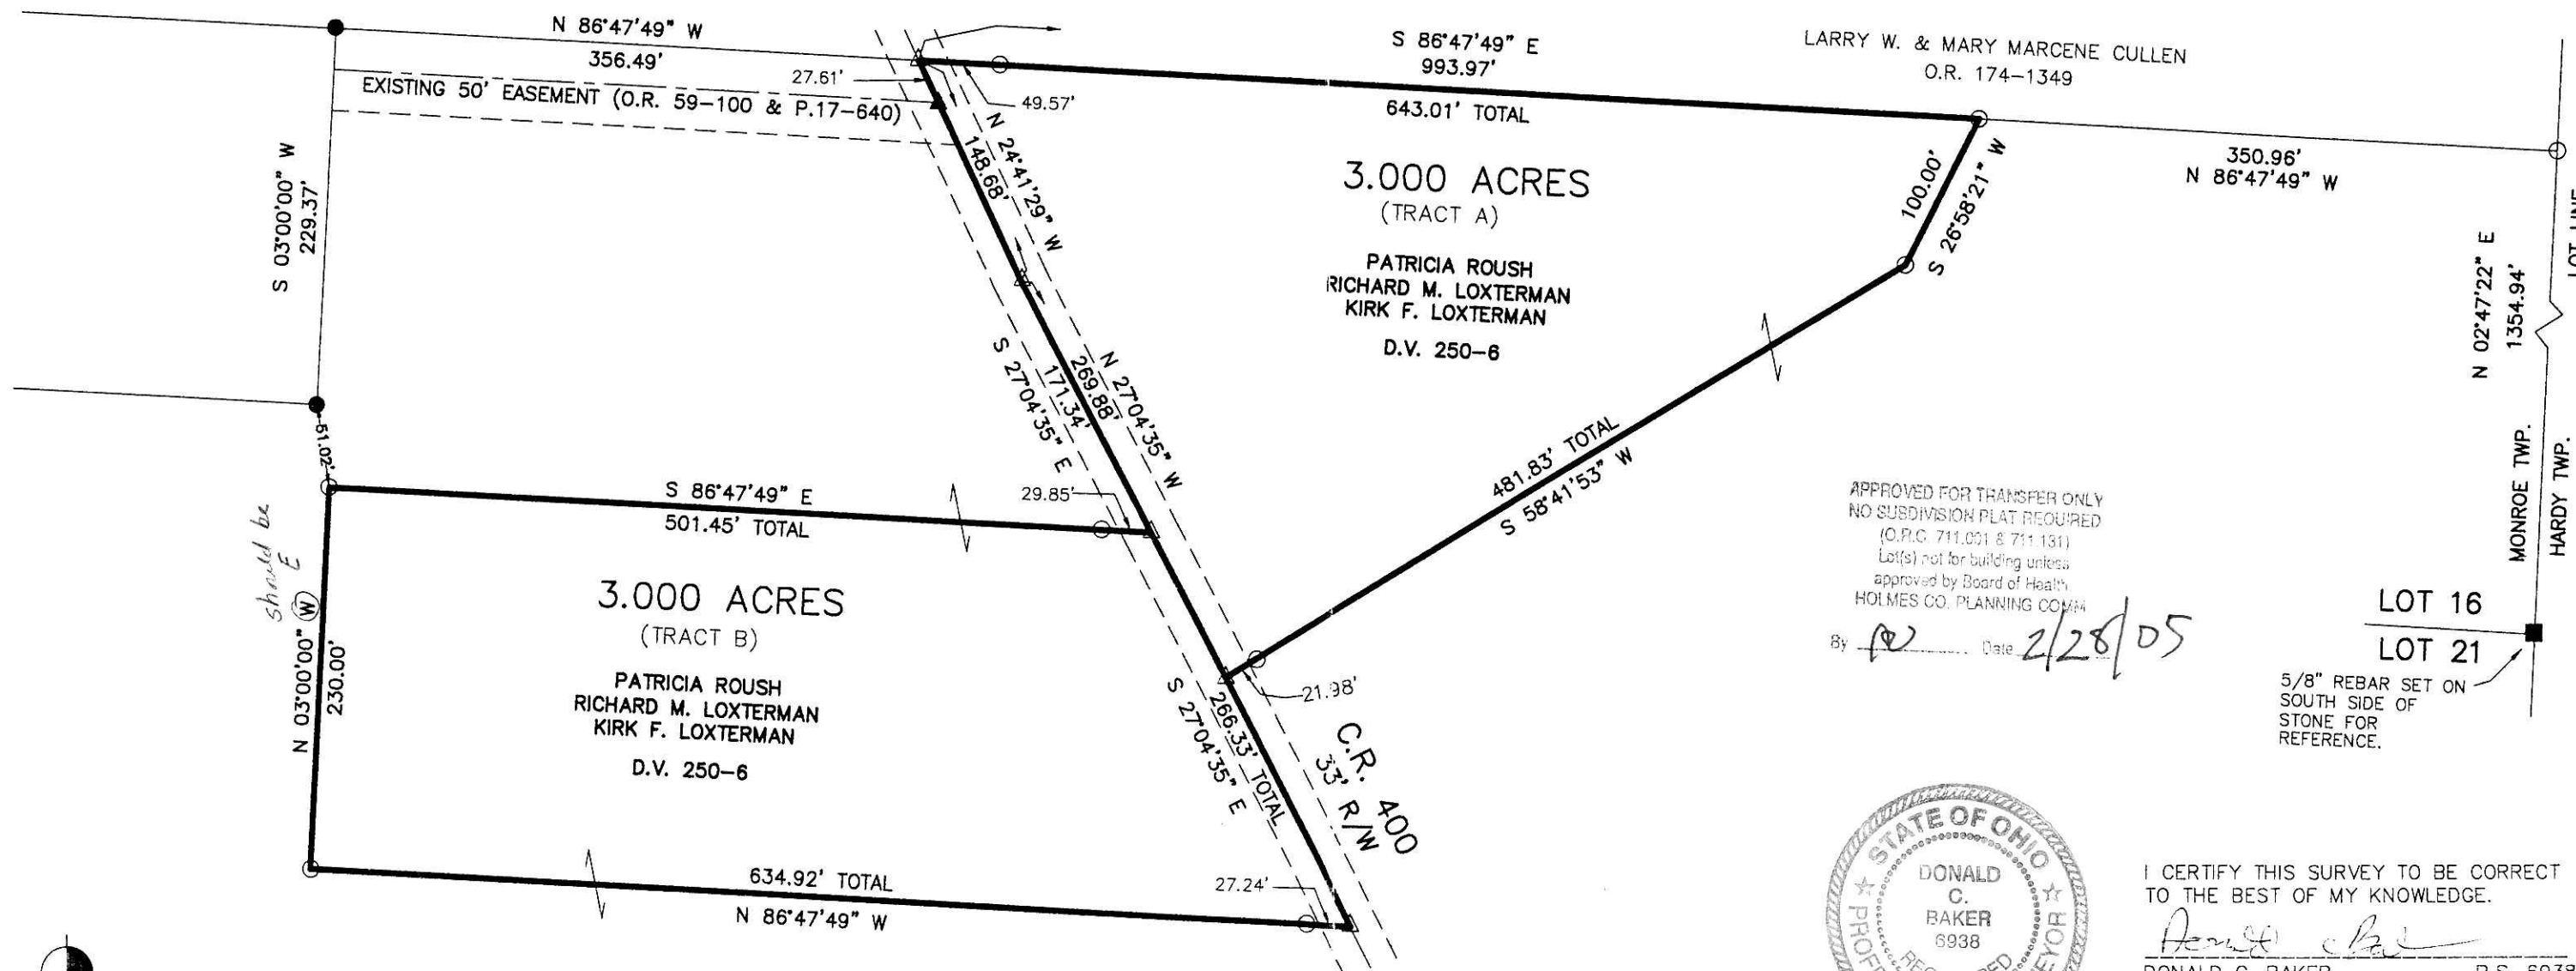

APPROVED FOR TRANSFER ONLY
NO SUBDIVISION PLAT REQUIRED
(O.P.C. 711.001 & 711.131)
Lot(s) not for building unless
approved by Board of Health
HOLMES CO. PLANNING COMM

By *[Signature]* Date *2/28/05*

5/8" REBAR SET ON
SOUTH SIDE OF
STONE FOR
REFERENCE.



I CERTIFY THIS SURVEY TO BE CORRECT
TO THE BEST OF MY KNOWLEDGE.


DONALD C. BAKER P.S. 6938

DATE: OCTOBER 8, 2004
REVISED: NOV. 11, 2004

FDB\AEG
File Name: WORK2\S-365-04\MLD

PLAT APPROVED

2/16/2005

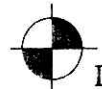

DONALD C. BAKER SURVEYING
138 N. CLAY ST.
MILLERSBURG, OHIO, 44654
PH. 330-674-4788
FAX. 330-674-6027