


200500037869
Filed for Record in
HOLMES COUNTY, OH
SALLY MILLER
07-15-2005 At 12:54 pm.
SMALL PLAT 40.00
OR Book 19 Page 454 - 454
ORV 181 page 2495

VILLAGE OF KILLBUCK
LOT 195
HOLMES COUNTY, OHIO
SURVEYED FOR: GRACE FELTON

- REFERENCES
- DEED VOL. 177 PAGES 165 & 169
 - DEED VOL. 257 PAGE 913
 - O.R. VOL. 29 PAGE 92
 - O.R. VOL. 59 PAGE 611
 - O.R. VOL. 60 PAGE 370
 - PLAT VOL. 2 PAGE 65
 - PLAT VOL. 17 PAGE 647
 - BEARINGS FROM PLAT VOL 17 PAGE 647

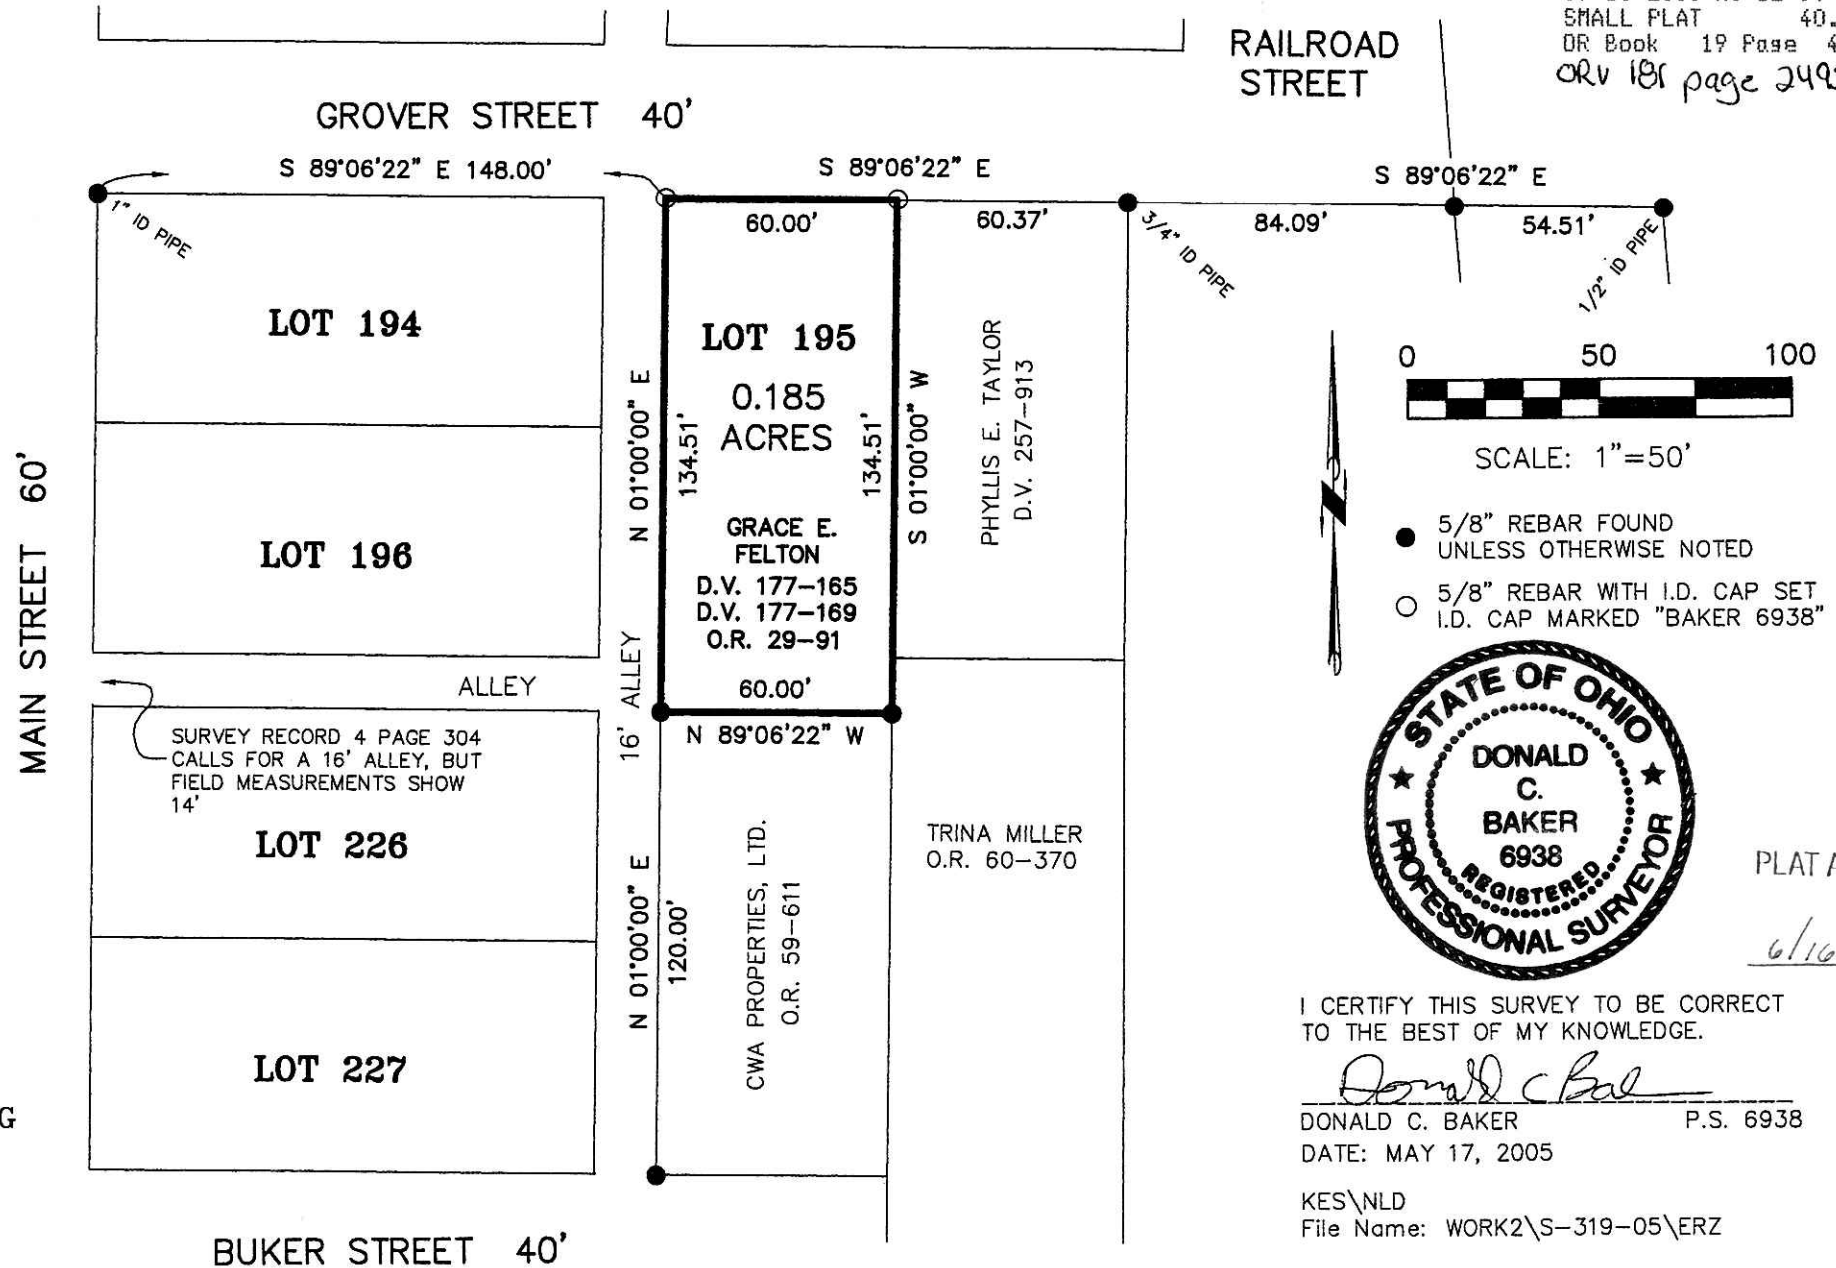

DONALD C. BAKER SURVEYING
138 N. CLAY ST.
MILLERSBURG, OHIO, 44654
PH. 330-674-4788
FAX. 330-674-6027

I CERTIFY THIS SURVEY TO BE CORRECT
TO THE BEST OF MY KNOWLEDGE.
Donald C Baker
DONALD C. BAKER P.S. 6938
DATE: MAY 17, 2005
KES\NLD
File Name: WORK2\S-319-05\ERZ