

200500038378
PAUL A
MILLER LAW
MILLERSBURG, OH

200500038378
Filed for Record in
HOLMES COUNTY, OH
SALLY MILLER
08-11-2005 At 02:27 pm.
SMALL PLAT 40.00
OR Book 19 Page 469 - 469
OR vol 182 page 1481

REFERENCES


DEED VOL. 176 PAGE 308
DEED VOL. 242 PAGE 145
DEED VOL. 274 PAGE 827
O.R. VOL. 48 PAGE 236
O.R. VOL. 168 PAGE 1206

PLAT VOL. 4 PAGE 185
PLAT VOL. 7 PAGE 298

BEARINGS FROM PLAT VOL 7 PAGE 298

WALNUT CREEK TOWNSHIP
N.W. QTR. SECTION 16
T-9 N; R-4 W
HOLMES COUNTY, OHIO

SURVEYED FOR: DAVE KAUFAMN REALTY

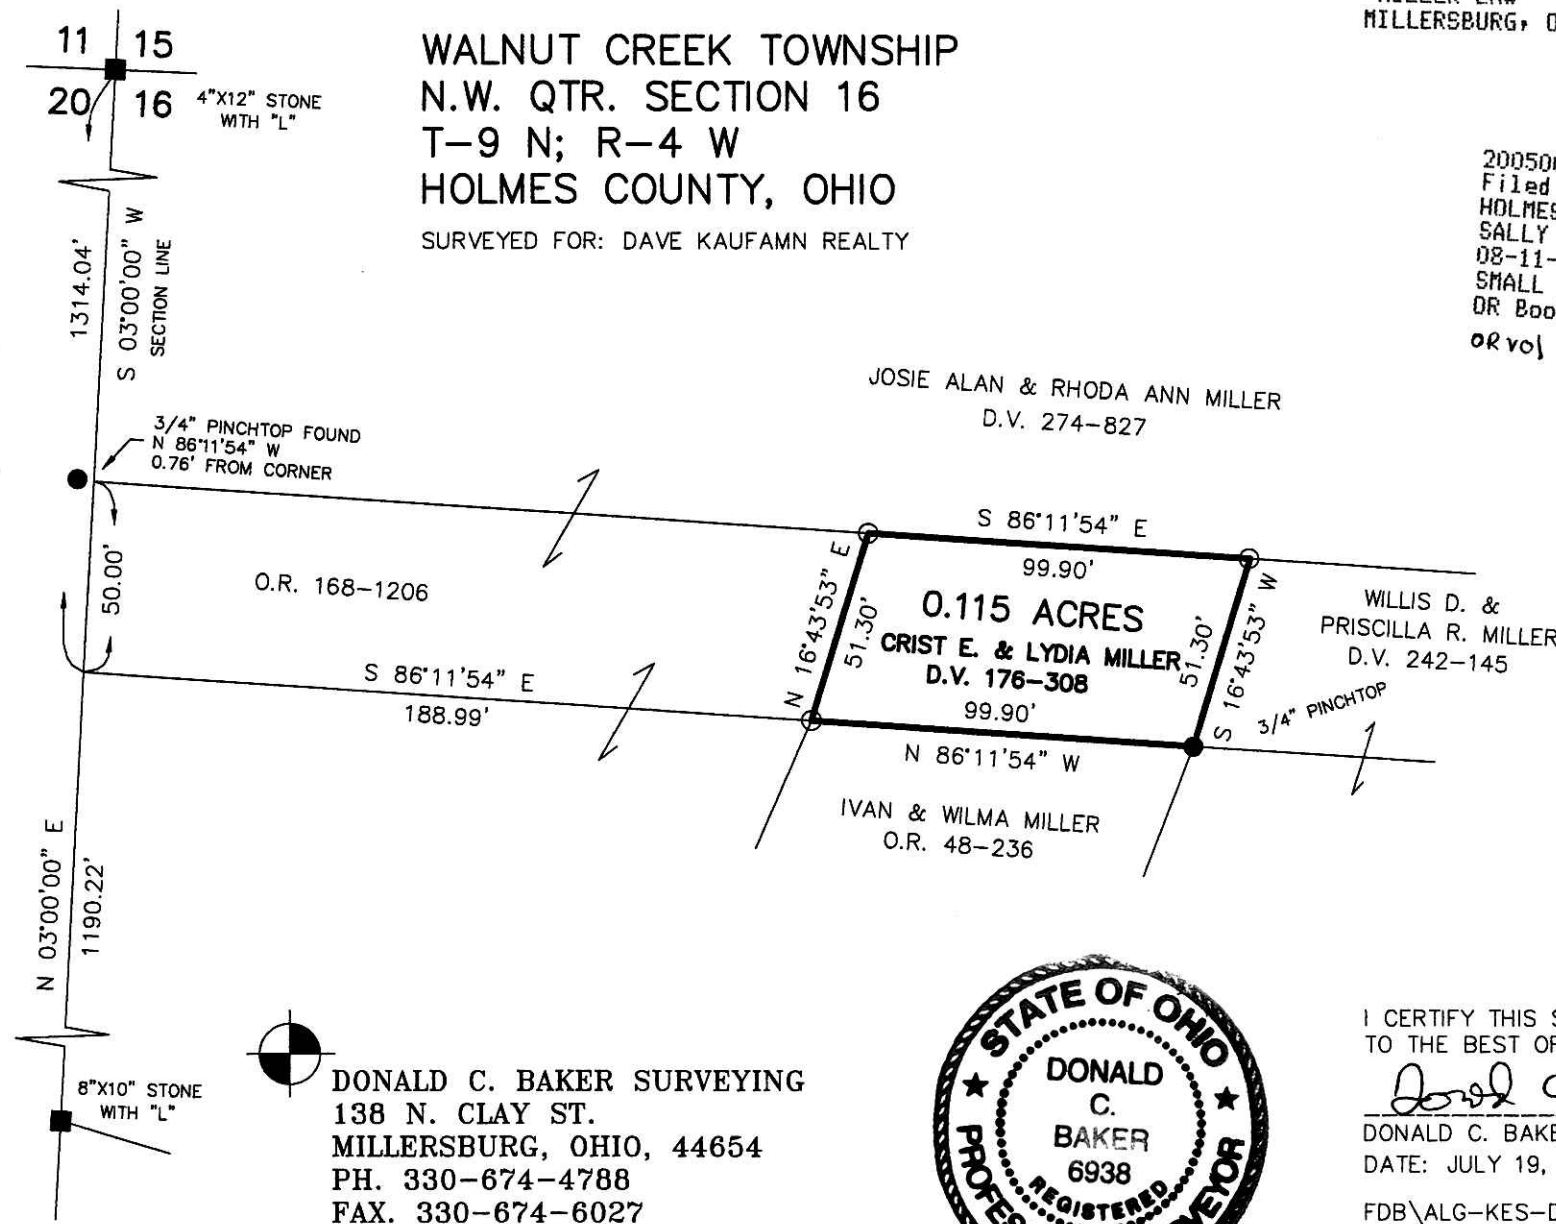


Instrument 200500038378 OR Book Page 19 469



SCALE: 1"=50'

- STONE FOUND
- 5/8" REBAR FOUND UNLESS OTHERWISE NOTED
- 5/8" REBAR WITH I.D. CAP SET I.D. CAP MARKED "BAKER 6938"

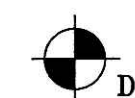

DONALD C. BAKER SURVEYING
138 N. CLAY ST.
MILLERSBURG, OHIO, 44654
PH. 330-674-4788
FAX. 330-674-6027



PLAT APPROVED

8/9/2005 B

I CERTIFY THIS SURVEY TO BE CORRECT TO THE BEST OF MY KNOWLEDGE.

Donald C. Baker

DONALD C. BAKER P.S. 6938
DATE: JULY 19, 2005

FDB\ALG-KES-DB
File Name: WORK2\S-437-05\ERZ