

HARDY TOWNSHIP
3RD. QTR., LOT 25
T-9 N; R-7 W
HOLMES COUNTY, OHIO

SURVEYED FOR: CONRAD MILLER


200600043294
FRENCH RIDGE TITLE
MILLERSBURG, OH 44654


200600043294
Filed for Record in
HOLMES COUNTY, OH
SALLY MILLER
05-04-2006 At 12:26 pm.
SMALL FLAT 40.00
DR Book 19 Page 695 - 695
ORV 188 page 2045

- STONE FOUND
- 5/8" REBAR FOUND UNLESS OTHERWISE NOTED
- 5/8" REBAR WITH I.D. CAP SET I.D. CAP MARKED "BAKER 6938"


REFERENCES

- O.R. VOL. 182 PAGE 3196
- O.R. VOL. 185 PAGE 2608
- O.R. VOL. 145 PAGE 226
- O.R. VOL. 123 PAGE 395
- PLAT VOL. 17 PAGE 87
- PLAT VOL. 13 PAGE 10
- PLAT VOL. 18 PAGE 395
- PLAT VOL. 16 PAGE 563
- BEARINGS FROM
- O.R. VOL. 182 PAGE 3196

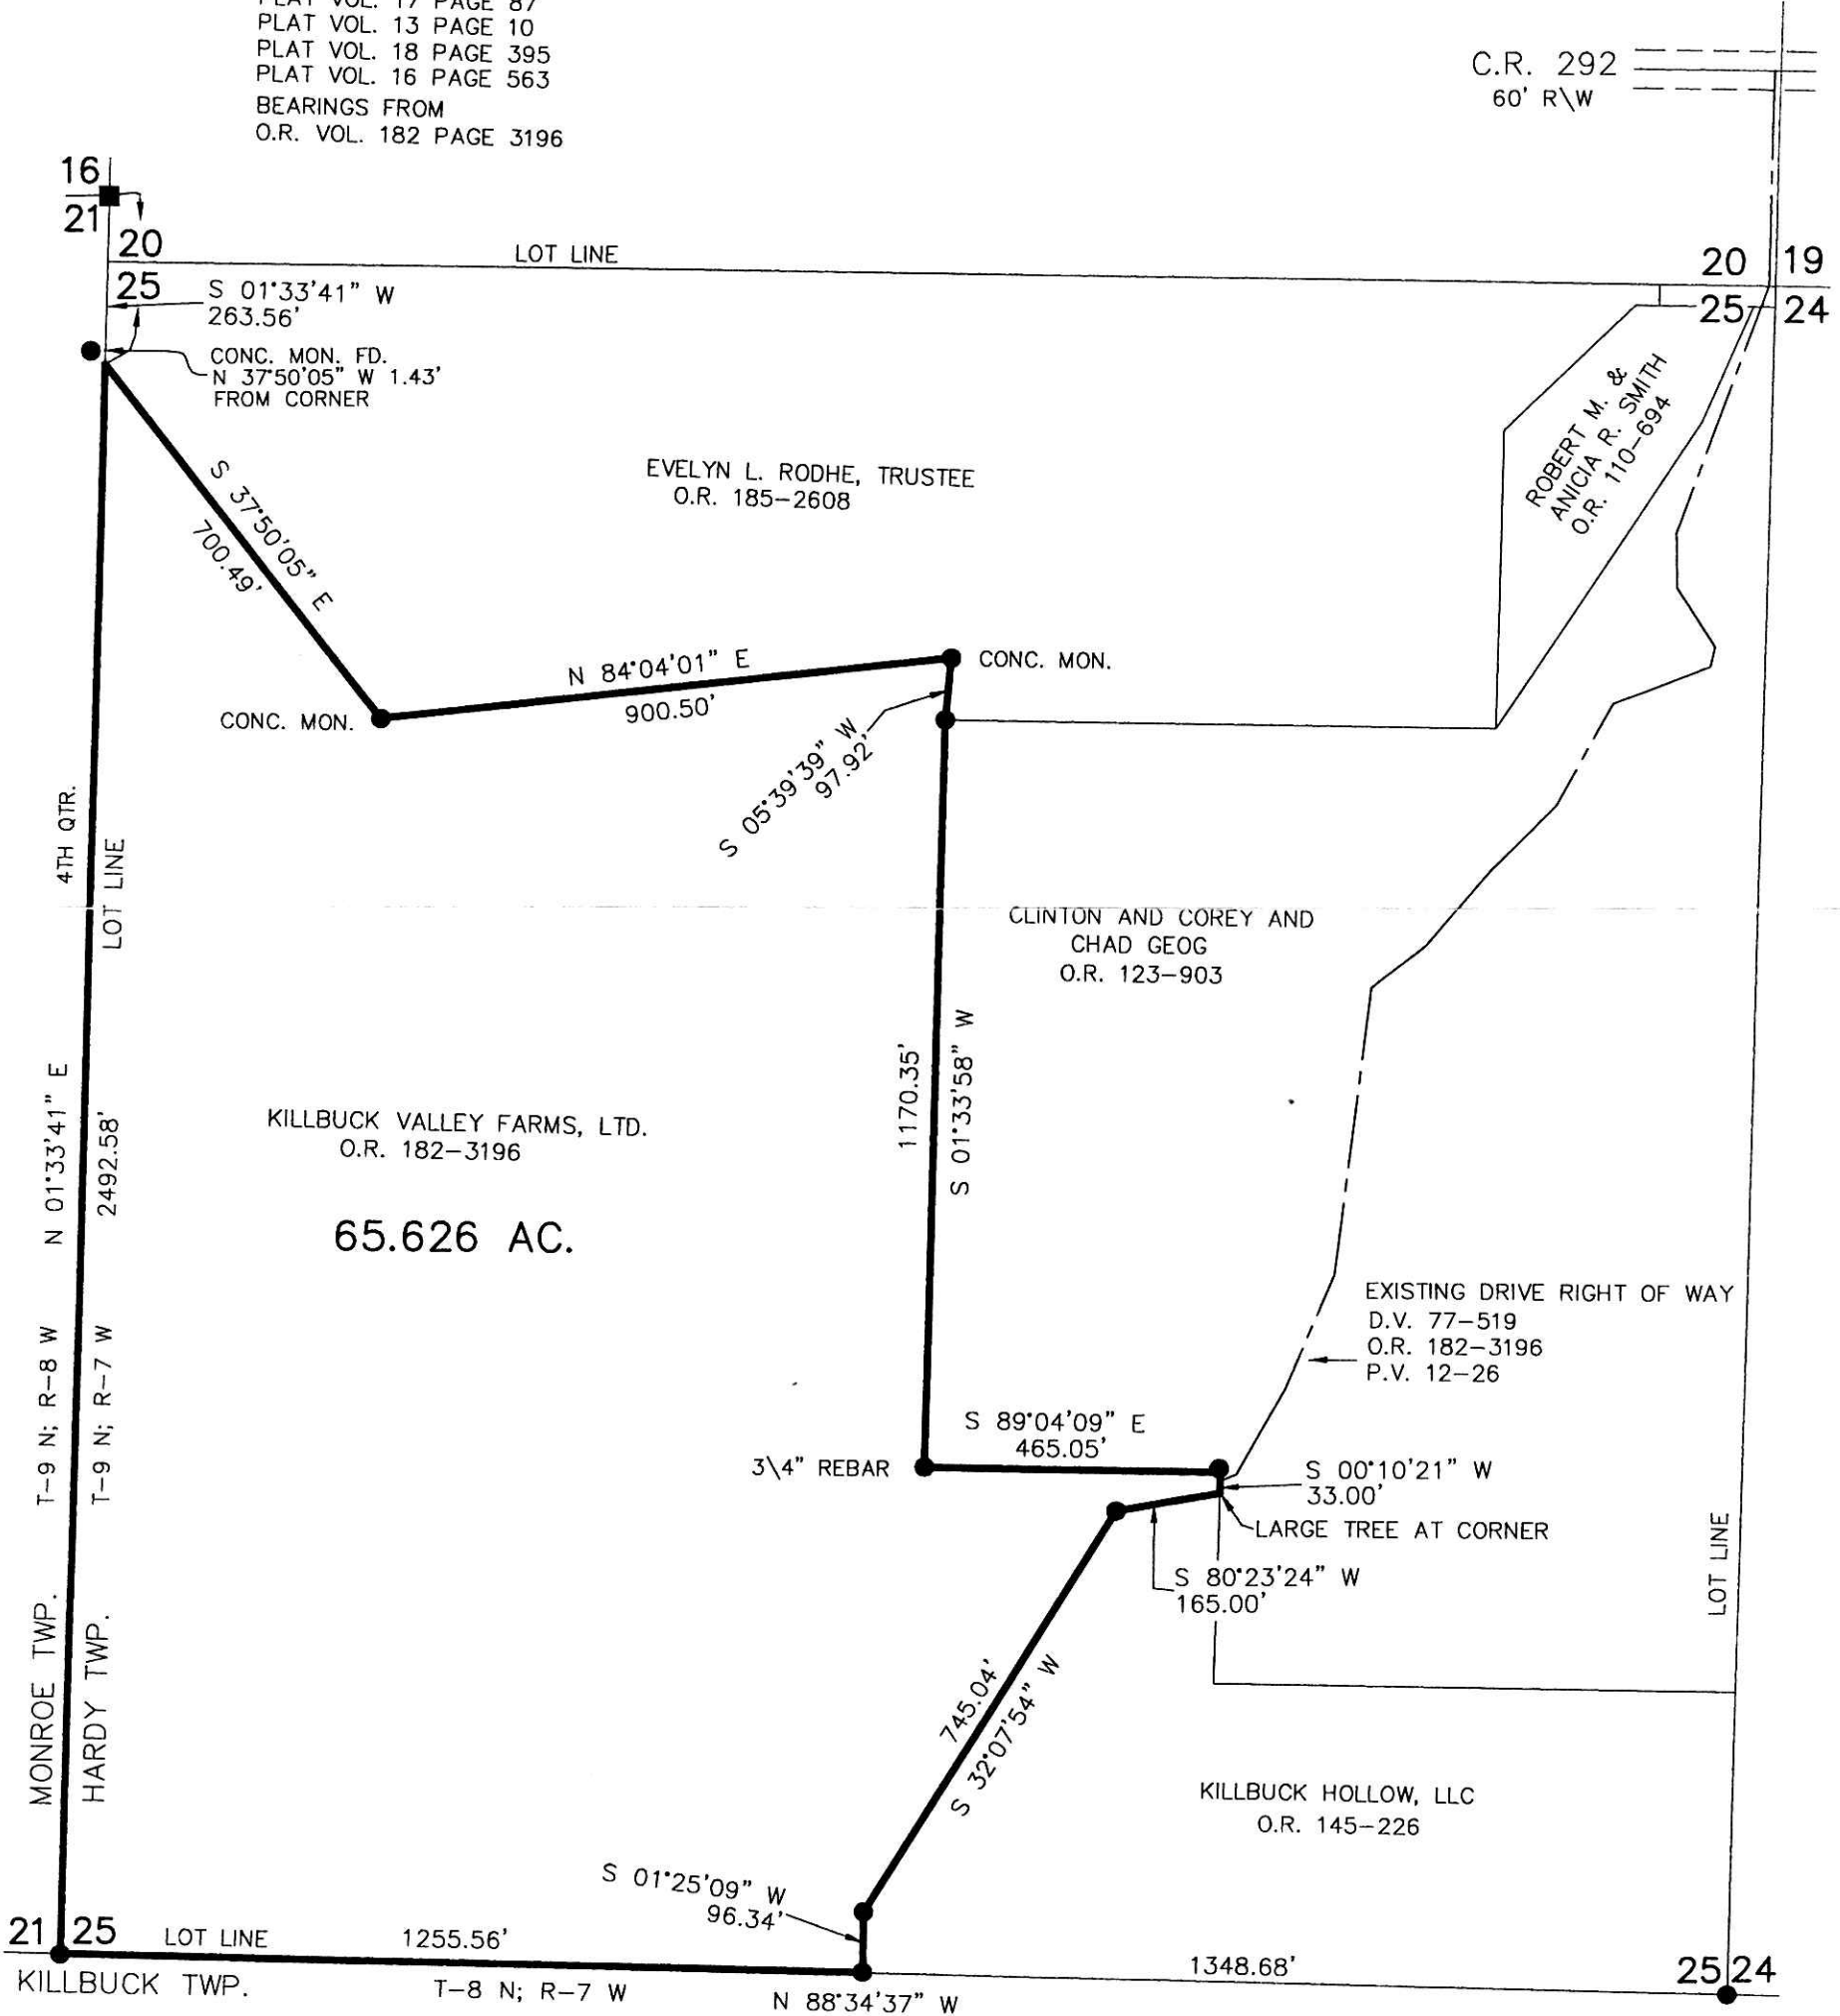

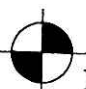
DONALD C. BAKER SURVEYING
 138 N. CLAY ST.
 MILLERSBURG, OHIO, 44654
 PH. 330-674-4788
 FAX. 330-674-6027

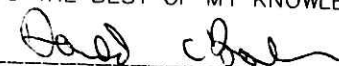

I CERTIFY THIS SURVEY TO BE CORRECT
 TO THE BEST OF MY KNOWLEDGE.

 DONALD C. BAKER P.S. 6938
 DATE: FEB. 21, 2006
 FDB\ERZ
 File Name: WORK2\S-665-05

PLAT APPROVED
 5/1/2006