

MECHANIC TOWNSHIP
 N.W. QTR. SECTION 21
 T-8 N; R-7 W
 HOLMES COUNTY, OHIO

SURVEYED FOR: JIM CROSKEY


Instrument Book Page
 200600043511 OR 19 708

200600043511
 Filed for Record in
 HOLMES COUNTY, OH
 SALLY MILLER
 05-16-2006 At 10:02 am.
 SMALL PLAT 40.00
 OR Book 19 Page 708 - 708
 ORV 188 page 2975

REFERENCES:

- DEED VOL. 168 PAGE 284
- DEED VOL. 158 PAGE 6
- DEED VOL. 272 PAGE 125
- O.R. VOL. 40 PAGE 656
- O.R. VOL. 169 PAGE 1789
- O.R. VOL. 178 PAGE 631
- PLAT VOL. 4 PAGE 81
- PLAT VOL. 13 PAGE 81


200600043511
 MILLER MAST
 & MASON ATTYS
 MILLERSBURG, OH

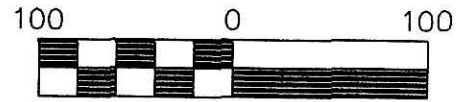

Scale 1" = 100'

- 5/8" REBAR FOUND UNLESS OTHERWISE NOTED
- P.K. NAIL SET
- 5/8" REBAR WITH I.D. CAP SET I.D. CAP MARKED "BAKER 6938"

BEARINGS FROM PLAT VOL. 13 PAGE 81

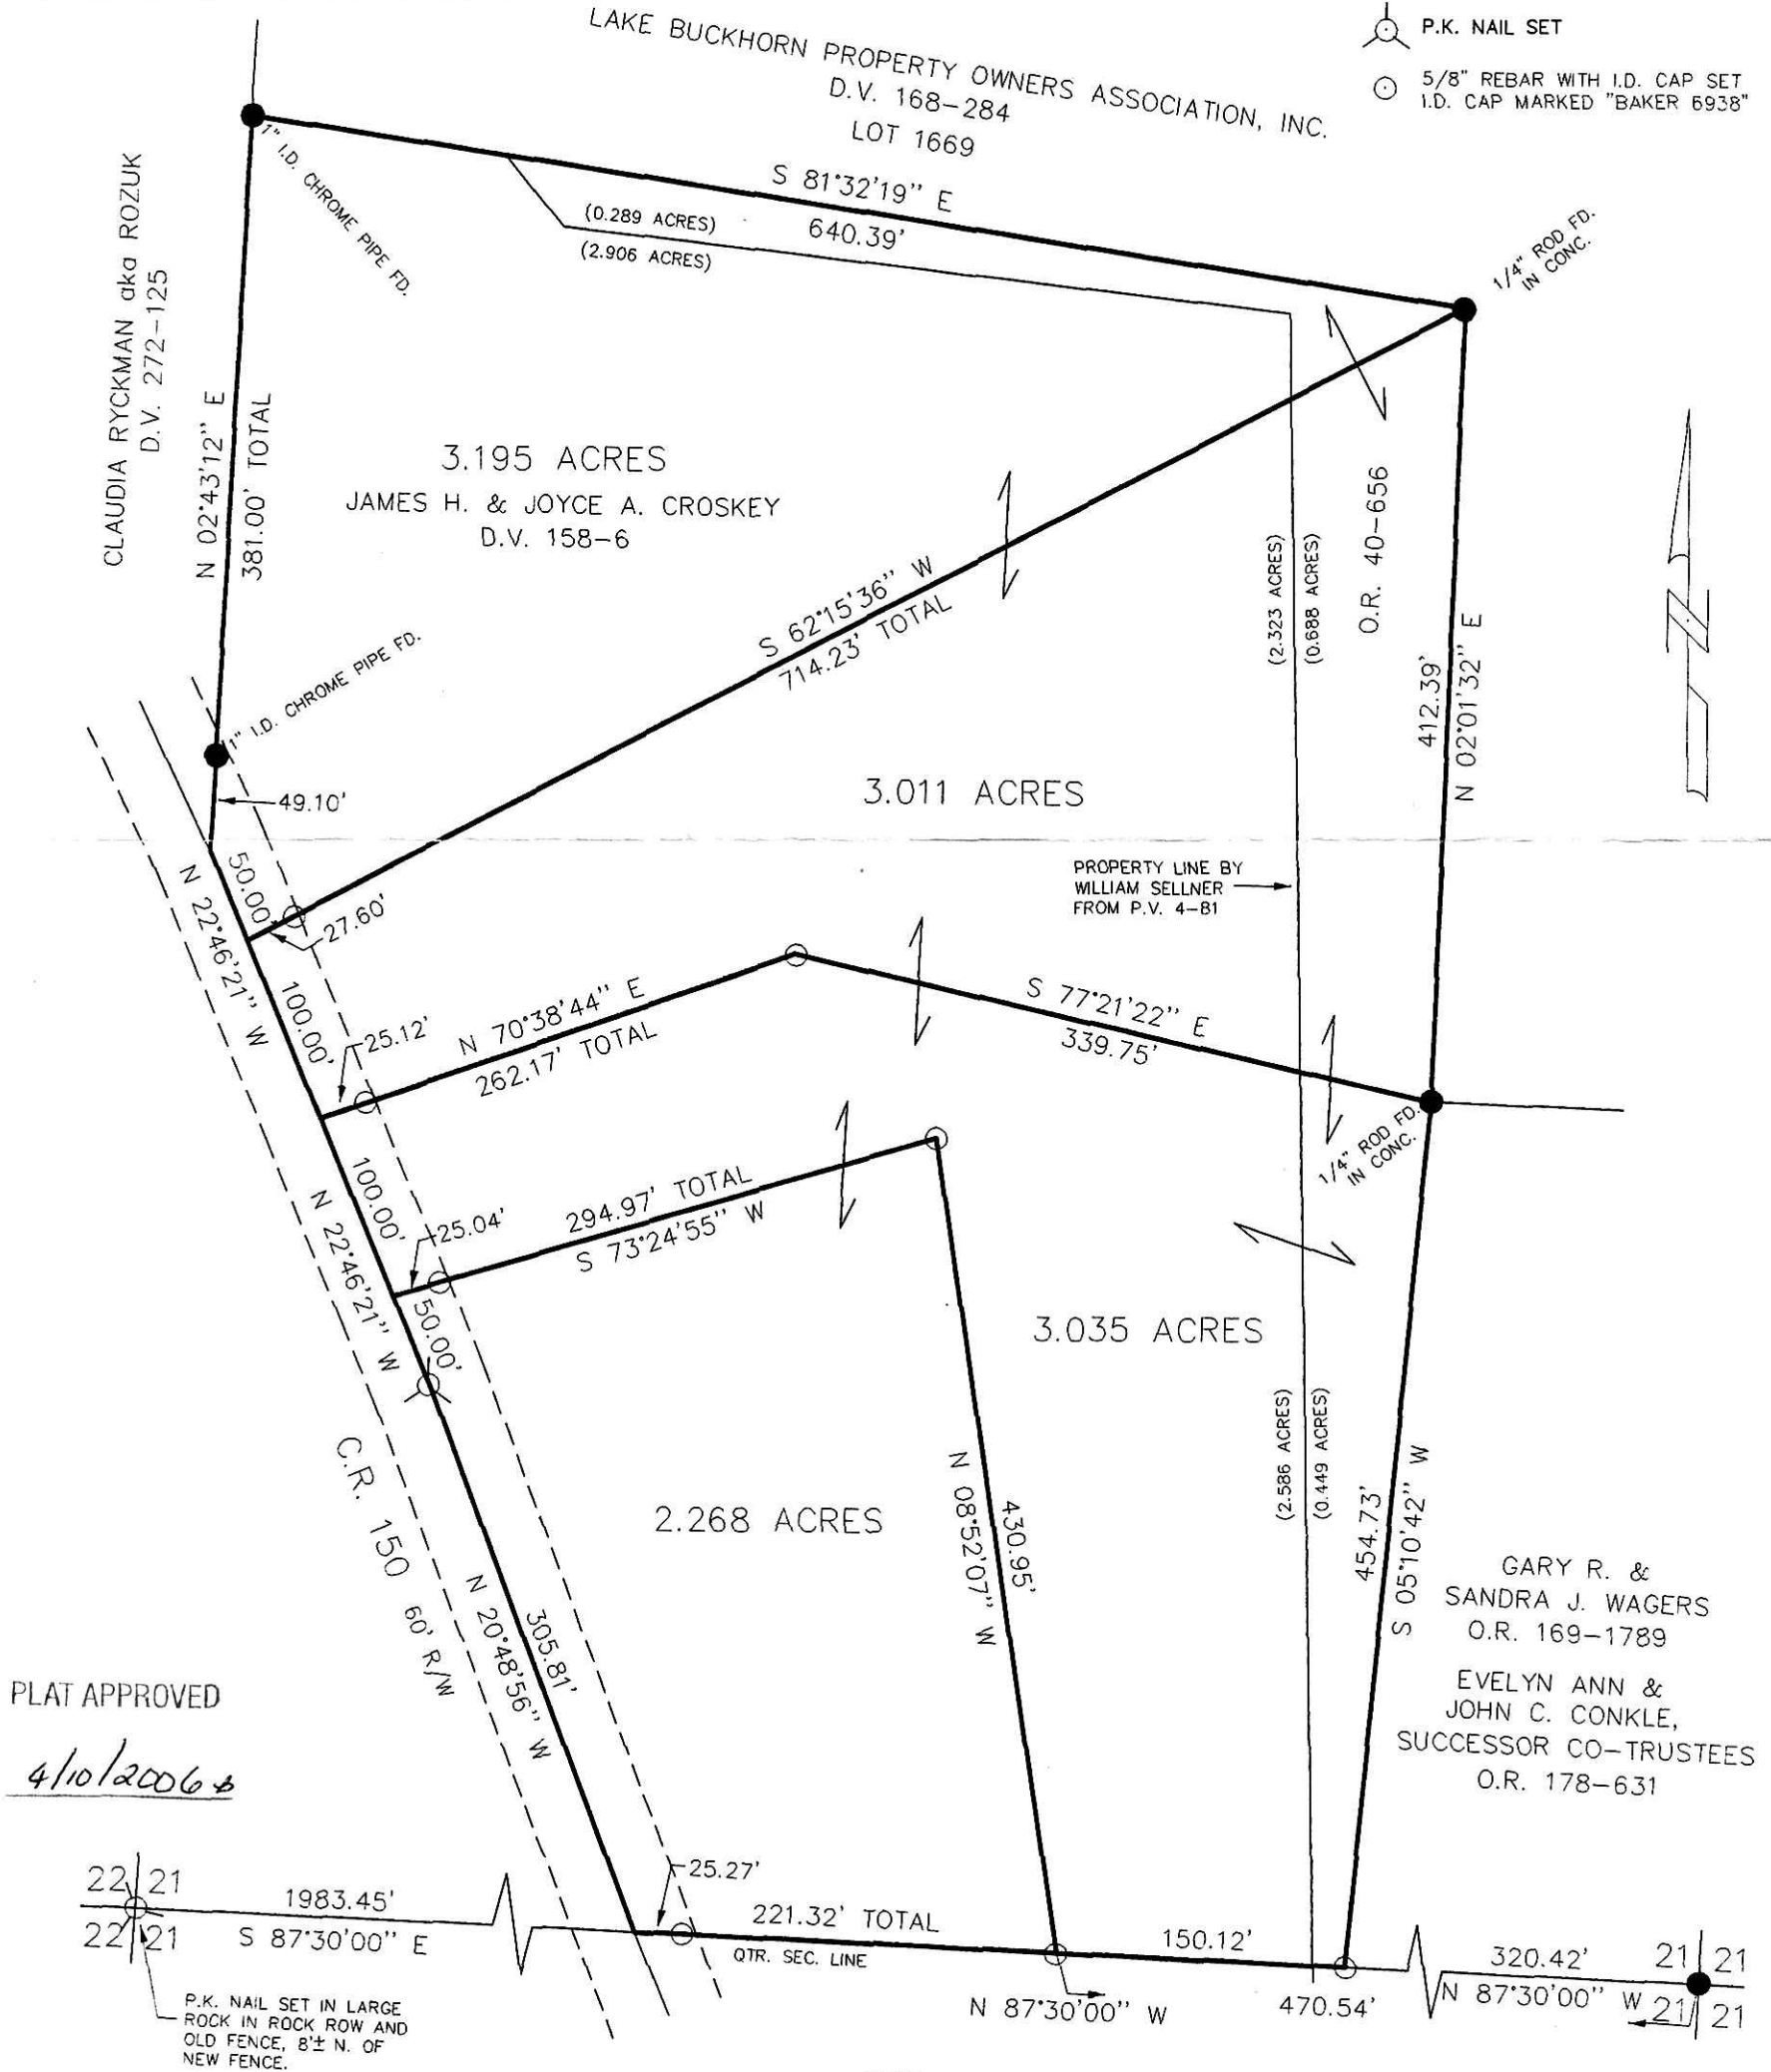

PLAT APPROVED
 4/10/2006

DONALD C. BAKER SURVEYING
 138 N. CLAY ST.
 MILLERSBURG, OHIO 44654
 PH. 330-674-4788
 FAX 330-674-6027



I CERTIFY THIS SURVEY TO BE CORRECT TO THE BEST OF MY KNOWLEDGE
 JAMIE D. DARR P.S. 7755
 DATE: DEC. 18, 2002
 REVISED: MARCH 30, 2006
 JDD/ FCC
 File name: WORK3\S-817-02\ERZ