

WALNUT CREEK TOWNSHIP  
 3RD. QTR., LOT 6  
 T-9 N; R-5 W  
 HOLMES COUNTY, OHIO

SURVEYED FOR: MARK COBLENTZ


REFERENCES

DEED VOL. 253 PAGE 591  
 O.R. VOL. 110 PAGES 452 & 454  
 O.R. VOL. 168 PAGE 548  
 O.R. VOL. 185 PAGES 2844 & 2848  
 PLAT VOL. 17 PAGE 576  
 PLAT VOL. 18 PAGE 263  
 BEARINGS FROM PLAT VOL 18 PAGE 263

Instrument Book Page  
 200600044865 DR 19 770


200600044865  
 Filed for Record in  
 HOLMES COUNTY, OH  
 SALLY MILLER  
 07-26-2006 At 09:40 am.  
 SMALL PLAT 40.00  
 DR Book 19 Page 770 - 770  
 ORV 190 page 2056

200600044865  
 CRITCHFIELD...  
 & JOHNSTON ATTYS  
 MILLERSBURG, OH

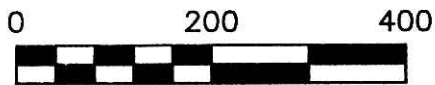

SCALE: 1"=200'

- 5/8" REBAR FOUND UNLESS OTHERWISE NOTED
- 5/8" REBAR WITH I.D. CAP SET I.D. CAP MARKED "BAKER 6938"

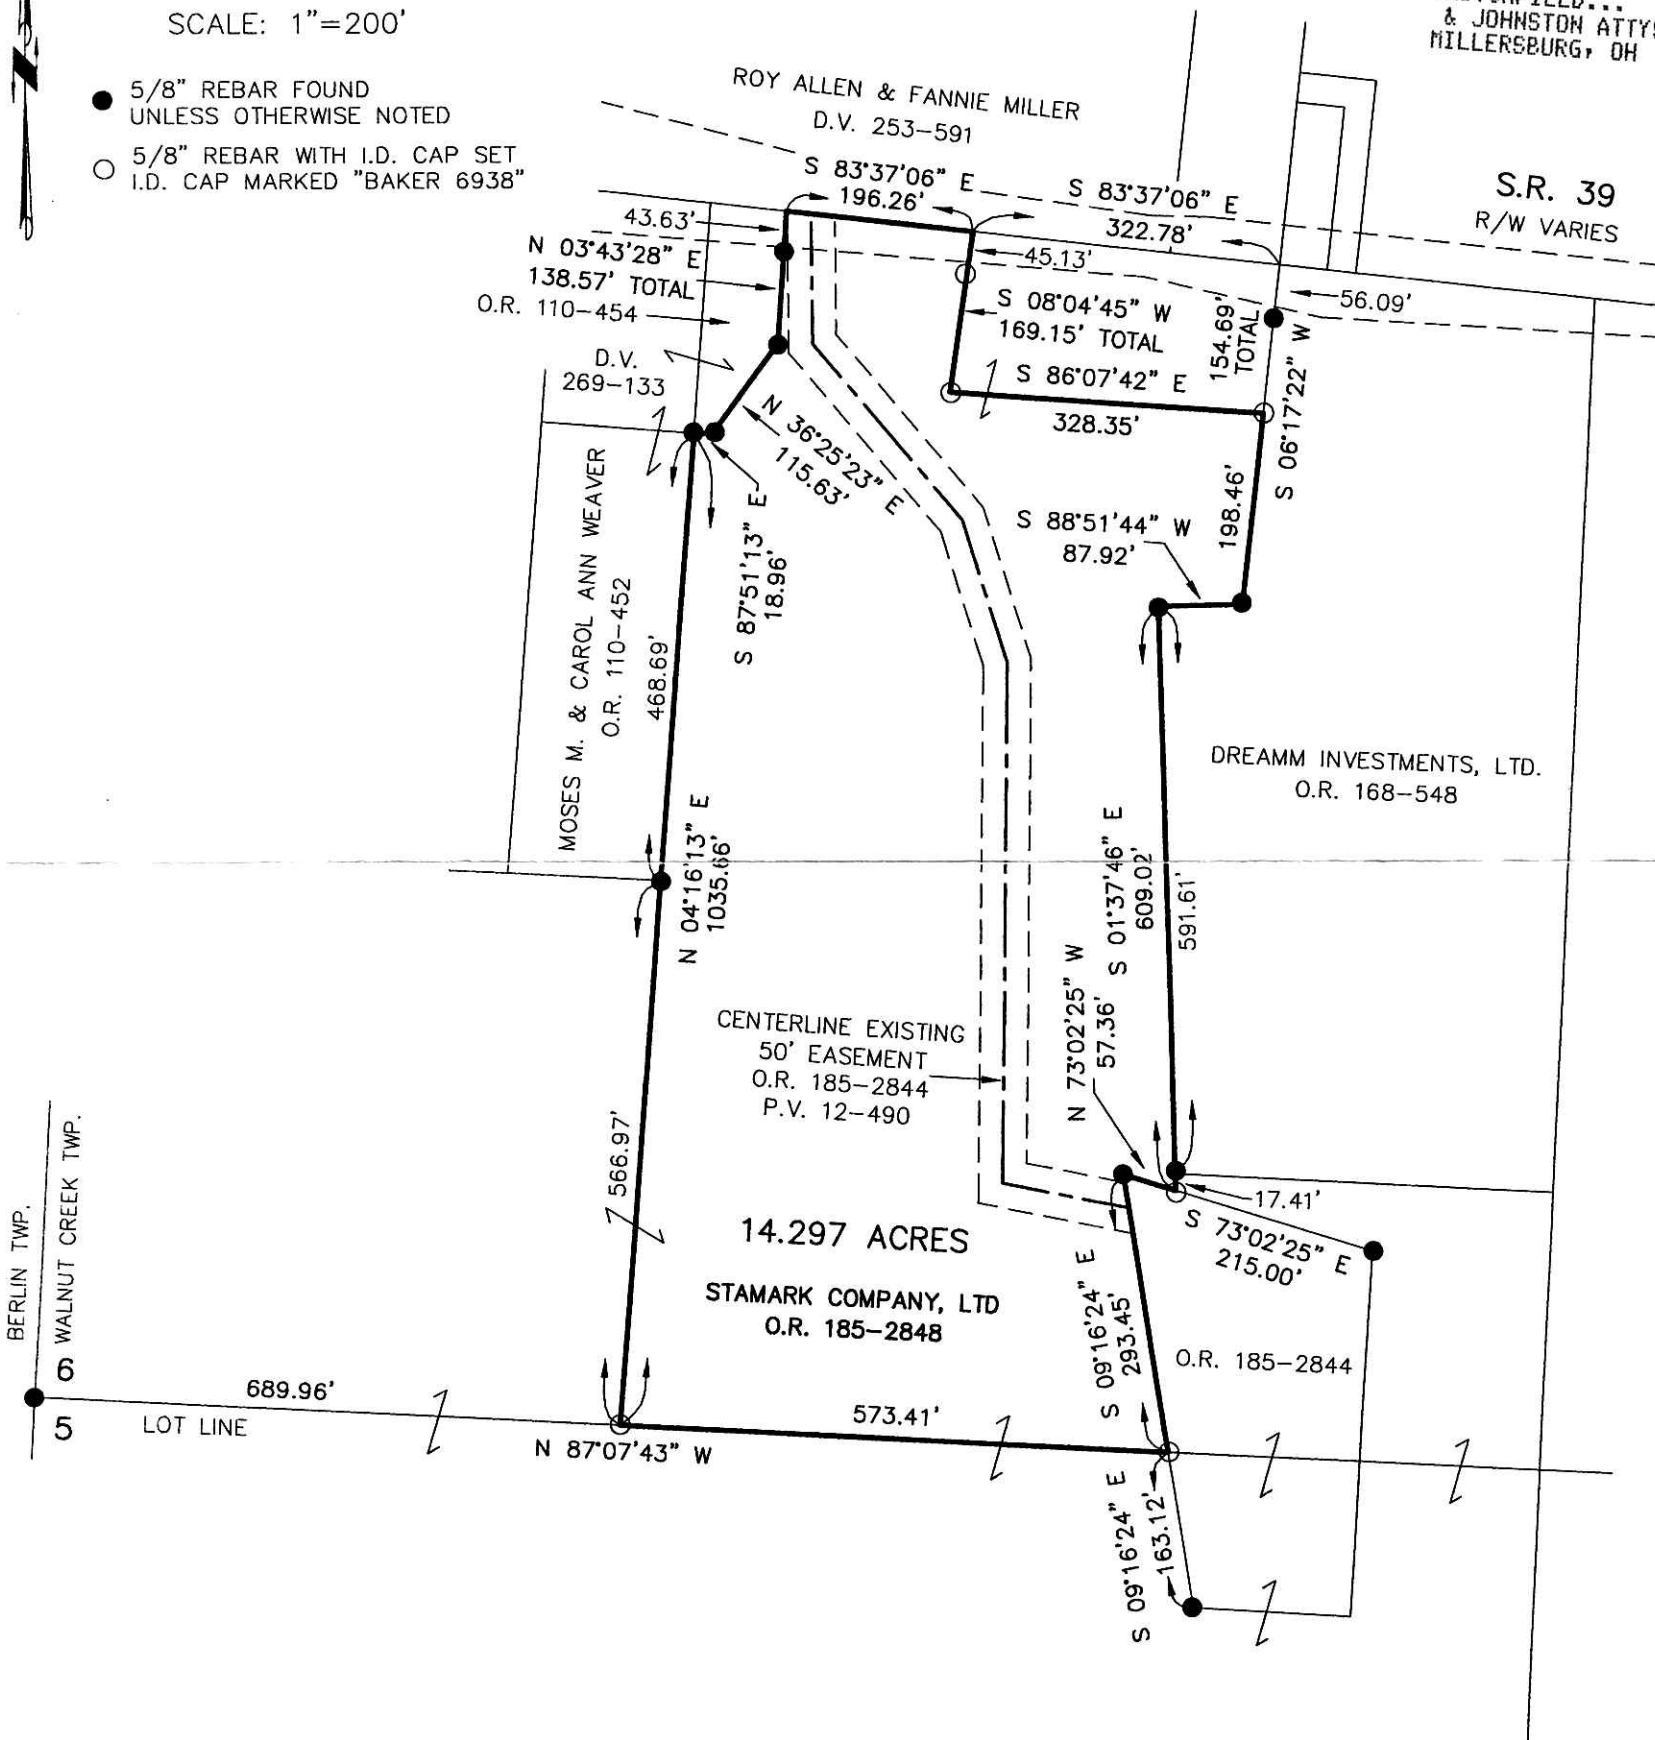

I CERTIFY THIS SURVEY TO BE CORRECT TO THE BEST OF MY KNOWLEDGE.


*Donald C. Baker*  
 DONALD C. BAKER P.S. 6938

DATE: JUNE 27, 2006

FDB\MB  
 File Name: WORK2\S-444-06\ERZ

PLAT APPROVED

*7/18/2006*

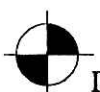

DONALD C. BAKER SURVEYING  
 138 N. CLAY ST.  
 MILLERSBURG, OHIO, 44654  
 PH. 330-674-4788  
 FAX. 330-674-6027