

200600046911  
MILLER, MAST & MASON  
MILLERSBURG OH


# RETRACEMENT SURVEY OF D.V. 280-107

Instrument Book Page  
200600046911 OR 19 868

CLARK TOWNSHIP  
N.W. QTR. SECTION 11  
N.E. QTR. SECTION 12  
T-8 N; R-5 W  
HOLMES COUNTY, OHIO

200600046911  
Filed for Record in  
HOLMES COUNTY, OH  
SALLY MILLER  
11-20-2006 At 10:05 am.  
SMALL PLAT 40.00  
OR Book 19 Page 868 - 868  
okv 193 page 569

SURVEYED FOR: JACOB A. YODER

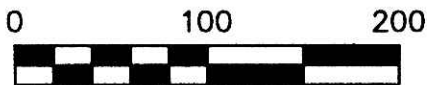


SCALE: 1"=100'

- 5/8" REBAR FOUND UNLESS OTHERWISE NOTED
- ▲ R.R. SPIKE FOUND
- 5/8" REBAR WITH I.D. CAP SET I.D. CAP MARKED "BAKER 6938"

### REFERENCES

- DEED VOL. 280 PAGE 107
- DEED VOL. 231 PAGE 300
- DEED VOL. 149 PAGE 591
- DEED VOL. 156 PAGE 371
- O.R. VOL. 167 PAGE 1284
- PLAT VOL. 18 PAGE 437
- BEARINGS FROM PLAT VOL 18 PAGE 437

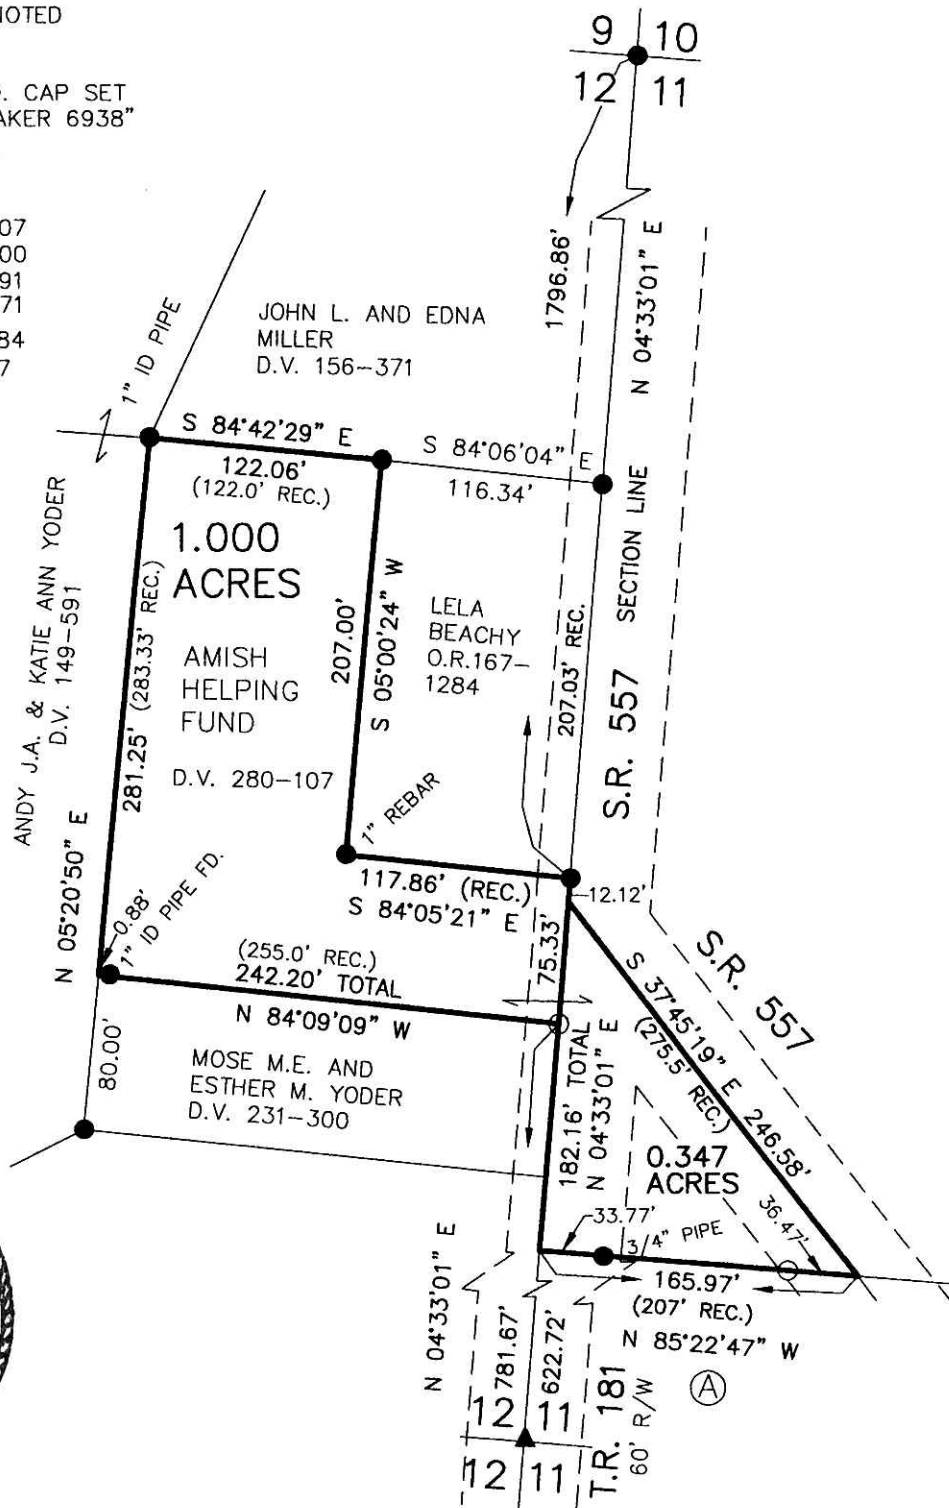

I CERTIFY THIS SURVEY TO BE CORRECT TO THE BEST OF MY KNOWLEDGE.

*Donald C. Baker*  
DONALD C. BAKER P.S. 6938  
DATE: NOVEMBER 7, 2006



DONALD C. BAKER SURVEYING  
138 N. CLAY ST.  
MILLERSBURG, OHIO, 44654  
PH. 330-674-4788  
FAX. 330-674-6027

PLAT APPROVED

11/15/2006