

200700050007  
 Filed for Record in  
 HOLMES COUNTY, OH  
 SALLY MILLER  
 05-15-2007 At 01:57 PM.  
 SMALL PLAT 40.00  
 OR Book 19 Page 1022 - 1022

OR 196 p 3397  
 OR 196 p 3399




I CERTIFY THIS SURVEY TO BE CORRECT  
 TO THE BEST OF MY KNOWLEDGE.

*Donald C. Baker*

DONALD C. BAKER P.S. 6938

DATE: FEBRUARY 6, 2007

FDB\ALG  
 File Name: WORK2\S-48-07\MLD

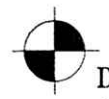

DONALD C. BAKER SURVEYING  
 138 N. CLAY ST.  
 MILLERSBURG, OHIO, 44654  
 PH. 330-674-4788  
 FAX. 330-674-6027

PLAT APPROVED

*3/13/2007*

Instrument 200700050007 OR Book Page 19 1022

SALT CREEK TOWNSHIP  
 3RD. QTR., LOT 14  
 T-10 N; R 5 W  
 HOLMES COUNTY, OHIO

SURVEYED FOR: ROBERT HERSHBERGER

REFERENCES


- O.R. VOL. 16 PAGE 16
- O.R. VOL. 87 PAGE 282
- O.R. VOL. 57 PAGE 356
- PLAT VOL. 17 PAGE 608
- PLAT VOL. 14 PAGE 873
- BEARINGS FROM PLAT VOL 14 PAGE 873

0 100 200



SCALE: 1"=100'

- 5/8" REBAR FOUND UNLESS OTHERWISE NOTED
- ▲ R.R. SPIKE FOUND
- 5/8" REBAR WITH I.D. CAP SET I.D. CAP MARKED "BAKER 6938"

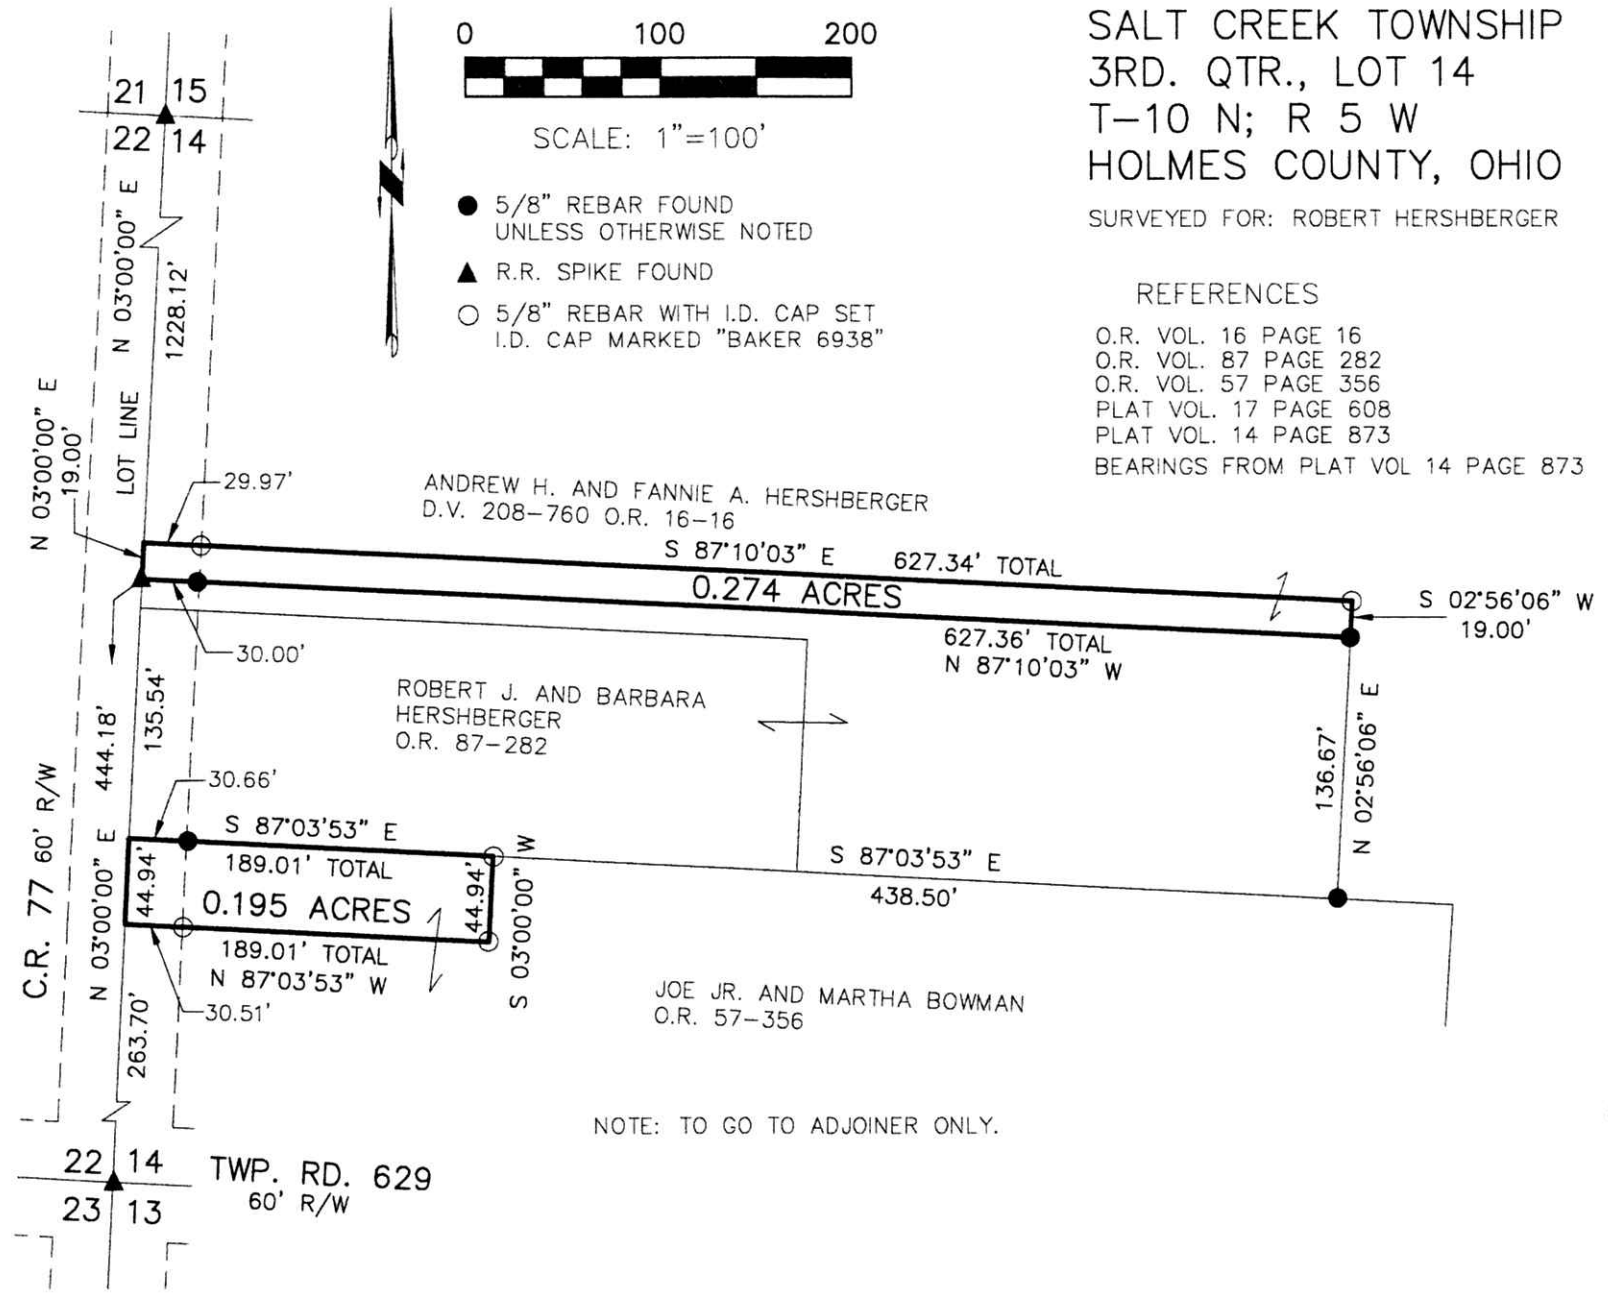

NOTE: TO GO TO ADJOINER ONLY.

200700050007  
 PAUL A  
 MILLER LAW  
 MILLERSBURG OH