


SURVEY OF A 19.283 ACRE PARCEL

SE QUARTER OF SECTION 12
T-19-N, R-15-W
WASHINGTON TOWNSHIP
HOLMES COUNTY, OHIO


200700050642
Filed for Record in
HOLMES COUNTY, OH
SALLY MILLER
06-18-2007 At 10:43 am.
SMALL PLAT 40.00
OR Book 19 Page 1053 - 1053
OR 197p2699

Instrument Book Page
200700050642 OR 19 1053

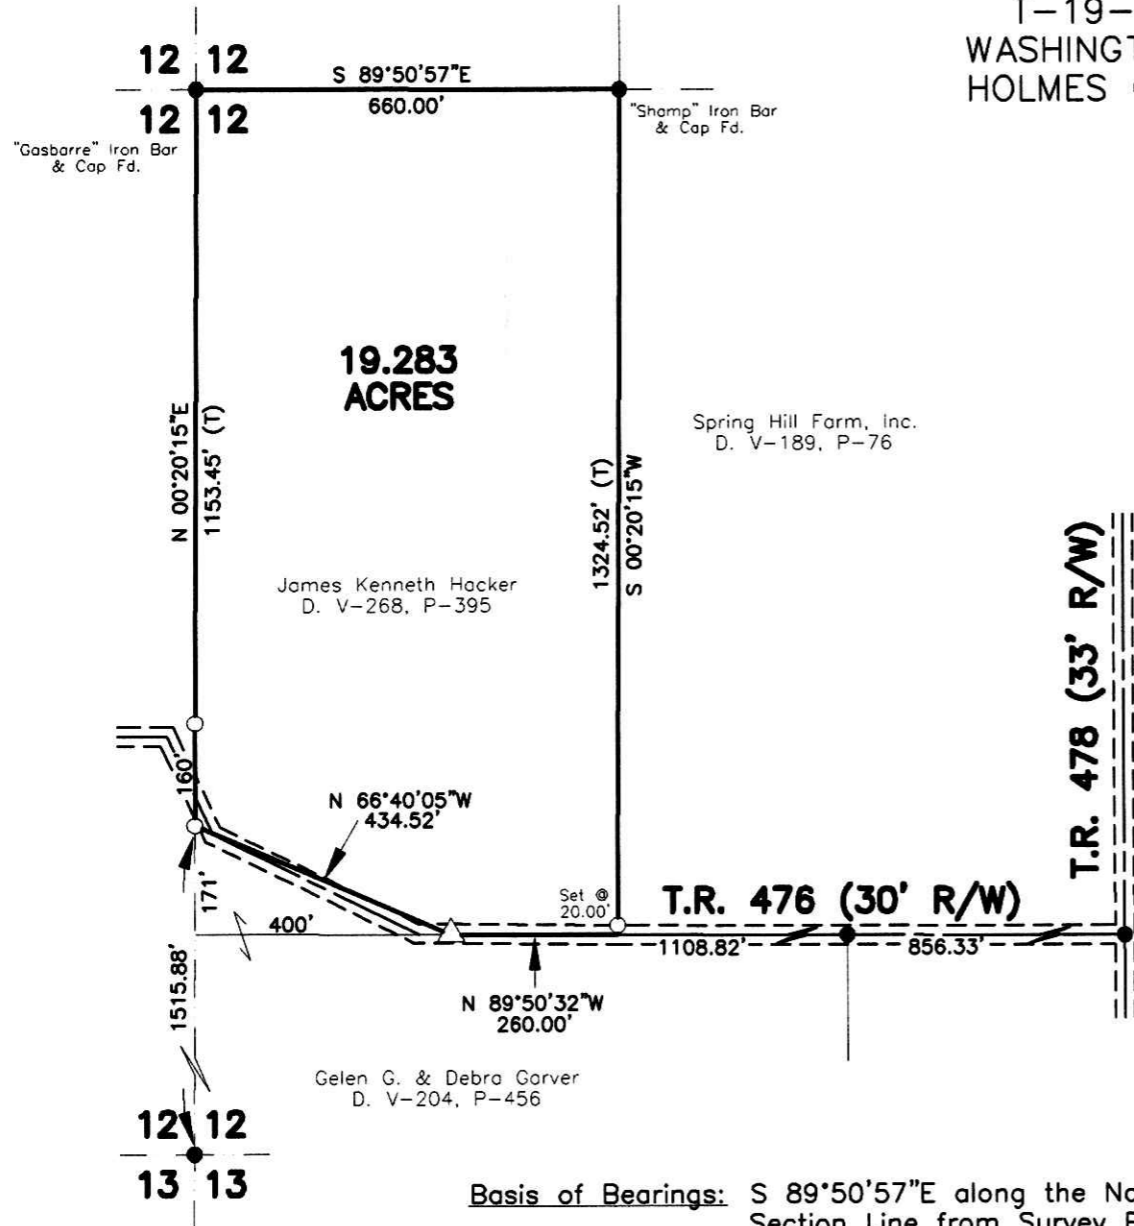

- 5/8" Iron Bar Found Unless Otherwise Noted.
- △ R.R. Spike Set In Roadway
- (T) Total Distance
- 5/8" x 30" Bar With Yellow Plastic Cap Marked RUDOLPH Set 6449

200700050642
JAMES K HACKER
13699 TR 476
LAKEVILLE OH 44638

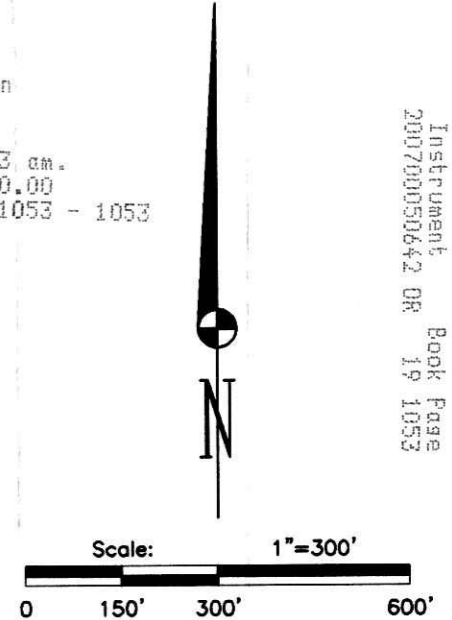

PLAT APPROVED

6/7/2007

REFERENCE SURVEYS:

- 11-39
- 14-824
- 17-54
- 18-169

I Certify This Survey And Plat To Be Correct To The Best Of My Knowledge.

12-21-05 *Ronald G. Rudolph*
Date Ronald G. Rudolph P.S. No. 6449



R.G. Rudolph
SURVEYING, INC.

223 W. Liberty St.
Wooster, Ohio 44691
(330) 262-0798
Job No. 18051



Basis of Bearings: S 89°50'57"E along the North Quarter Section Line from Survey Plat V-17, P-54.

LR