



WASHINGTON TOWNSHIP
 S.W. QTR. SECTION 30
 N.W. QTR. SECTION 31
 T-20 N; R-15 W
 HOLMES COUNTY OHIO
 SURVEYED FOR: MICHAEL VAN HORN

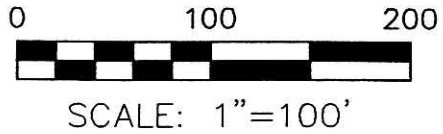

- ▲ R.R. SPIKE FOUND
- 5/8" REBAR FOUND
UNLESS OTHERWISE NOTED
- 5/8" REBAR SET WITH I.D. CAP
I.D. CAP MARKED "BAKER 6938"



DONALD C. BAKER SURVEYING
 138 N. CLAY STREET
 MILLERSBURG, OHIO 44654
 PH. 330-674-4788
 FAX 330-674-6027

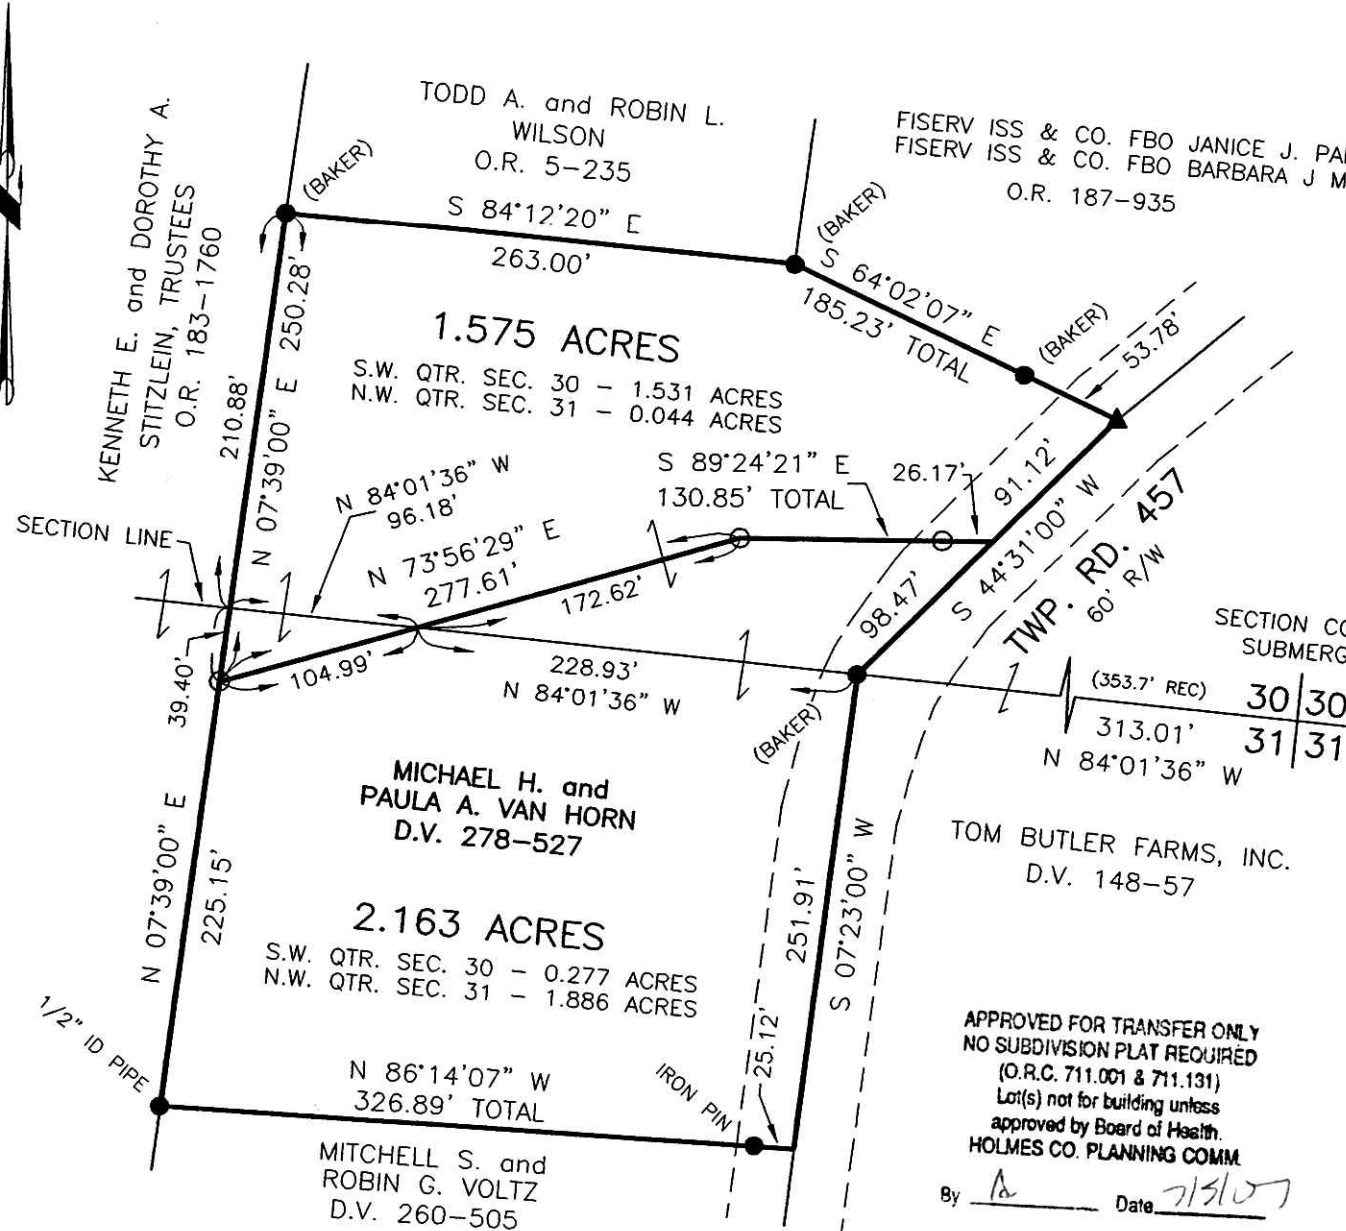

Instrument Book Page
 200700051087 OR 19 1079

200700051087
 Filed for Record in
 HOLMES COUNTY, OH
 SALLY MILLER
 07-12-2007 At 10:20 am.
 SMALL PLAT 40.00
 OR Book 19 Page 1079 - 1079
 ORV 198 page 994

REFERENCES

- DEED VOL. 260 PAGE 505
- DEED VOL. 278 PAGE 527
- O.R. VOL. 5 PAGE 235
- O.R. VOL. 118 PAGE 253
- O.R. VOL. 183 PAGE 1760
- O.R. VOL. 187 PAGE 935
- PLAT VOL. 14 PAGE 84
- PLAT VOL. 19 PAGES 507 & 649
- BEARINGS FROM PLAT VOL. 14 PAGE 84



APPROVED FOR TRANSFER ONLY
 NO SUBDIVISION PLAT REQUIRED
 (O.R.C. 711.001 & 711.131)
 Lot(s) not for building unless
 approved by Board of Health
 HOLMES CO. PLANNING COMM.

By [Signature] Date 7/5/07

I CERTIFY THIS SURVEY TO BE CORRECT
 TO THE BEST OF MY KNOWLEDGE.
[Signature]
 JAMIE D. DARR P.S. 7755
 DATE: JUNE 7, 2007
 JDD/AEG
 FILE NAME: WORK3A\S-339-07\ERZ

PLAT APPROVED

7/2/2007

200700051087
 SOUTHERN TITLE
 OF OHIO LTD.
 MT VERNON OH