

RETRACEMENT SURVEY OF D.V. 266-111
PRAIRIE TOWNSHIP
S.E. QTR. SECTION 26
T-14 N; R-13 W
HOLMES COUNTY, OHIO


OR 199 p 1998

SURVEYED FOR: JOE HOSTETLER

200700052143
MILLER MAST
& MASON ATTYS
MILLERSBURG OH

REFERENCES

- DEED VOL. 266 PAGE 111
- DEED VOL. 275 PAGE 650
- DEED VOL. 280 PAGES 691 & 693
- O.R. VOL. 173 PAGE 1207
- O.R. VOL. 175 PAGE 1042
- PLAT VOL. 14 PAGES 614 & 975
- PLAT VOL. 16 PAGE 573
- PLAT VOL. 19 PAGE 200
- BEARINGS FROM PLAT VOL 14 PAGE 614

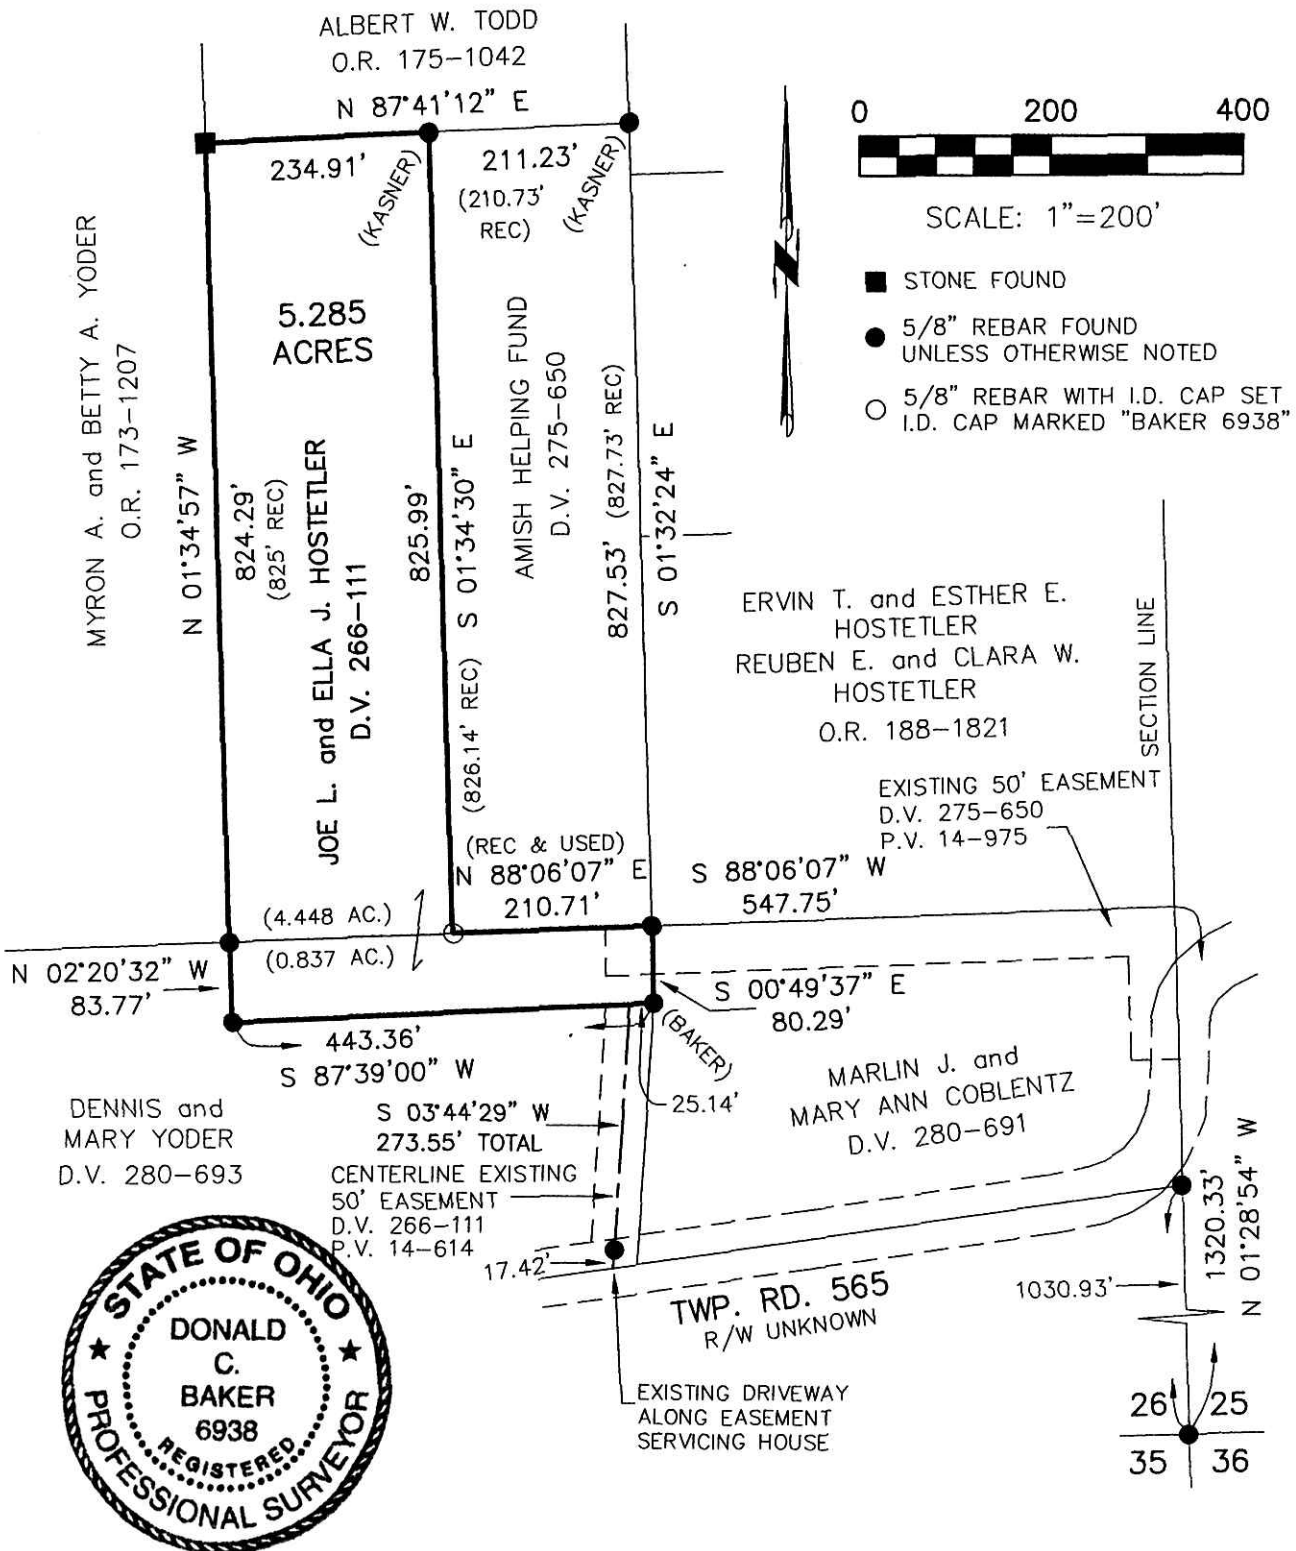

I CERTIFY THIS SURVEY TO BE CORRECT TO THE BEST OF MY KNOWLEDGE.

Donald C. Baker
DONALD C. BAKER P.S. 6938
DATE: JULY 12, 2007

KES\AEG
File Name: WORK2\S-432-07\ERZ



DONALD C. BAKER SURVEYING
138 N. CLAY ST.
MILLERSBURG, OHIO, 44654
PH. 330-674-4788
FAX. 330-674-6027

PLAT APPROVED

6/22/2007