

KNOX TOWNSHIP
 1ST. QTR., LOT 14
 T-9 N; R-9 W
 HOLMES COUNTY, OHIO

Instrument Book Page
 200700053271 OR 19 1182

SURVEYED FOR: DONALD PACKE

200700053271
 Filed for Record in
 HOLMES COUNTY, OH
 SALLY MILLER
 11-13-2007 At 10:29 am.
 SMALL FLAT 40.00
 OR Book 19 Page 1182 - 1182
 crv 200 page 3176



REFERENCES

DEED VOL. 17 PAGE 498
 DEED VOL. 166 PAGE 231
 DEED VOL. 226 PAGE 772

PLAT VOL. 10 PAGE 640
 PLAT VOL. 11 PAGE 155
 PLAT VOL. 17 PAGE 507
 PLAT VOL. 18 PAGE 553

BEARINGS FROM PLAT VOL. 11 PAGE 155

200700053271
 CRITCHFIELD, CRITCHFIELD
 JOHNSON ATTY
 MILLERSBURG OH

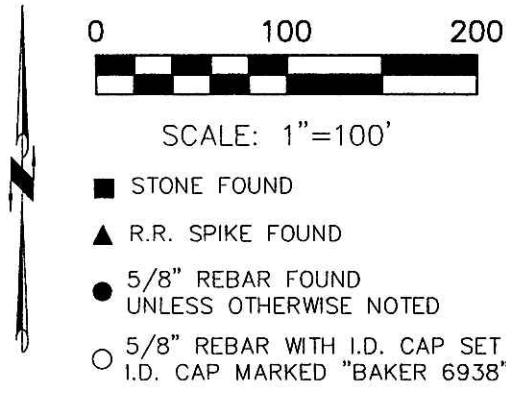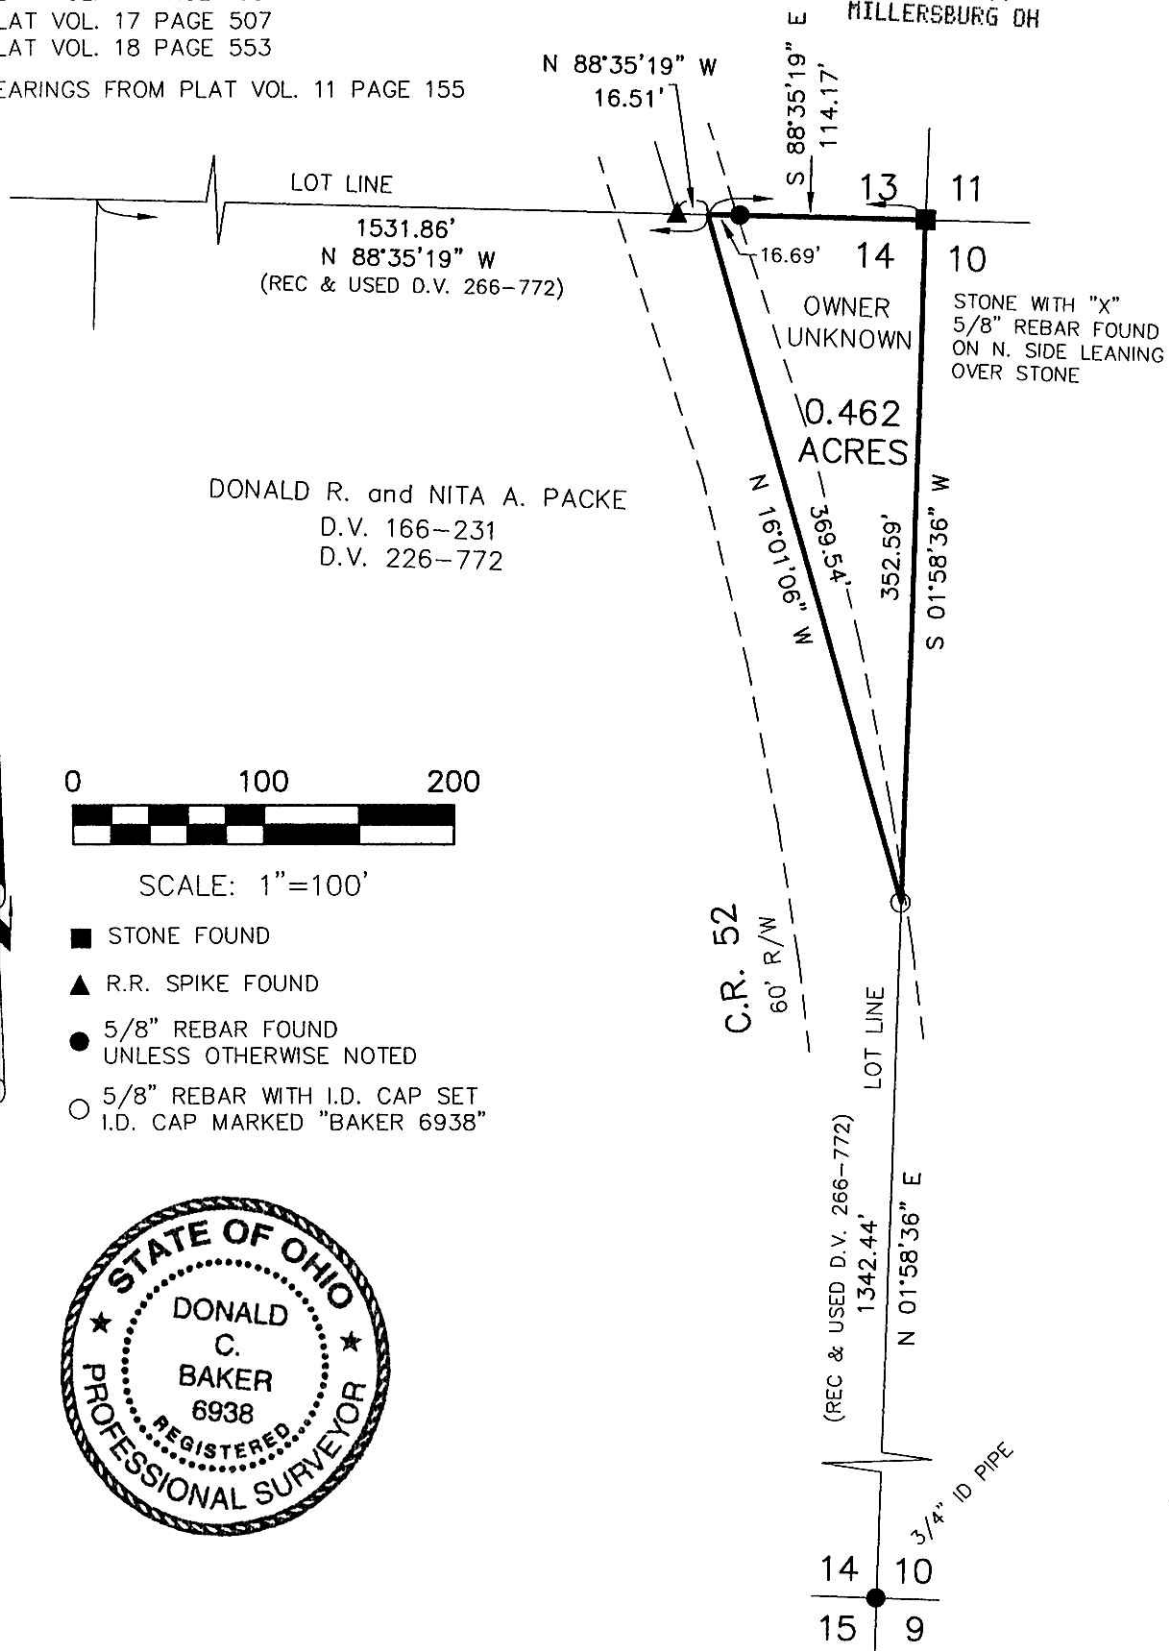

I CERTIFY THIS SURVEY TO BE CORRECT TO THE BEST OF MY KNOWLEDGE.

Donald C. Baker
 DONALD C. BAKER P.S. 6938
 DATE: AUG. 9, 2007

KES\DB
 File Name: WORK2\S-471-07\ERZ



DONALD C. BAKER SURVEYING
 138 N. CLAY ST.
 MILLERSBURG, OHIO, 44654
 PH. 330-674-4788
 FAX. 330-674-6027

PLAT APPROVED

11/7/2007