

KNOX TOWNSHIP  
S.W. QTR. FRACTIONAL SECTION 13  
T-9 N; R-9 W  
HOLMES COUNTY, OHIO

SURVEYED FOR: RICHARD TISH

REFERENCES


- DEED VOL. 165 PAGE 278
- DEED VOL. 174 PAGE 119
- DEED VOL. 201 PAGE 145
- DEED VOL. 271 PAGE 854
- PLAT VOL. 5 PAGE 41
- PLAT VOL. 8 PAGE 710
- PLAT VOL. 14 PAGE 983
- SURVEY BY WILLIAM H. LONG OF A  
14.039 ACRE TRACT DATED 3-19-1982
- BEARINGS FROM PLAT VOL. 14 PAGE 983

APPROVED FOR TRANSFER ONLY  
NO SUBDIVISION PLAT REQUIRED  
(O.R.C. 711.001 & 711.131)  
Lot(s) not for building unless  
approved by Board of Health  
HOLMES CO. PLANNING COMM.

By lc Date 10/15/07

200700053341  
Filed for Record in  
HOLMES COUNTY, OH  
SALLY MILLER  
11-15-2007 At 03:32 pm.  
SMALL PLAT 40.00  
OR Book 19 Page 1190 - 1190

OR 201 p 50

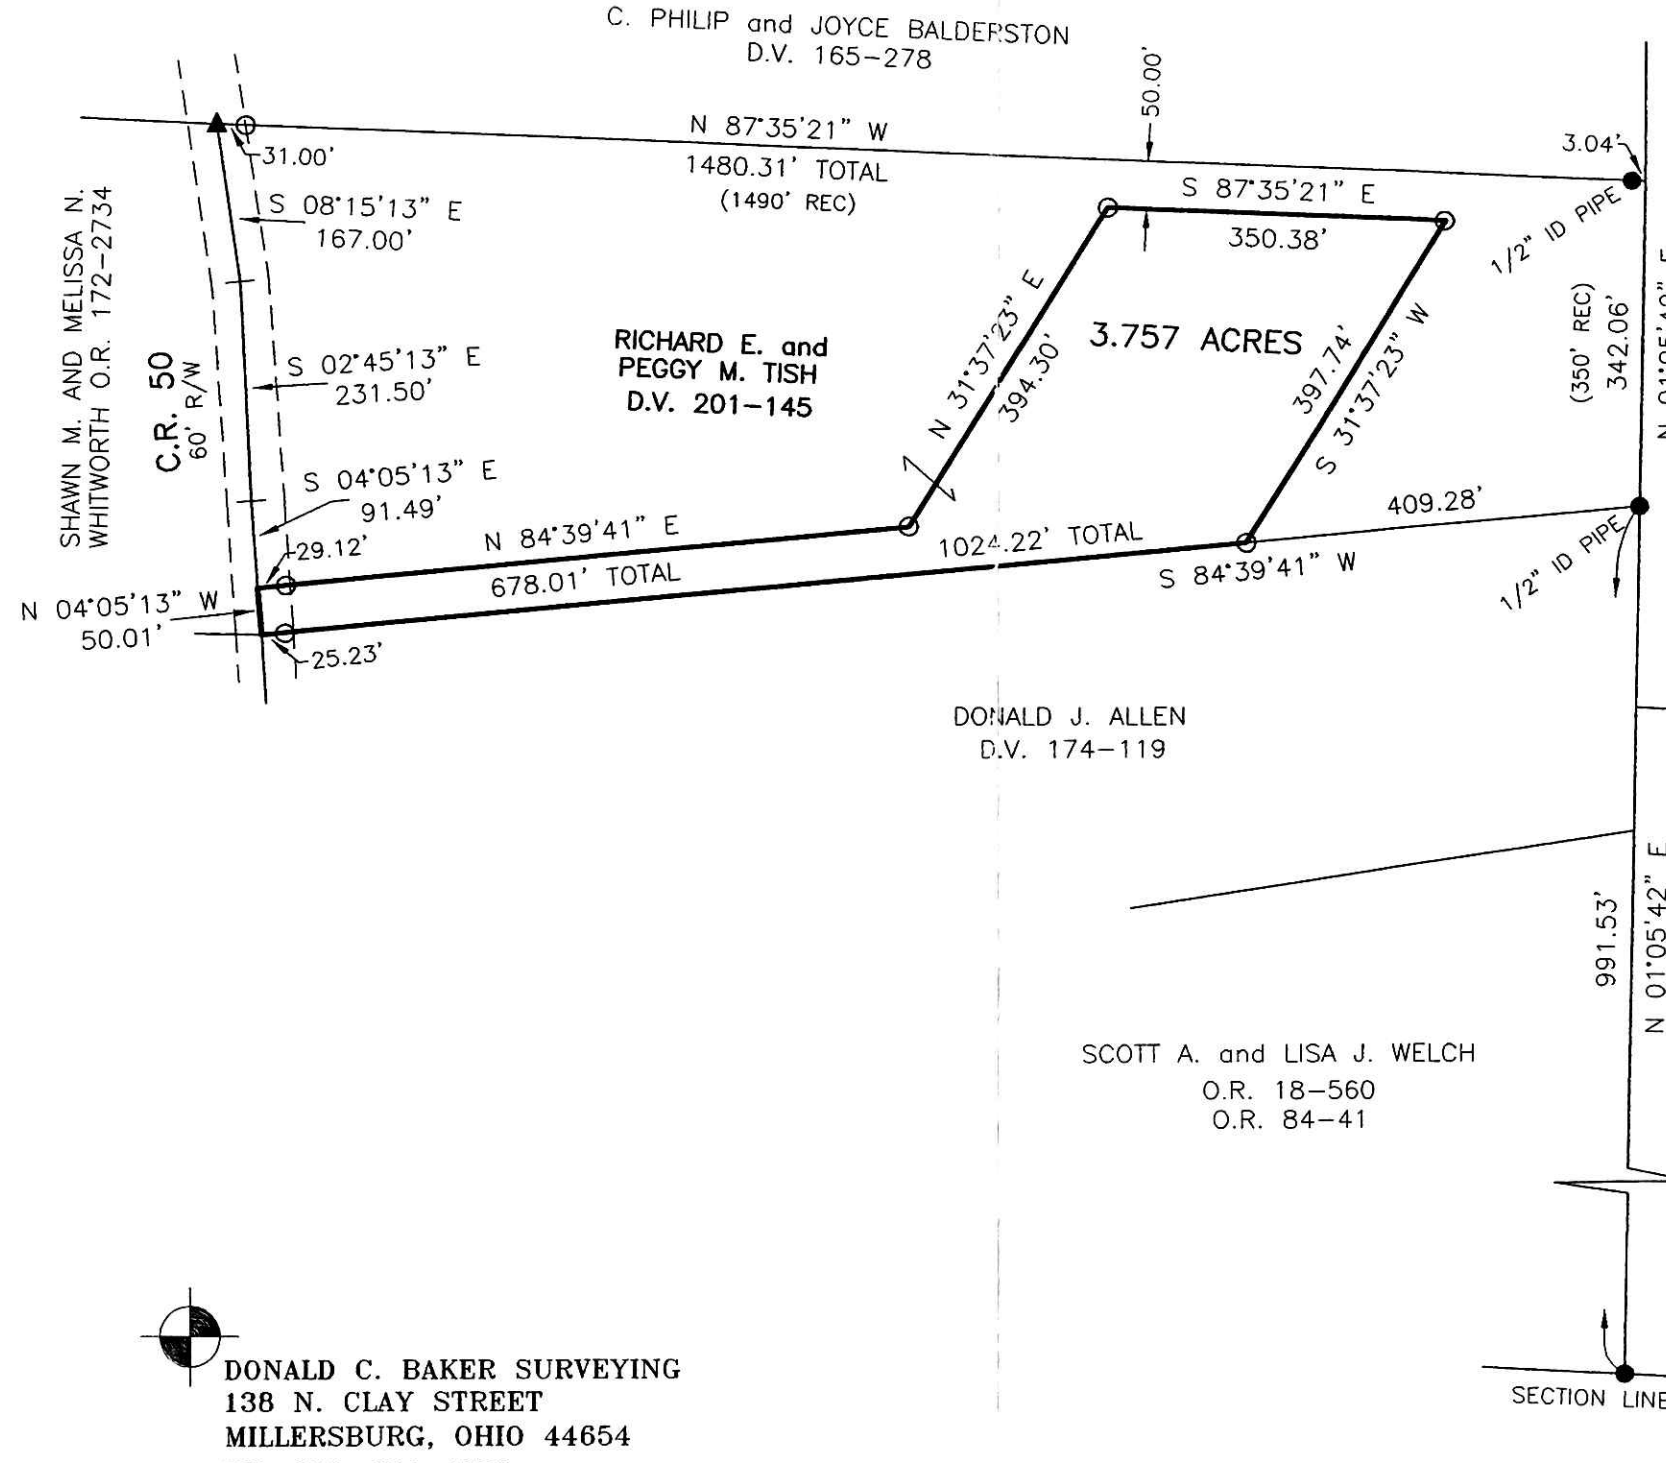

CHARLES and CONSTANCE STEINER  
D.V. 271-854

0 200 400



SCALE: 1"=200'

- ▲ R.R. SPIKE FOUND
- 5/8" REBAR FOUND  
UNLESS OTHERWISE NOTED
- 5/8" REBAR SET WITH I.D. CAP  
I.D. CAP MARKED "BAKER 6938"

200700053341  
BLAIR A  
BOWER ATTY  
MILLERSBURG OH

SCOTT A. and LISA J. WELCH  
O.R. 18-560  
O.R. 84-41

JOHN P. YUNGEN, JR.  
O.R. 184-2964  
O.R. 185-3196



I CERTIFY THIS SURVEY TO BE CORRECT  
TO THE BEST OF MY KNOWLEDGE.

Jamie D. Darr  
JAMIE D. DARR P.S. 7755  
DATE: AUG. 16, 2007  
JDD\KES-DB  
FILE NAME: WORK3\S-493-07\ERZ



DONALD C. BAKER SURVEYING  
138 N. CLAY STREET  
MILLERSBURG, OHIO 44654  
PH. 330-674-4788  
FAX 330-674-6027

S.E. CORNER OF  
THE S.W. QUARTER  
667.38' 13  
N 87°17'30" W 18  
SECTION LINE  
LOT 44  
4TH QTR.  
T-9 N; R-9 W

PLAT APPROVED

10/15/2007

Instrument 200700053341 OR Book Page 19 1190