RETRACEMENT SURVEY OF O.R. 194–1048
MECHANIC TOWNSHIP
2ND. QTR., LOTS 28 & 29
T–8 N; R–6 W
HOLMES COUNTY, OHIO

SURVEYED FOR: ADAM WEISGARBER

REFERENCES

DEED VOL. 120 PAGE 375
DEED VOL. 174 PAGE 477

O.R. VOL. 194 PAGE 1048

PLAT VOL. 8 PAGE 173

BEARINGS ASSUMED

200800055464
Filed for Record in
HOLMES COUNTY ,OH
SALLY MILLER
04-04-2008 At 09:31 am.
SMALL PLAT 40.00
OR Book 19 Page 1279 - 1279

OR 203 p 2576

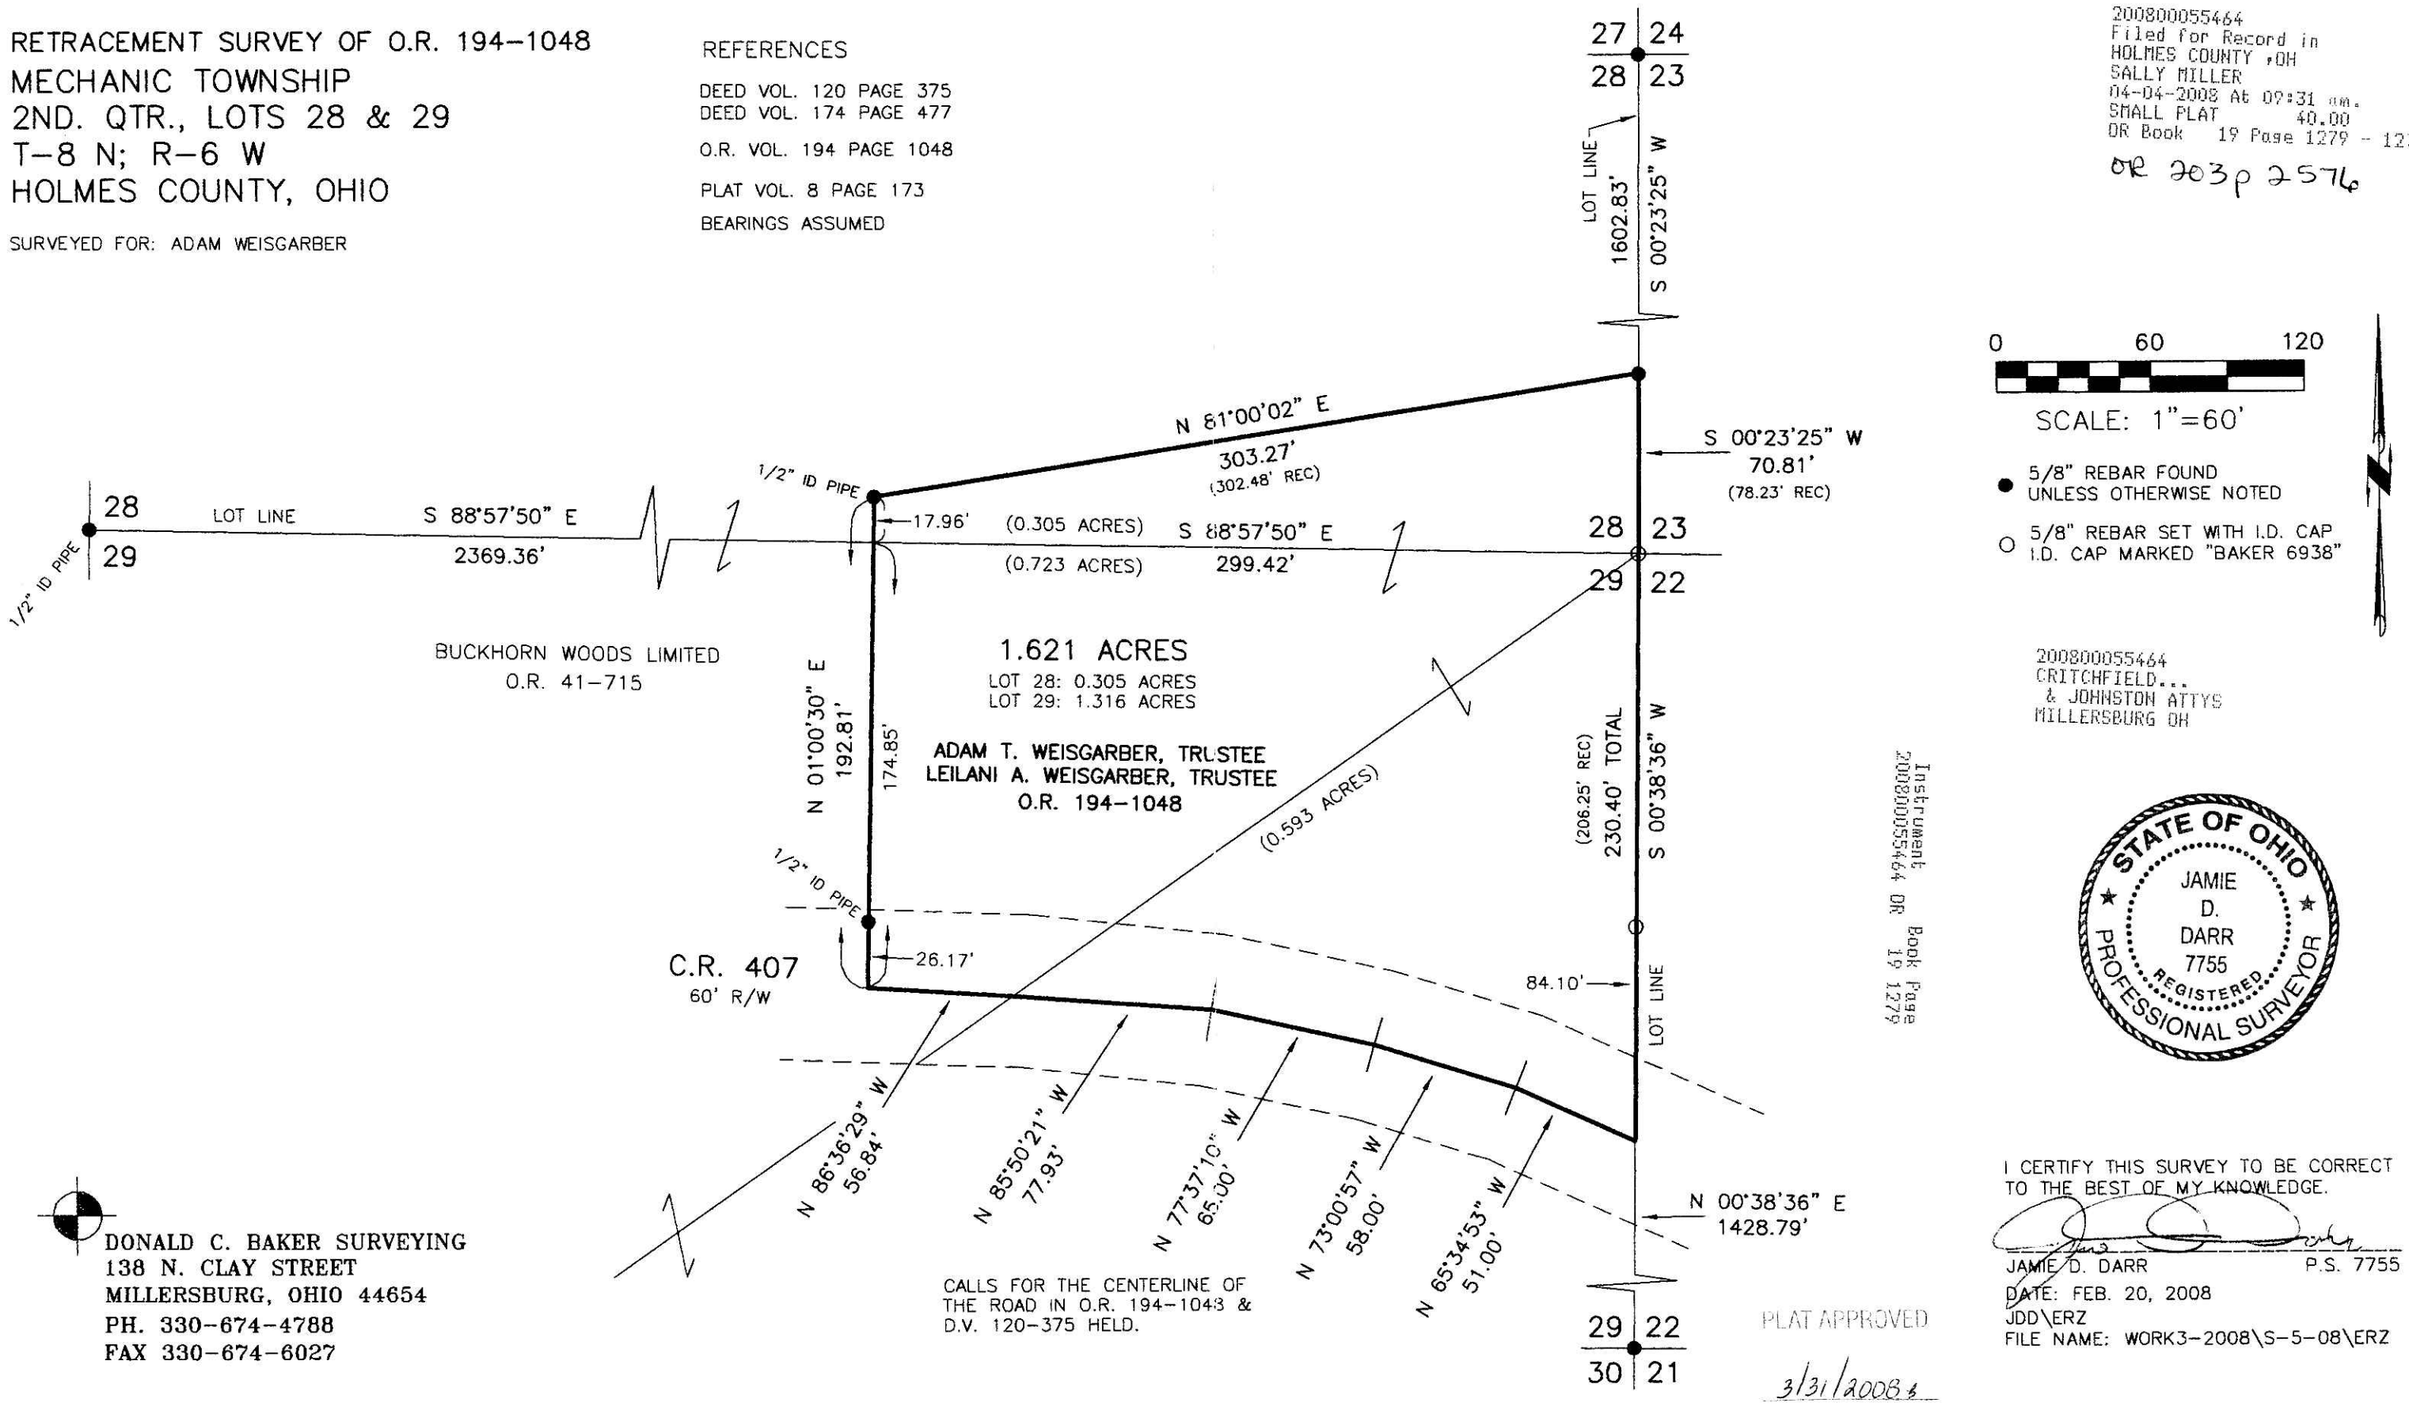

0 60 120

SCALE: 1"=60'

● 5/8" REBAR FOUND UNLESS OTHERWISE NOTED

○ 5/8" REBAR SET WITH I.D. CAP I.D. CAP MARKED "BAKER 6938"

200800055464
CRITCHFIELD...
& JOHNSTON ATTYS
MILLERSBURG OH

Instrument 200800055464 OR Book 19 Page 1279

STATE OF OHIO
JAMIE D. DARR 7755
REGISTERED PROFESSIONAL SURVEYOR

I CERTIFY THIS SURVEY TO BE CORRECT TO THE BEST OF MY KNOWLEDGE.

JAMIE D. DARR P.S. 7755

DATE: FEB. 20, 2008
JDD\ERZ
FILE NAME: WORK3-2008\S-5-08\ERZ

PLAT APPROVED

3/31/2008

DONALD C. BAKER SURVEYING
138 N. CLAY STREET
MILLERSBURG, OHIO 44654
PH. 330–674–4788
FAX 330–674–6027