

VILLAGE OF MILLERSBURG
 HARDY TOWNSHIP
 S.W. QTR. SECTION 11
 T-9 N; R-7 W
 HOLMES COUNTY, OHIO

200800055539
 BLAIR A
 BOWER ATTY
 MILLERSBURG OH

SURVEYED FOR: KENNETH KLINGLER

REFERENCES

- O.R. VOL. 64 PAGE 669
- O.R. VOL. 124 PAGE 846
- O.R. VOL. 137 PAGE 247
- PLAT VOL. 2 PAGE 38
- PLAT VOL. 16 PAGE 601
- PLAT VOL. 7 PAGE 549
- PLAT VOL. 15 PAGE 93
- BEARINGS FROM PLAT VOL. 16 PAGE 601



SCALE: 1"=100'



- ▲ R.R. SPIKE FOUND
- 5/8" REBAR FOUND UNLESS OTHERWISE NOTED
- 5/8" REBAR SET WITH I.D. CAP I.D. CAP MARKED "BAKER 6938"



LAKEVIEW ALLOT. P.2-38
 824

N 87°26'56" W

S.E. CORNER
 LOT 824
 LAKEVIEW ALLOT.
 (P.2-38)

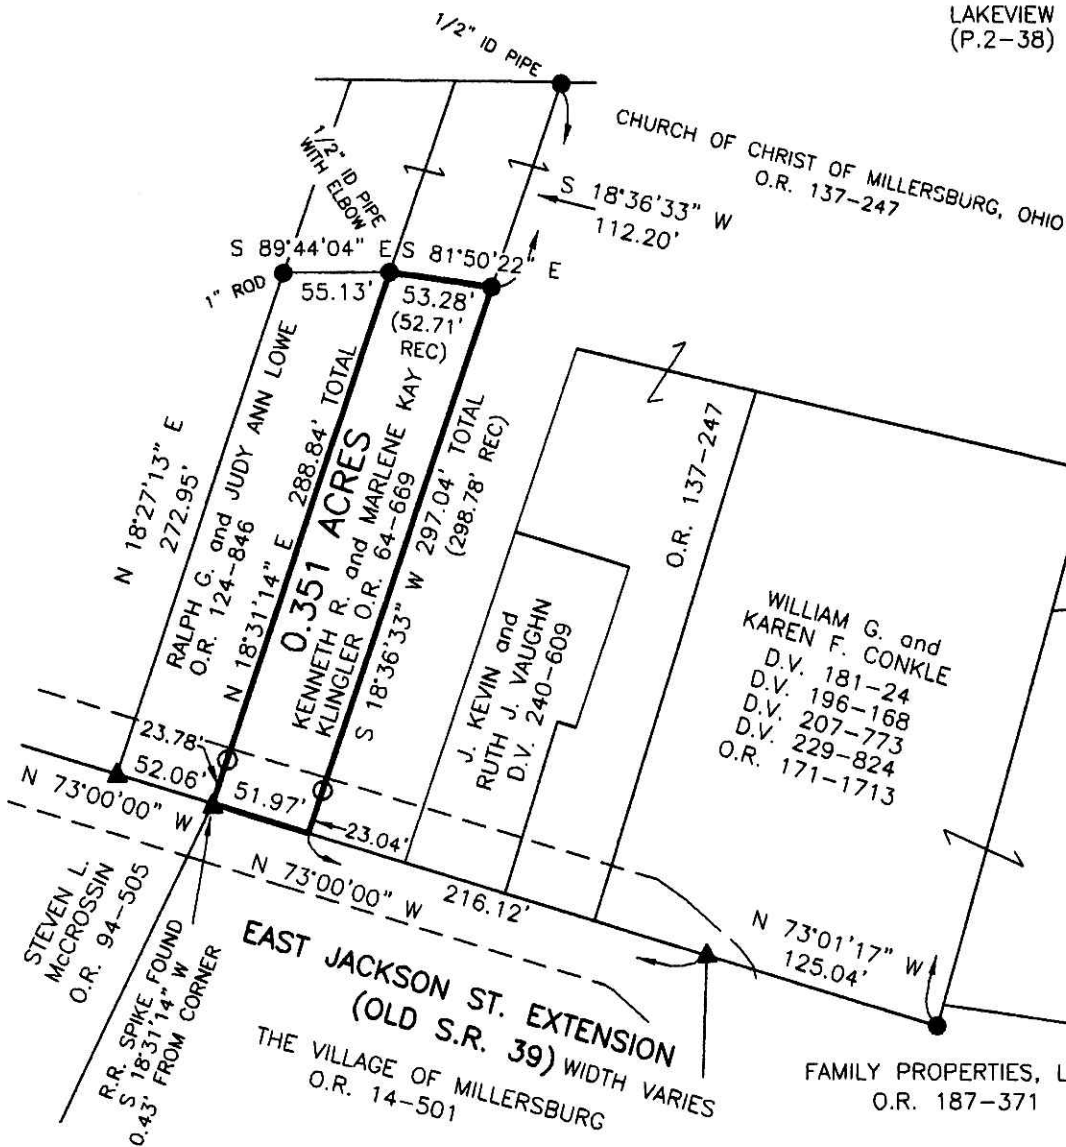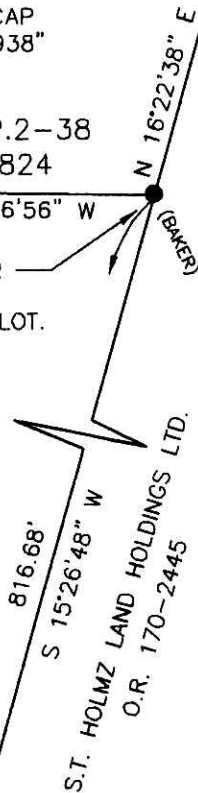


200800055539
 Filed for Record in
 HOLMES COUNTY, OH
 SALLY MILLER
 04-09-2008 At 02:14 pm.
 SMALL PLAT 40.00
 OR Book 19 Page 1285 - 1285
 OR 203p 2899



I CERTIFY THIS SURVEY TO BE CORRECT TO THE BEST OF MY KNOWLEDGE.

[Signature]
 JAMIE D. DARR P.S. 7755

DATE: MARCH 6, 2008
 JDD/KES
 FILE NAME: WORK3-2008\S-100-08\MLD-ERZ

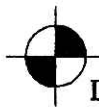

DONALD C. BAKER SURVEYING
 138 N. CLAY STREET
 MILLERSBURG, OHIO 44654 PLAT APPROVED
 PH. 330-674-4788
 FAX 330-674-6027
 3/28/2008