



RETRACEMENT SURVEY  
 PAINT TOWNSHIP  
 4TH. QTR., LOT 14  
 T-10 N; R-5 W  
 HOLMES COUNTY, OHIO

SURVEYED FOR: ANDY MILLER

REFERENCES

- DEED VOL. 120 PAGE 478
- DEED VOL. 121 PAGE 113
- DEED VOL. 125 PAGE 247
- O.R. VOL. 43 PAGES 436 & 442
- PLAT VOL. 2 PAGE 374
- PLAT VOL. 14 PAGE 473
- PLAT VOL. 18 PAGE 746
- BEARINGS FROM PLAT VOL. 2 PAGE 374

200800056389  
 FRENCH RIDGE  
 TITLE  
 MILLERSBURG OH

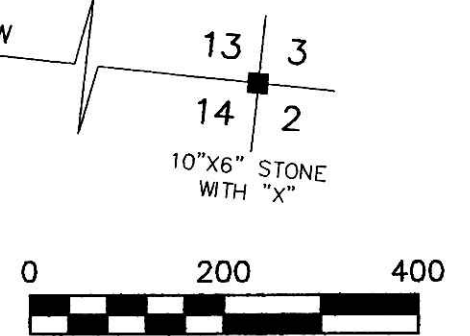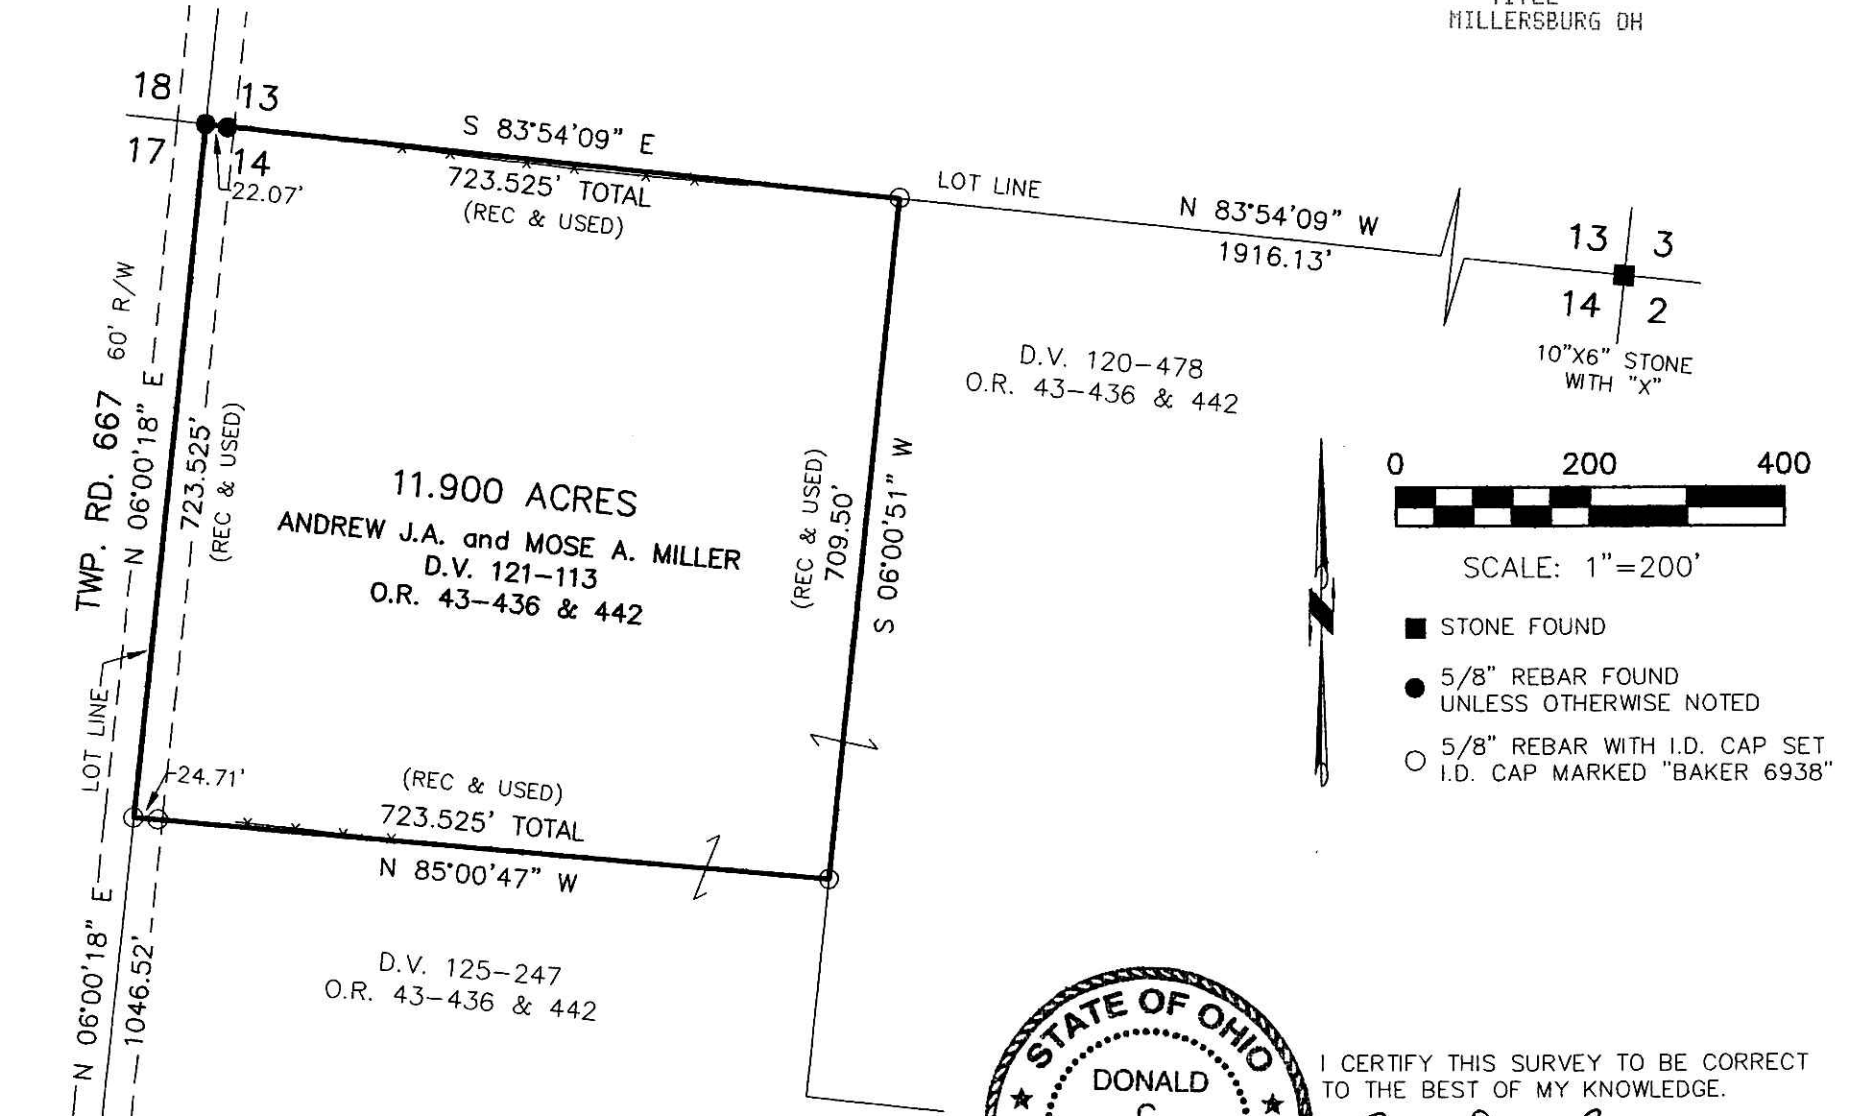

DONALD C. BAKER SURVEYING  
 138 N. CLAY ST.  
 MILLERSBURG, OHIO, 44654  
 PH. 330-674-4788  
 FAX. 330-674-6027

200800056389  
 Filed for Record in  
 HOLMES COUNTY, OH  
 SALLY MILLER  
 06-03-2008 At 03:23 pm.  
 SMALL PLAT 40.00  
 DR Book 19 Page 1314 - 1314

OR 204 p 2979



I CERTIFY THIS SURVEY TO BE CORRECT  
 TO THE BEST OF MY KNOWLEDGE.

*Donald C Baker*  
 DONALD C. BAKER P.S. 6938  
 DATE: NOV. 12, 2007  
 KES\ALG  
 File Name: WORK2\S-678-07\ERZ

PLAT APPROVED

*5/29/2008*

Instrument: 200800056389 OR Book Page 19 1314