

KNOX TOWNSHIP
 1ST. QTR., LOT 13
 T-9 N; R-9 W
 HOLMES COUNTY, OHIO

SURVEYED FOR: DON PACKE

REFERENCES:

DEED VOL. 226 PAGE 772
 DEED VOL. 253 PAGE 469
 O.R. VOL. 81 PAGE 698
 PLAT VOL. 4 PAGES 96 & 98
 PLAT VOL. 7 PAGE 256
 PLAT VOL. 8 PAGE 103 & 363
 PLAT VOL. 17 PAGE 507

BEARINGS FROM PLAT VOL. 17 PAGE 507




SCALE: 1"=200'

- STONE FOUND
- ▲ R.R. SPIKE FOUND
- 5/8" REBAR WITH I.D. CAP SET
I.D. CAP MARKED "BAKER 6938"

200800056695
 Filed for Record in
 HOLMES COUNTY, OH
 SALLY MILLER
 06-19-2008 At 09:01 am.
 SMALL PLAT 40.00
 DR Book 19 Page 1329 - 1329

OR 205 p 749

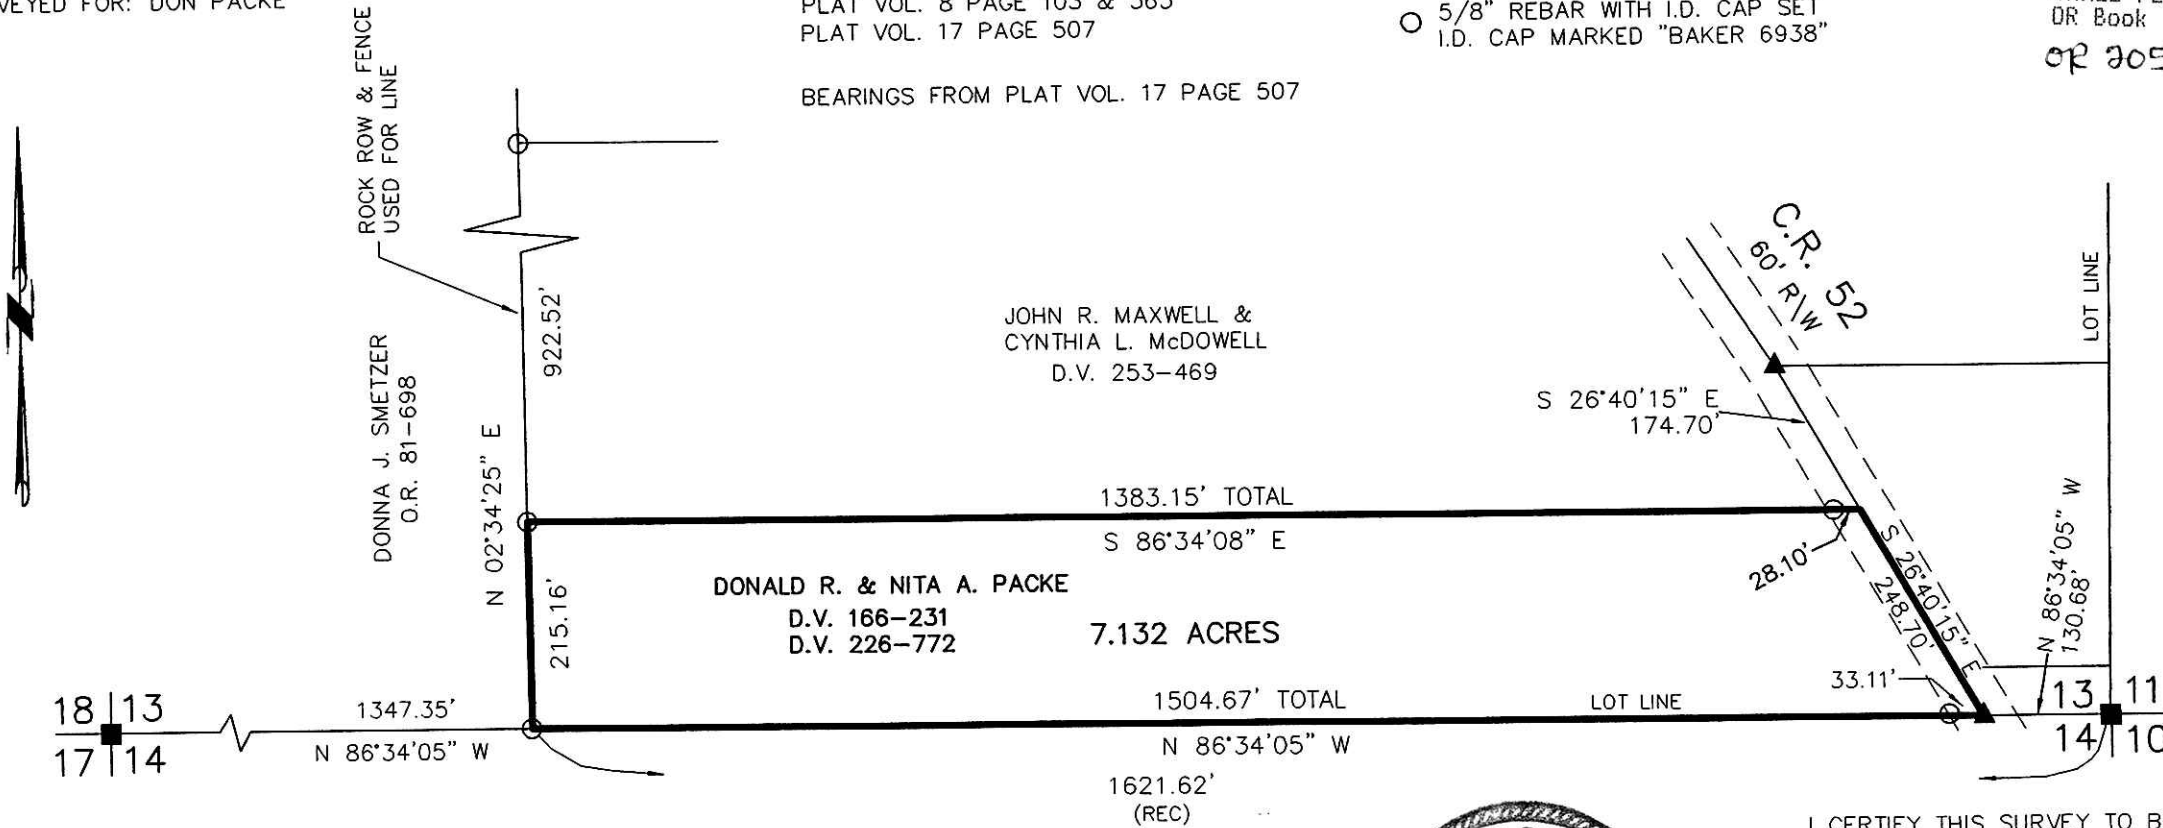

200800056695
 CRITCHFIELD, ...
 & JOHNSTON ATTYS
 MILLERSBURG OH



DONALD C. BAKER SURVEYING
 138 N. CLAY ST.
 MILLERSBURG, OH 44654
 PH. 330-674-4788
 FAX: 330-674-6027



I CERTIFY THIS SURVEY TO BE CORRECT
 TO THE BEST OF MY KNOWLEDGE.

Donald C. Baker
 DONALD C. BAKER PS 6938
 FCC\KES DATE: JAN. 26, 2005
 File Name: C:\WORK\S-901A-04\DCB-ERZ

PLAT APPROVED

6/13/2008

Instrument: 200800056695 DR Book Page 19 1329