

RETRACEMENT SURVEY OF D.V. 258-1022

SALT CREEK TOWNSHIP
N.W. QTR. SECTION 34
T-15 N; R-12 W
HOLMES COUNTY, OHIO

SURVEYED FOR: ERVIN WEAVER JR.

REFERENCES

DEED VOL. 15 PAGE 445
DEED VOL. 172 PAGE 463
DEED VOL. 215 PAGE 746
DEED VOL. 218 PAGES 871 & 978
DEED VOL. 258 PAGE 1022

O.R. VOL. 30 PAGE 832
O.R. VOL. 49 PAGE 387
O.R. VOL. 184 PAGE 1789
O.R. VOL. 186 PAGE 103

PLAT VOL. 4 PAGE 200
PLAT VOL. 7 PAGE 95
PLAT VOL. 8 PAGE 595
PLAT VOL. 17 PAGE 439



BEARINGS FROM PLAT VOL. 7 PAGE 95

TWP. RD. 610
R/W UNKNOWN



I CERTIFY THIS SURVEY TO BE CORRECT TO THE BEST OF MY KNOWLEDGE.

JAMIE D. DARR P.S. 7755
DATE: DEC. 15, 2008
JDD/KES-LGC
FILE NAME: WORK3\S-587-08\ERZ

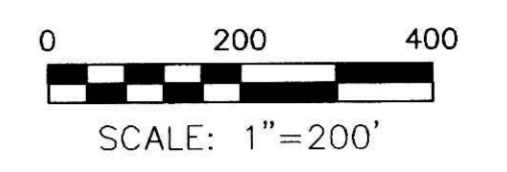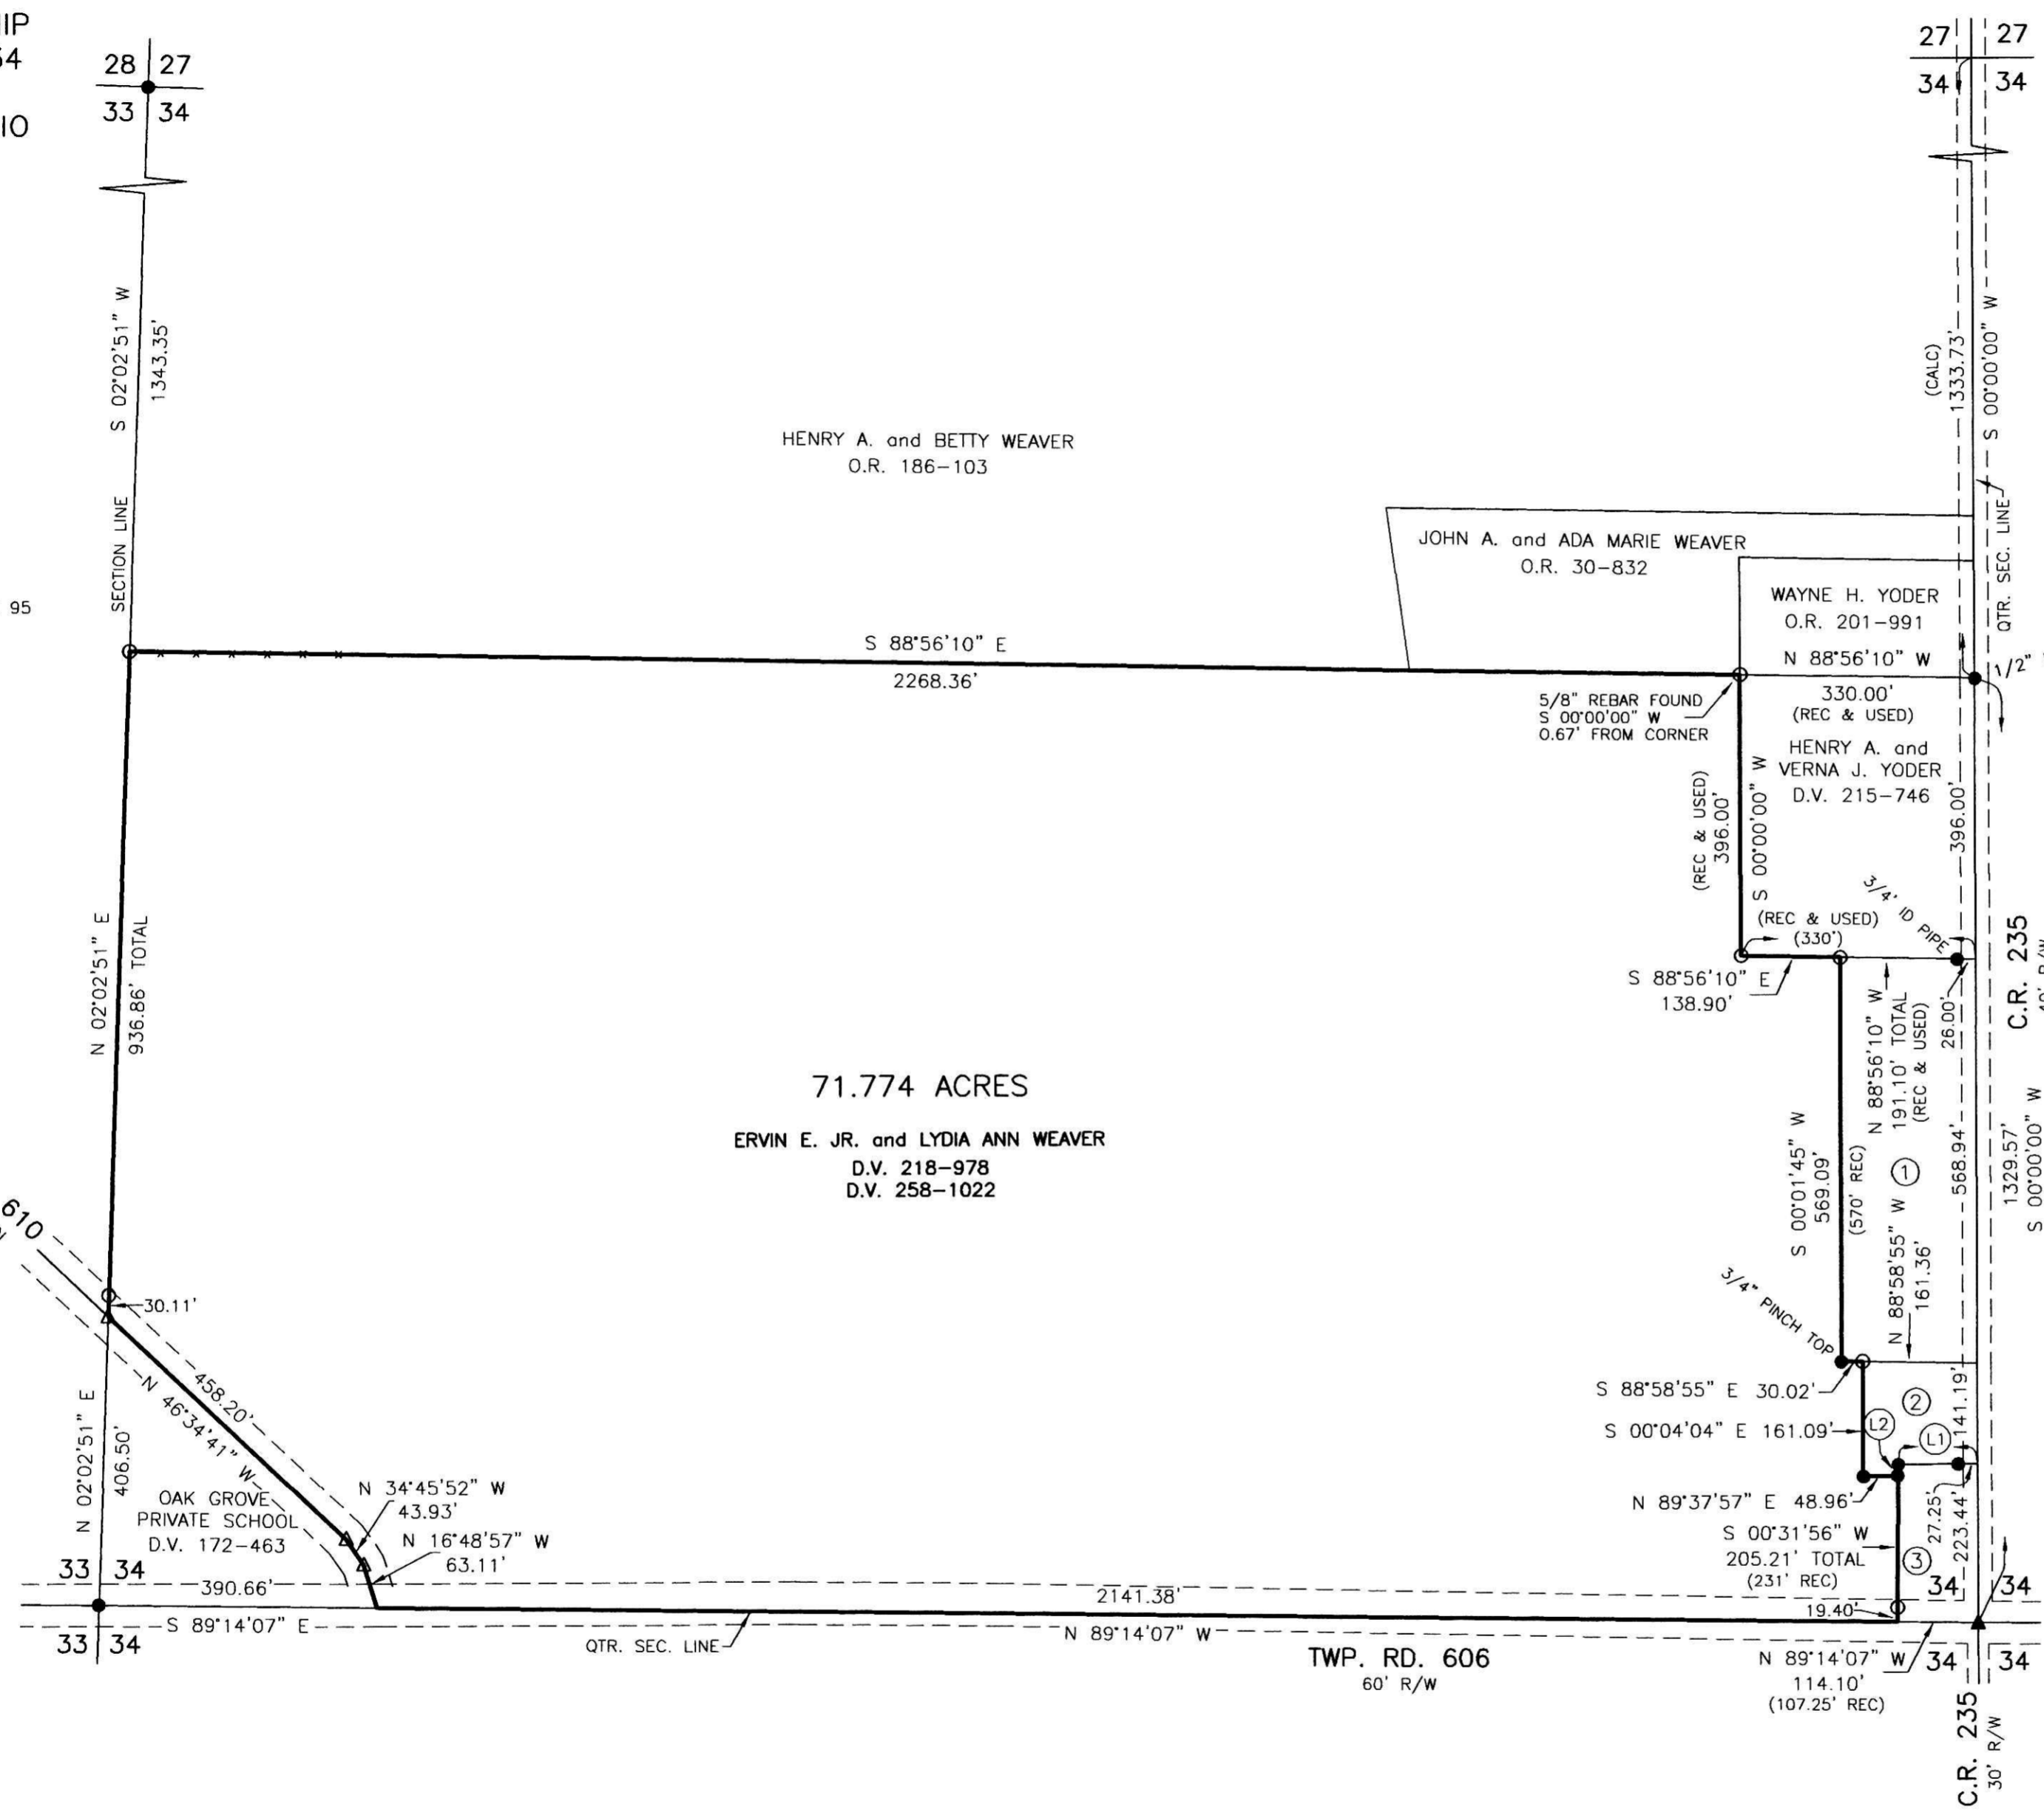

- ▲ R.R. SPIKE FOUND
- 5/8" REBAR FOUND UNLESS OTHERWISE NOTED
- △ R.R. SPIKE SET
- 5/8" REBAR SET WITH I.D. CAP I.D. CAP MARKED "BAKER 6938"

- ① AMANDA WEAVER D.V. 218-871 D.V. 221-819 O.R. 184-1789
- ② ERVIN E. JR. and LYDIA ANN WEAVER O.R. 49-387
- ③ TRUSTEES OF THE CANAAN BAPTIST CHURCH D.V. 15-445

LINE	BEARING	DISTANCE
L1	S 89°37'57" W	112.04'
L2	S 00°31'56" W	16.00'

200900059879
Filed for Record in
HOLMES COUNTY, OH
ANITA HALL
02-05-2009 At 01:35 PM.
PLAT MED 43.20
DR Book 19 Page 1459 - 1459
ORV 208 page 3204

Instrument 200900059879 DR Book Page 19 1459

200900059879
PAUL A MILLER ATTY
MILLERSBURG OH

DONALD C. BAKER SURVEYING
138 N. CLAY STREET
MILLERSBURG, OHIO 44654
PH. 330-674-4788
FAX 330-674-6027

PLAT APPROVED
1/20/2009