

RETRACEMENT SURVEY OF O.R. 201-3325

VILLAGE OF GLENMONT  
RICHLAND TOWNSHIP  
N.W. QTR. SECTION 1  
N.E. QTR. SECTION 2  
T-8 N; R-9 W  
HOLMES COUNTY, OHIO

SURVEYED FOR: FRENCH RIDGE TITLE COMPANY

REFERENCES


DEED VOL. 184 PAGE 232  
DEED VOL. 276 PAGE 230

O.R. VOL. 111 PAGE 788  
O.R. VOL. 137 PAGE 144  
O.R. VOL. 201 PAGE 3325  
O.R. VOL. 206 PAGE 1774

PLAT VOL. 5 PAGE 163  
PLAT VOL. 7 PAGES 52, 111 & 435  
PLAT VOL. 18 PAGE 278  
PLAT VOL. 19 PAGE 722


BEARINGS FROM PLAT VOL. 18 PAGE 278

THOMAS J. and  
IRENE P. ALEXANDER  
D.V. 276-230  
O.R. 137-144

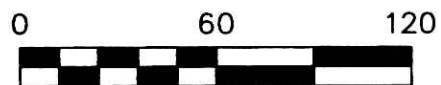


SCALE: 1"=60'

● 5/8" REBAR FOUND  
UNLESS OTHERWISE NOTED

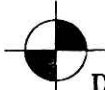

DONALD C. BAKER SURVEYING  
138 N. CLAY STREET  
MILLERSBURG, OHIO 44654  
PH. 330-674-4788  
FAX 330-674-6027

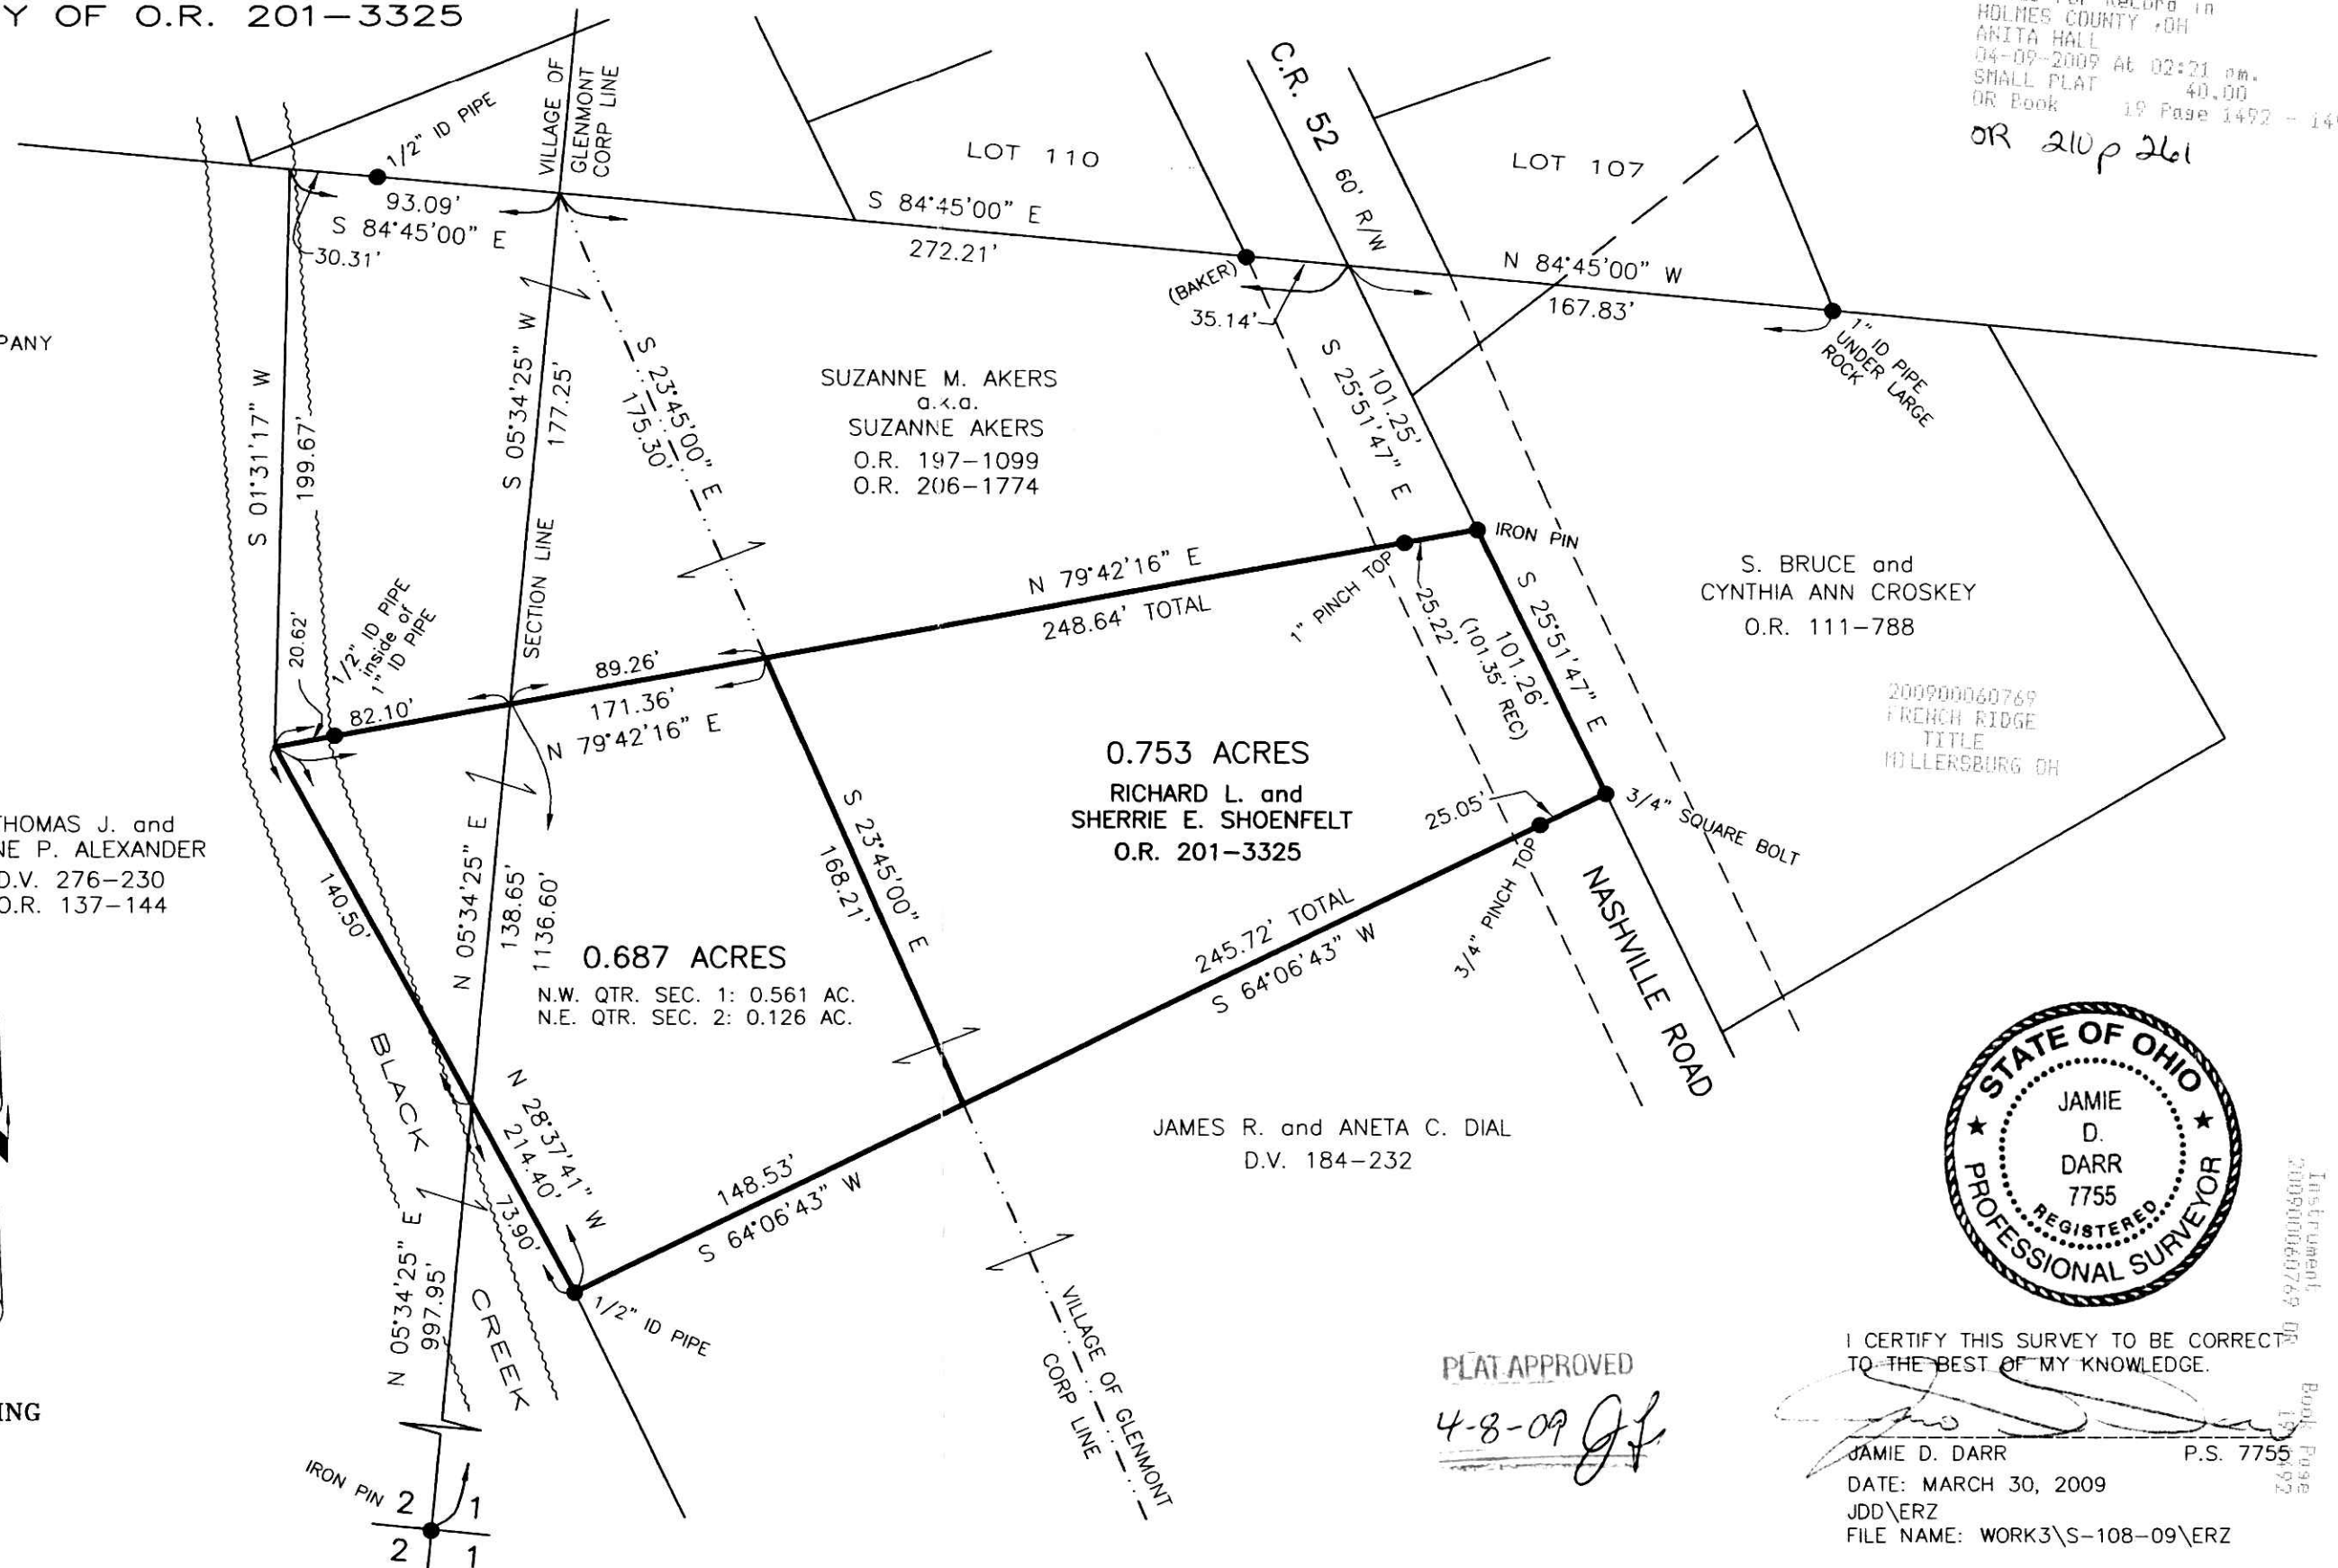

200900060769  
Filed for Record in  
HOLMES COUNTY, OH  
ANITA HALL  
04-09-2009 At 02:21 pm.  
SMALL PLAT 40.00  
OR Book 19 Page 1492 - 1492  
OR 210 p 261

200900060769  
FRENCH RIDGE  
TITLE  
MILLERSBURG OH



PLAT APPROVED  
4-8-09 Jf

I CERTIFY THIS SURVEY TO BE CORRECT  
TO THE BEST OF MY KNOWLEDGE.  
JAMIE D. DARR P.S. 7755  
DATE: MARCH 30, 2009  
JDD\ERZ  
FILE NAME: WORK3\S-108-09\ERZ

Instrument  
200900060769  
Book  
Page  
19