


APPROVED FOR TRANSFER ONLY
 NO SUBDIVISION PLAT REQUIRED
 (O.R.C. 711.001 & 711.131
 Lot(s) not for building unless
 approved by Board of Health.
 HOLMES CO. PLANNING COMM.

By JB Date 7-20-09

Instrument 200900062390 DR Book Page 19 1548

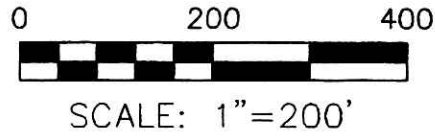

- ▲ R.R. SPIKE FOUND
- 5/8" REBAR FOUND
- UNLESS OTHERWISE NOTED

REFERENCES

- DEED VOL. 265 PAGE 941
- DEED VOL. 251 PAGE 875
- DEED VOL. 245 PAGE 154
- PLAT VOL. 12 PAGE 901
- PLAT VOL. 19 PAGE 198
- PLAT VOL. 18 PAGE 724
- PLAT VOL. 18 PAGE 562
- PLAT VOL. 14 PAGE 326
- BEARINGS FROM
- PLAT VOL. 12 PAGE 901

SALT CREEK TOWNSHIP
 N.W. QTR. SECTION 8
 S.W. QTR. SECTION 8
 T-14 N; R-12 W
 HOLMES COUNTY, OHIO

RETRACEMENT SURVEY OF
 DEED VOL. 265 PG. 941

SURVEYED FOR: VAUGHN TROYER

MOSE J.S. and ANNA
 YODER
 D.V. 139-353
 D.V. 251-875


DAN E. MILLER
 O.R. 175-850

JAMES A. FEIKERT
 D.V. 172-306
 D.V. 245-154

VAUGHN WAYNE and INGA ANNETTE
 TROYER
 D.V. 265-941

20.641 AC.

N.W. QTR. SECTION 8 - 20.330 AC.
 S.W. QTR. SECTION 8 - 0.311 AC.

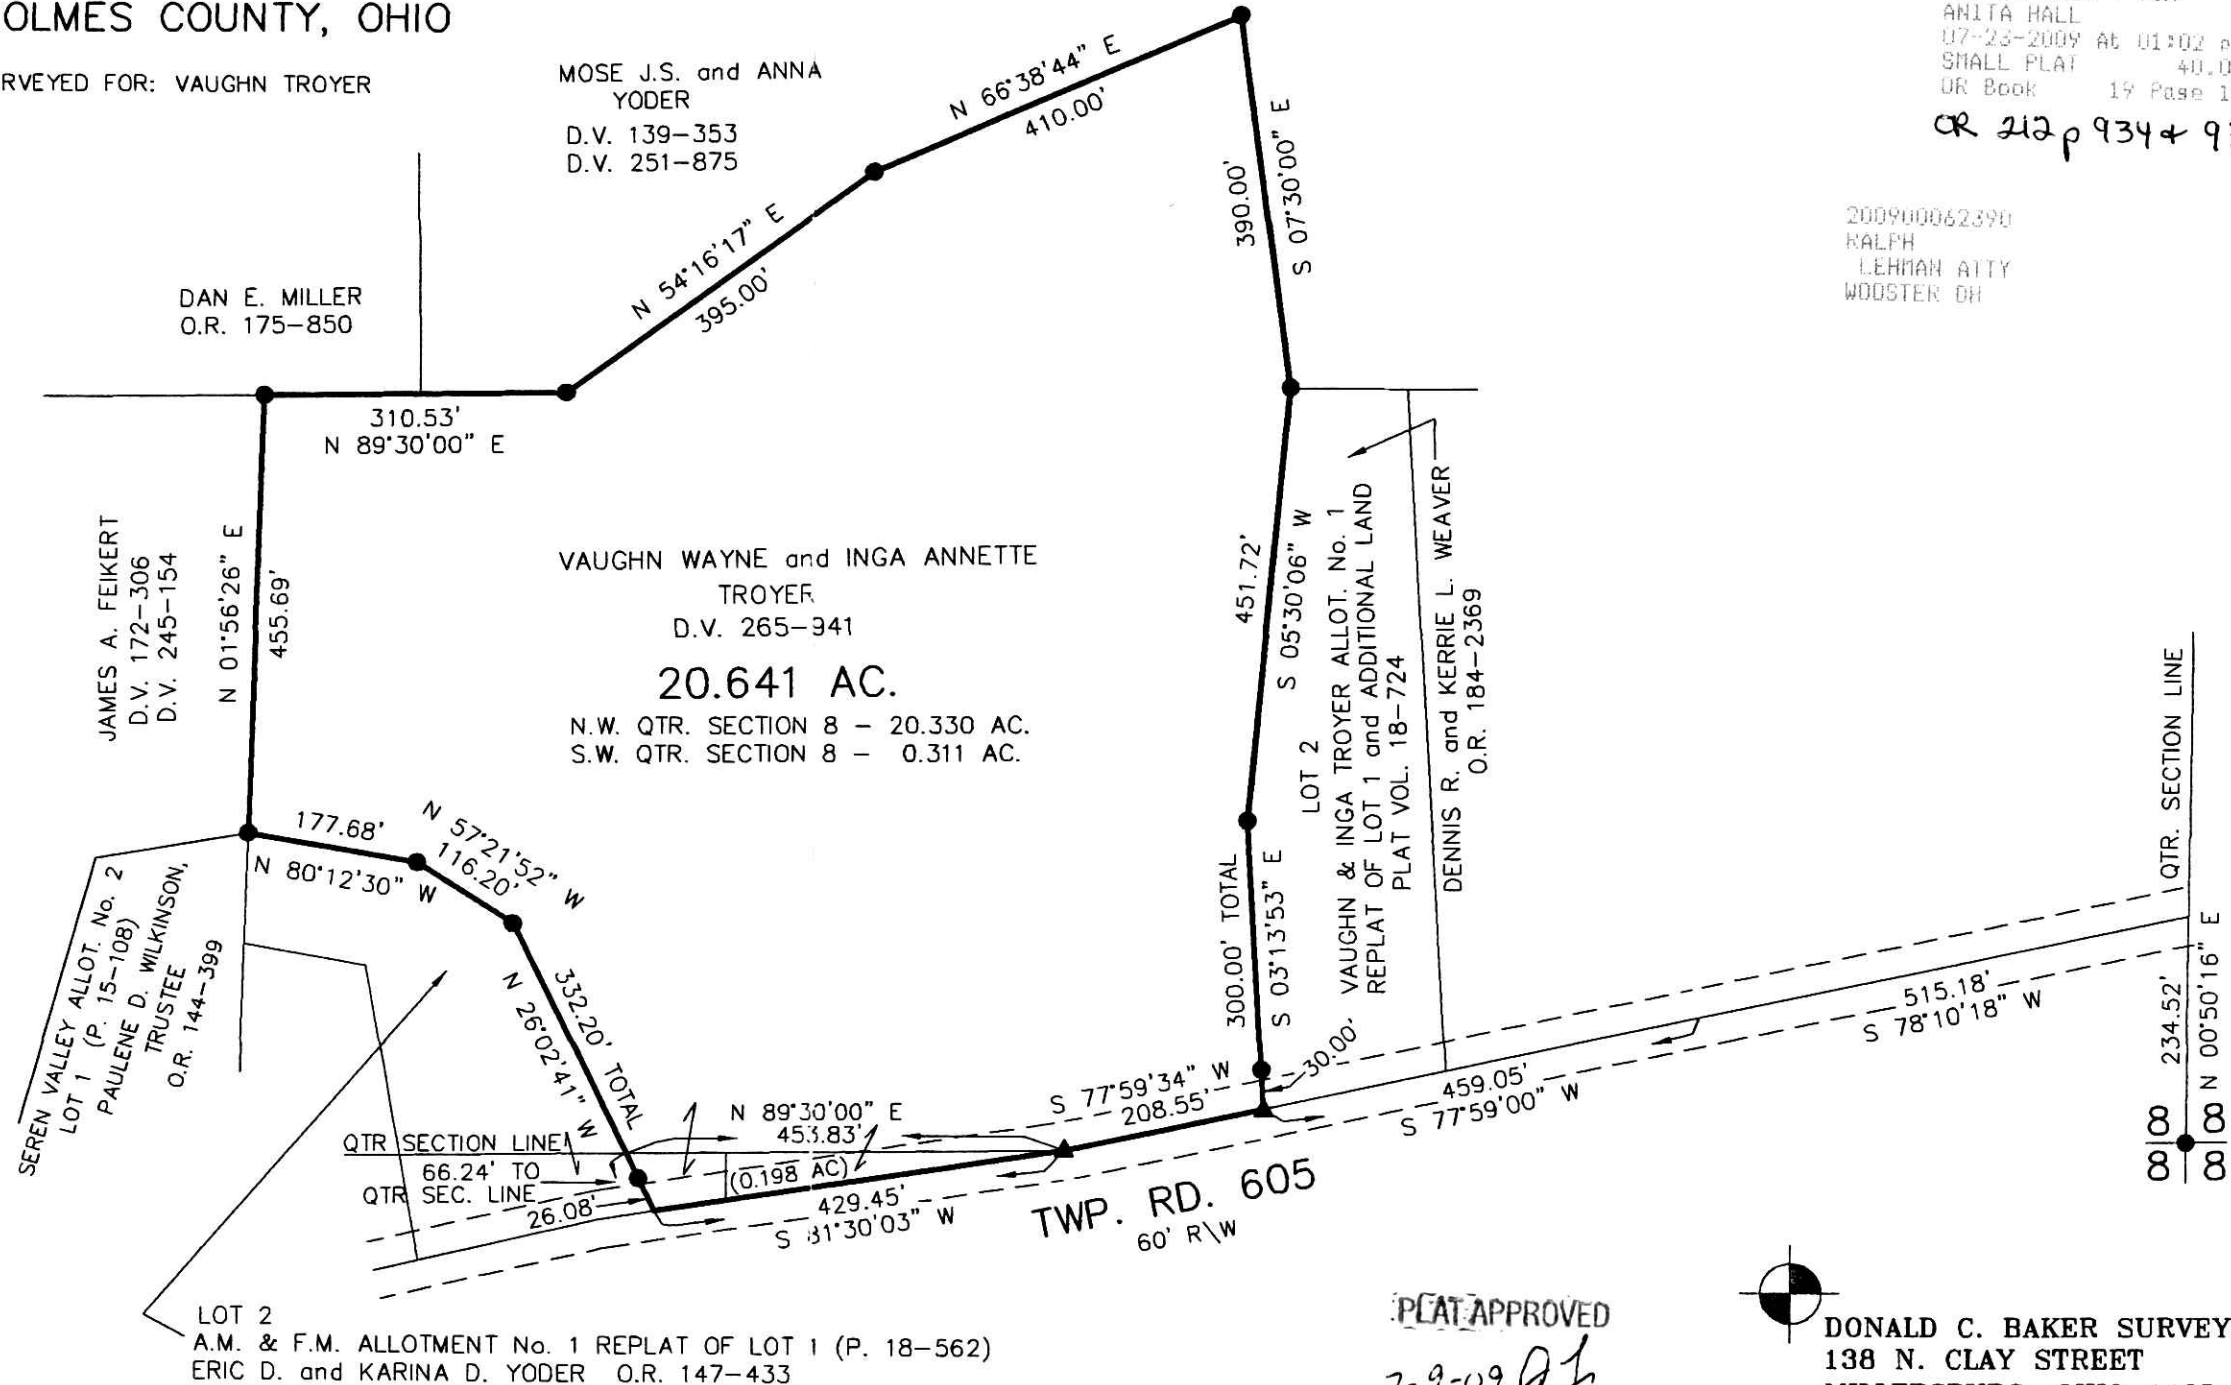

200900062390
 Filed for Record in
 HOLMES COUNTY OH
 ANITA HALL
 07-23-2009 At 01:02 pm.
 SMALL PLAT 40.00
 DR Book 19 Page 1548 - 1548
 CR 212 p 934 + 938

200900062390
 RALPH
 LEHMAN ATTY
 WOOSTER OH




I CERTIFY THIS SURVEY TO BE CORRECT
 TO THE BEST OF MY KNOWLEDGE.

Donald C. Baker
 DONALD C. BAKER P.S. 6938
 DATE: MAY 19, 2009
 FDB\ALG
 FILE NAME: WORK4\S-198-09

PLAT APPROVED

7-9-09 JB

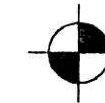

DONALD C. BAKER SURVEYING
 138 N. CLAY STREET
 MILLERSBURG, OHIO 44654
 PH. 330-674-4788
 FAX 330-674-6027