

WASHINGTON TOWNSHIP
S.E. QTR. SECTION 9
T-19 N; R-15 W
HOLMES COUNTY, OHIO

200900063804
CRITCHFIELD CRITCHFIELD & JOHNSTON
MILLERSBURG OH 44654



SURVEYED FOR: GEORGE HAUDENSCHILD

200900063804
Filed for Record in
HOLMES COUNTY, OH
ANITA HALL
10-30-2009 At 03:52 p.m.
SMALL PLAT 40.00
OR Book 19 Page 1590 - 1590
ORV 214 page 1926

REFERENCES

- DEED VOL. 177 PAGE 305
- DEED VOL. 230 PAGE 379
- O.R. VOL. 193 PAGE 2186
- PLAT VOL. 18 PAGE 74
- BEARINGS FROM PLAT VOL. 18 PAGE 74

NOTE: 1.098 ACRE PARCEL TO GO TO ADJOINER.

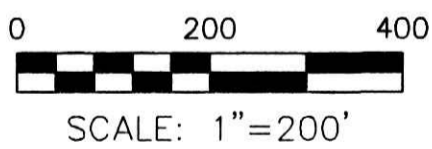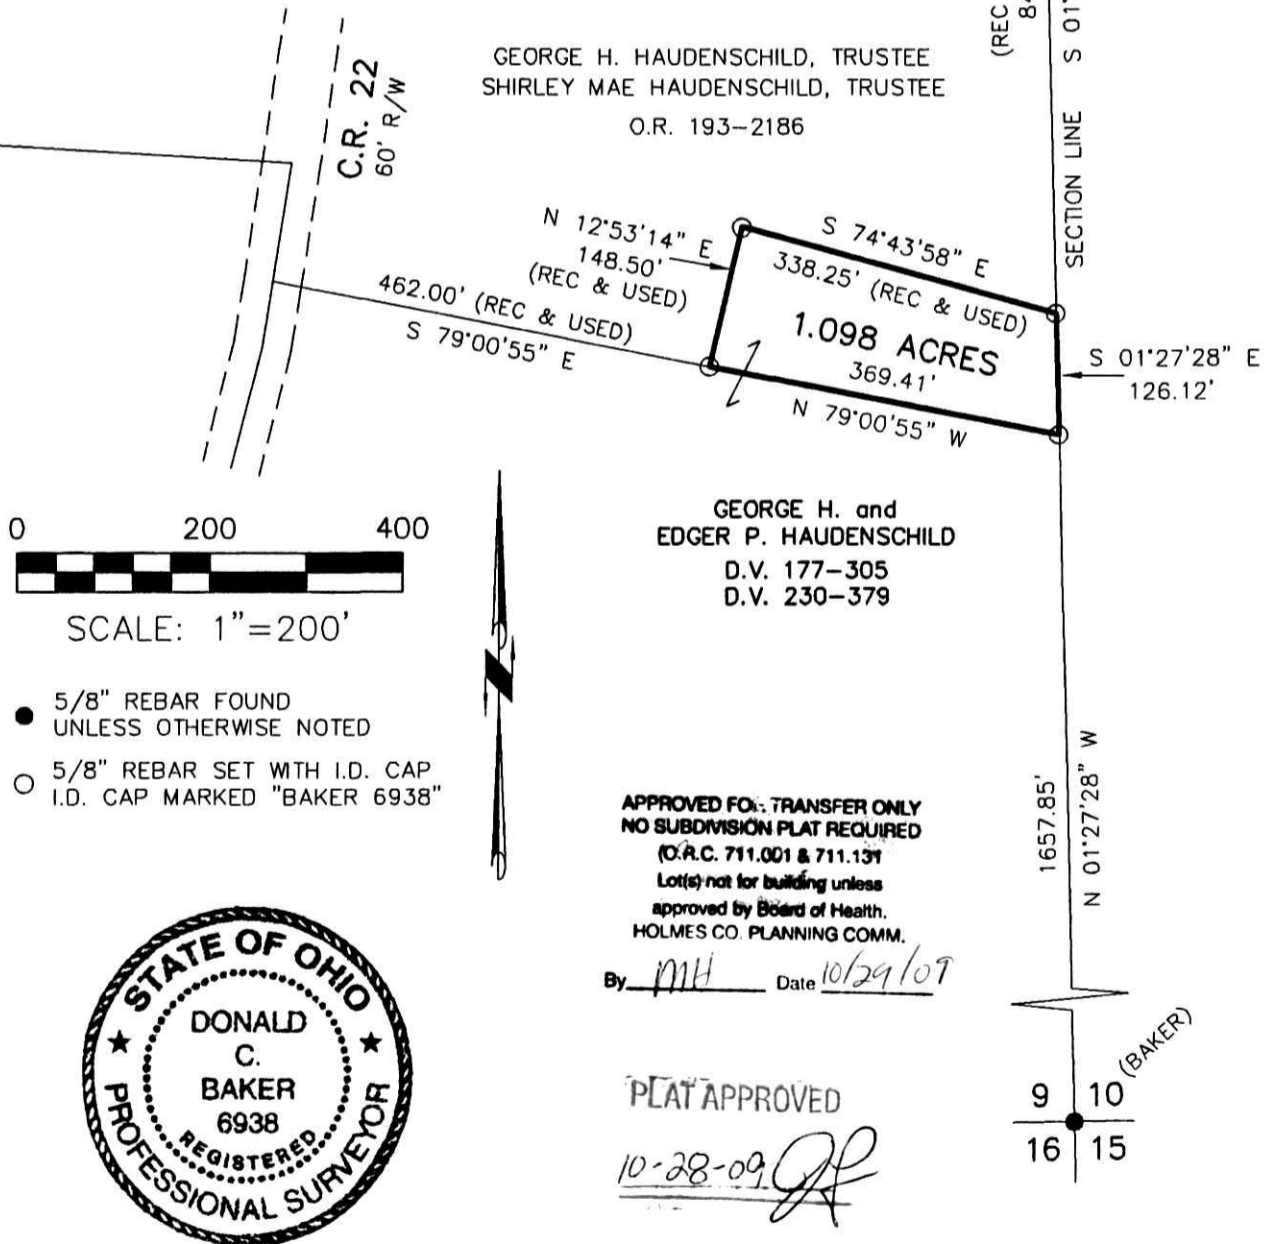

- 5/8" REBAR FOUND UNLESS OTHERWISE NOTED
- 5/8" REBAR SET WITH I.D. CAP I.D. CAP MARKED "BAKER 6938"



GEORGE H. HAUDENSCHILD, TRUSTEE
SHIRLEY MAE HAUDENSCHILD, TRUSTEE
O.R. 193-2186

GEORGE H. and
EDGER P. HAUDENSCHILD
D.V. 177-305
D.V. 230-379

APPROVED FOR: TRANSFER ONLY
NO SUBDIVISION PLAT REQUIRED
(O.R.C. 711.001 & 711.131)
Lot(s) not for building unless
approved by Board of Health.
HOLMES CO. PLANNING COMM.

By MH Date 10/29/09

PLAT APPROVED
10-28-09 *QF*

I CERTIFY THIS SURVEY TO BE CORRECT TO THE BEST OF MY KNOWLEDGE.

Donald C. Baker
DONALD C. BAKER P.S. 6938
DATE: JAN. 19, 2009
KES\ALG-FDB
FILE NAME: WORK4\S-568B-08\ERZ



DONALD C. BAKER SURVEYING
138 N. CLAY STREET
MILLERSBURG, OHIO 44654
PH. 330-674-4788
FAX 330-674-6027