

RETRACEMENT SURVEY OF O.R. 190-225  
 VILLAGE OF MILLERSBURG  
 PART OF OUTLOT 46  
 HARDY TOWNSHIP  
 HOLMES COUNTY, OHIO

SURVEYED FOR: BONNY BRENL



REFERENCES

O.R. VOL. 186 PAGE 1539  
 O.R. VOL. 190 PAGE 225  
 O.R. VOL. 191 PAGE 2406  
 PLAT VOL. 2 PAGE 423  
 PLAT VOL. 19 PAGE 1181  
 BEARINGS FROM PLAT VOL. 19 PAGE 1181

Instrument 200900064578 OR Book Page 19 1619

200900064578  
 Filed for Record in  
 HOLMES COUNTY OH  
 ANITA HALL  
 12-30-2009 AT 10:50 AM  
 SMALL PLAT 40.00  
 OR Book 19 Page 1619 - 1619  
 CRV 215 page 2625

200900064578  
 SAMUEL STEINEL ATTORNEY  
 MILLERSBURG OH 44654

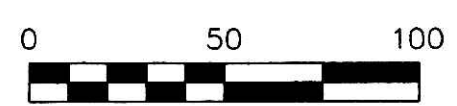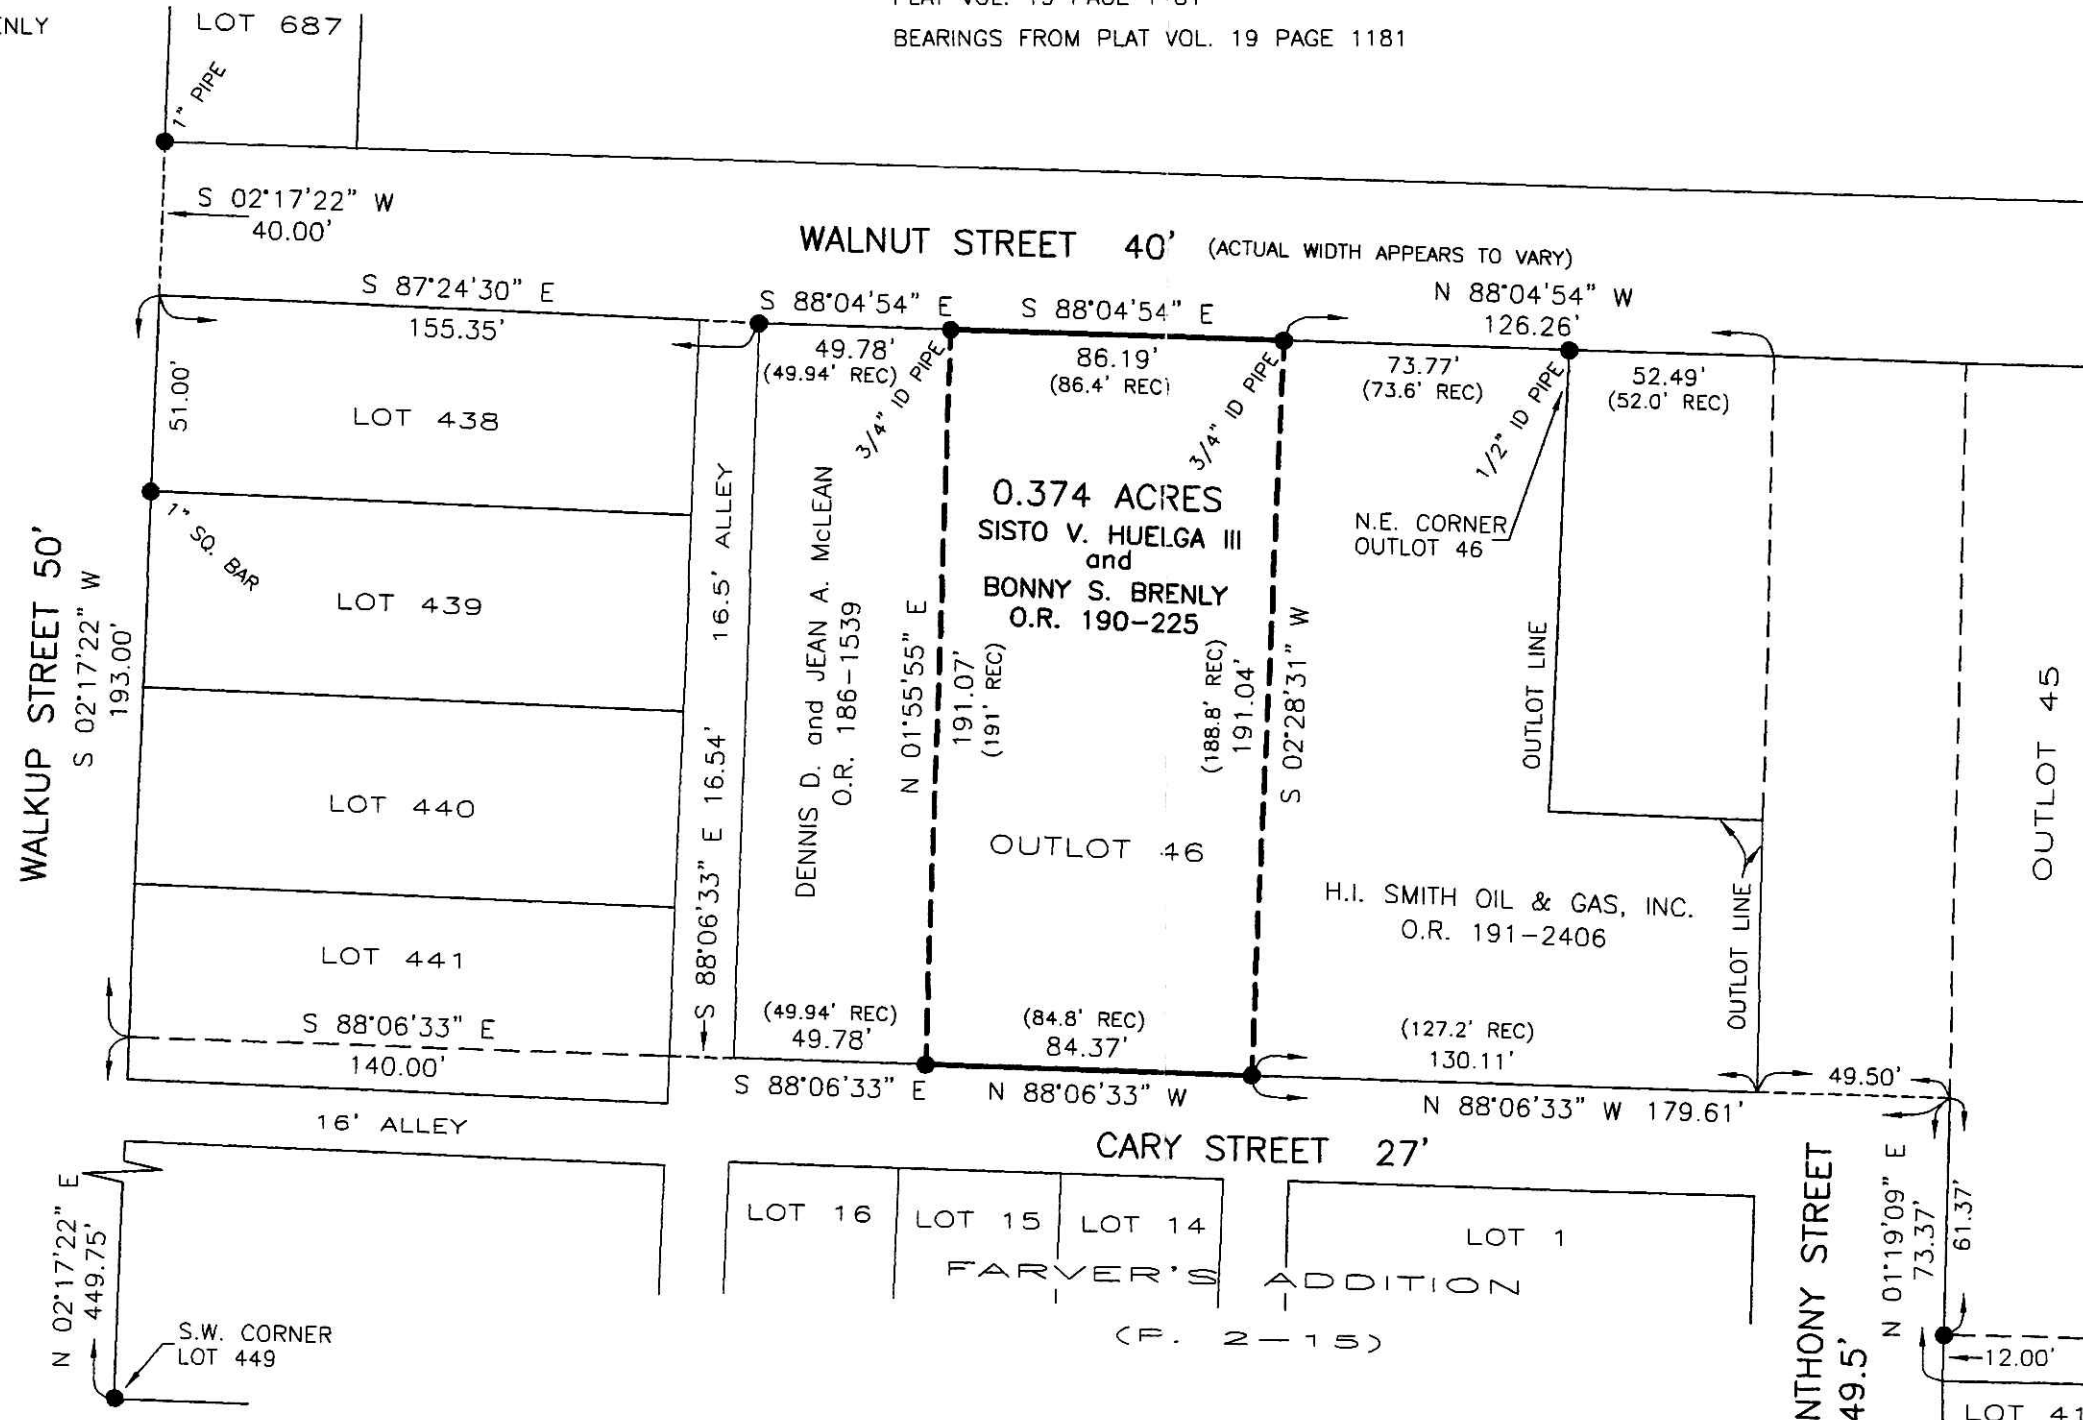

SCALE: 1"=50'  
 ▲ R.R. SPIKE FOUND  
 ● 5/8" REBAR FOUND  
 UNLESS OTHERWISE NOTED



I CERTIFY THIS SURVEY TO BE CORRECT TO THE BEST OF MY KNOWLEDGE.  
 JAMIE D. DARR P.S. 7755  
 DATE: OCT. 15, 2009  
 JDD\ALG-ERZ  
 FILE NAME: WORK3\S-216-08\ERZ

DONALD C. BAKER SURVEYING  
 138 N. CLAY STREET  
 MILLERSBURG, OHIO 44654  
 PH. 330-674-4788  
 FAX 330-674-6027

PLAT APPROVED

12/17/09 *az*