


RETRACEMENT SURVEY OF PARCEL 1 OF O.R. 203-1321
 MECHANIC TOWNSHIP
 N.W. QTR. SECTION 2
 T-8 N; R-6 W
 HOLMES COUNTY, OHIO

SURVEYED FOR: ROBERT A. MILLER


REFERENCES

- DEED VOL. 258 PAGE 648
 - O.R. VOL. 10 PAGE 162
 - O.R. VOL. 72 PAGE 521
 - O.R. VOL. 203 PAGE 1321
 - PLAT VOL. 4 PAGE 7
 - PLAT VOL. 5 PAGES 65 & 78
 - PLAT VOL. 11 PAGE 167
 - PLAT VOL. 17 PAGE 845
 - BEARINGS FROM PLAT VOL. 19 PAGE 1239
- 201000065819
 Filed for Record in
 HOLMES COUNTY, OH
 ANITA HALL, COUNTY RECORDER
 04-09-2010 At 11:33 am.
 SMALL PLAT 40.00
 DR Book 19 Page 1671 - 1671
- OR 217p 1893

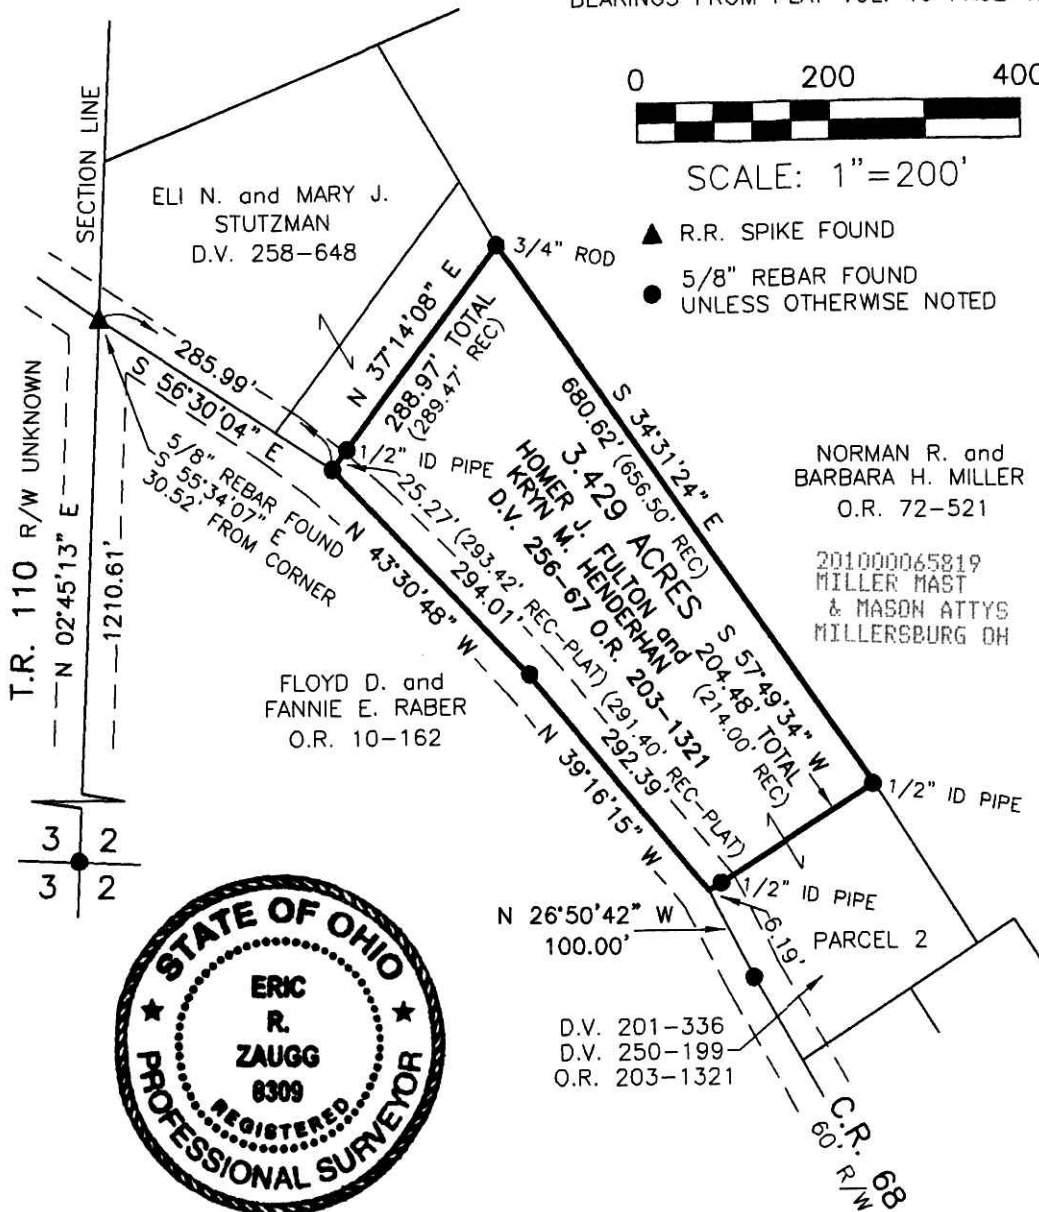

I CERTIFY THIS SURVEY TO BE CORRECT TO THE BEST OF MY KNOWLEDGE.

Eric R. Zaugg
 ERIC R. ZAUGG P.S. 8309
 DATE: MARCH 18, 2010
 ERZ\ALG
 FILE NAME: WORK3\S-74-10\ERZ

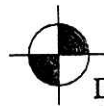

DONALD C. BAKER SURVEYING
 138 N. CLAY STREET
 MILLERSBURG, OHIO 44654
 PH. 330-674-4788
 FAX 330-674-6027

PLAT APPROVED
 3-26-2010 *[Signature]*