


201100071316
FRENCH RIDGE
TITLE
MILLERSBURG OH

RETRACEMENT SURVEY OF O.R. 181-1326
HARDY TOWNSHIP
S.W. QTR. SECTION 14
T-9 N; R-6 W
HOLMES COUNTY, OHIO

SURVEYED FOR: ATTY. LAUREL SCHMID



REFERENCES

- O.R. VOL. 88 PAGE 67
 - O.R. VOL. 181 PAGE 1326
 - O.R. VOL. 186 PAGE 1932
 - O.R. VOL. 223 PAGE 3084
 - PLAT VOL. 2 PAGE 312
 - PLAT VOL. 4 PAGES 62 & 72
 - PLAT VOL. 5 PAGES 9, 73 & 143
 - PLAT VOL. 6 PAGE 120
- BEARINGS FROM PLAT VOL. 2 PAGE 312

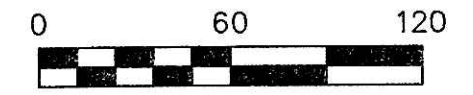

SCALE: 1"=60'

- 5/8" REBAR FOUND UNLESS OTHERWISE NOTED
- 5/8" REBAR SET WITH I.D. CAP I.D. CAP MARKED "BAKER 6938"

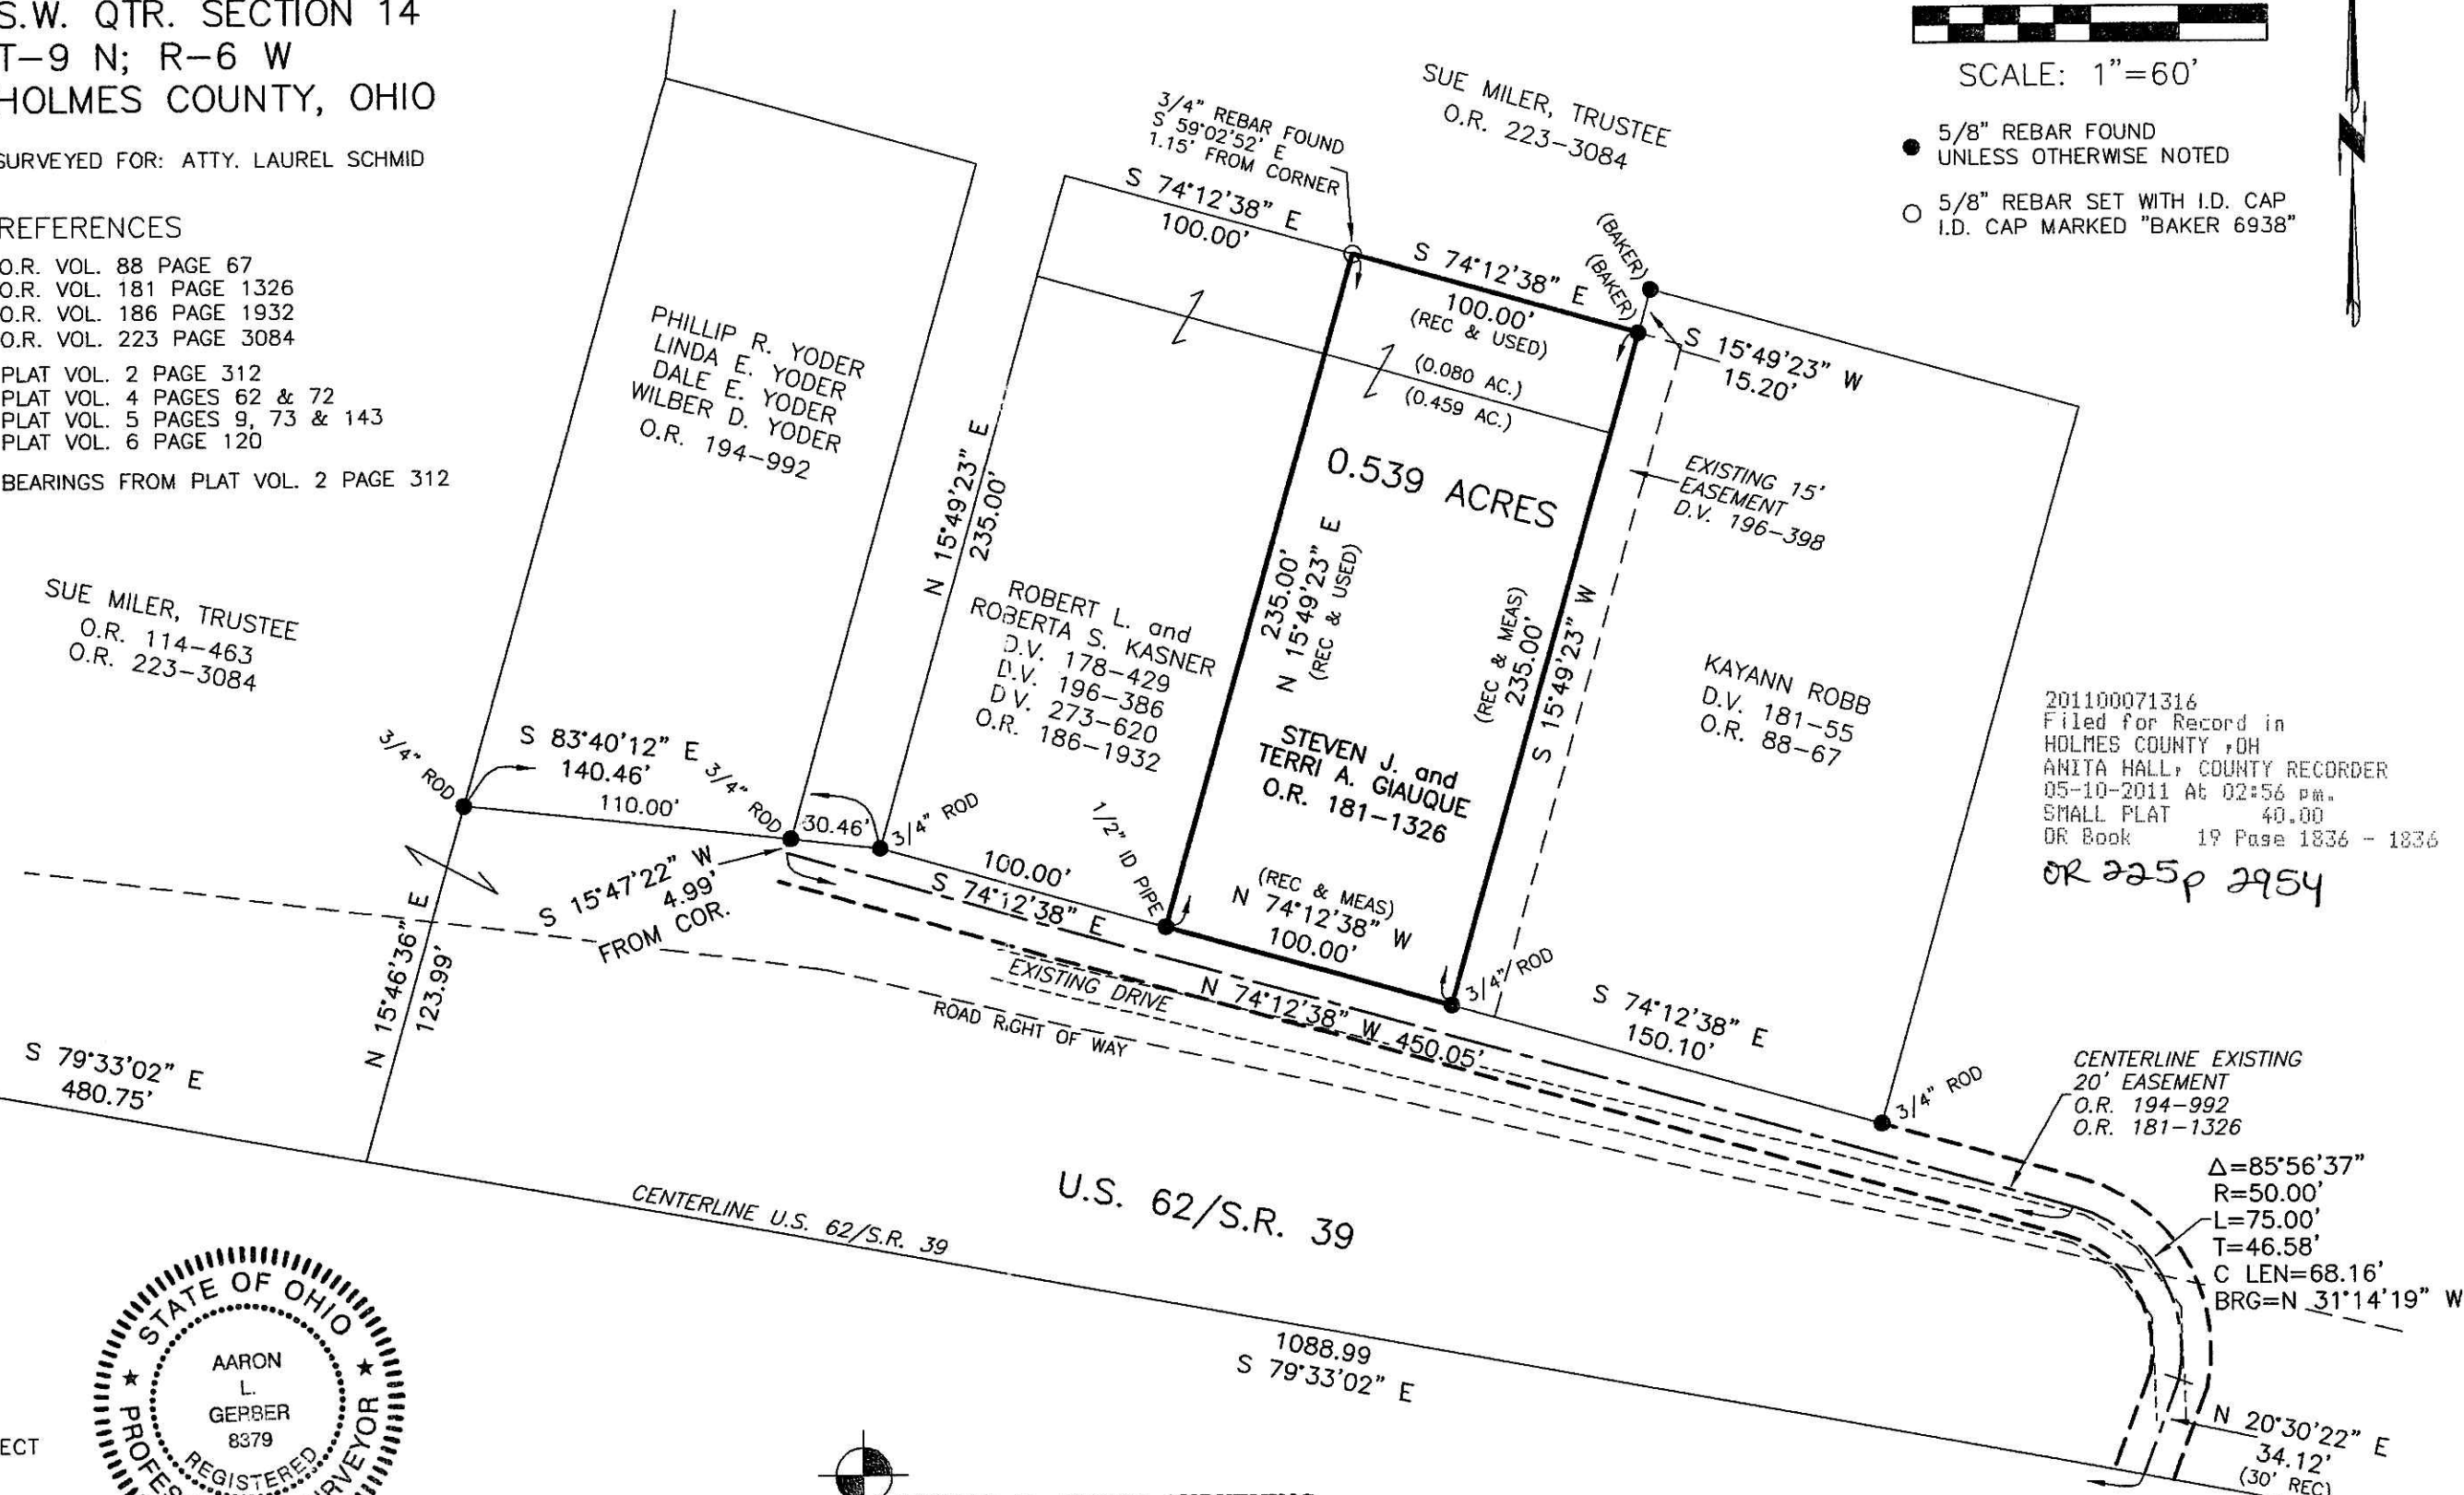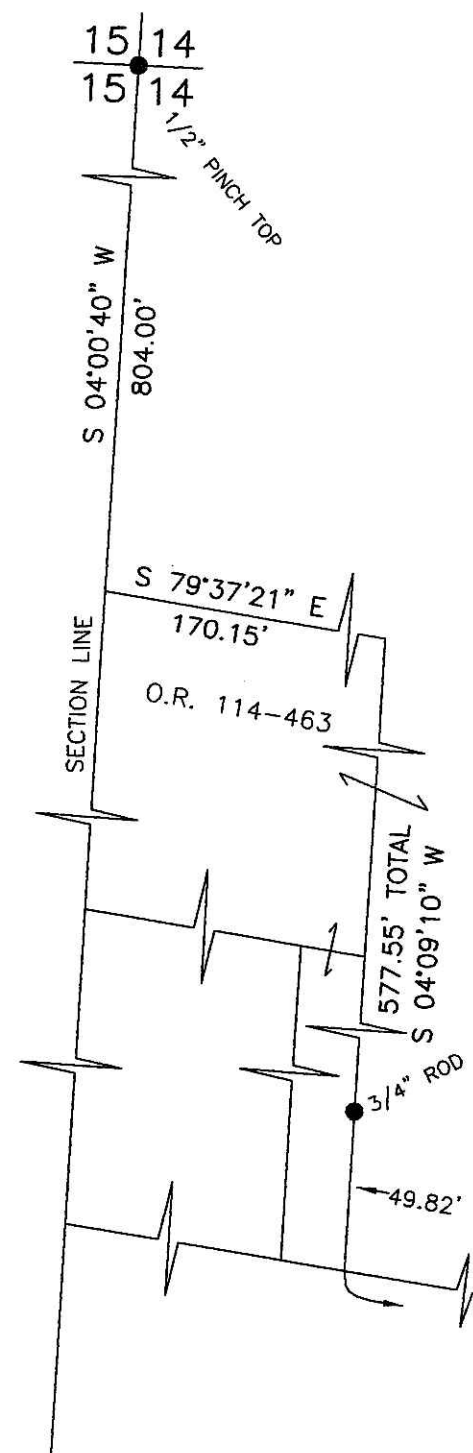


201100071316
Filed for Record in
HOLMES COUNTY, OH
ANITA HALL, COUNTY RECORDER
05-10-2011 At 02:56 pm.
SMALL PLAT 40.00
DR Book 19 Page 1836 - 1836
OR 225p 2954



I CERTIFY THIS SURVEY TO BE CORRECT TO THE BEST OF MY KNOWLEDGE.

A.L.G.
AARON L. GERBER P.S. 8379
DATE: MARCH 11, 2011
ALG\JDD
FILE NAME: WORK3\S-75-11\ERZ

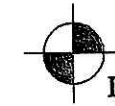

DONALD C. BAKER SURVEYING
138 N. CLAY STREET
MILLERSBURG, OHIO 44654
PH. 330-674-4788
FAX 330-674-6027

PLAT APPROVED

3/29/2011