


VILLAGE OF MILLERSBURG  
 LOT 207  
 PART OF LOT 678  
 HOLMES COUNTY, OHIO


SURVEYED FOR: ROBERT FAIR FAMILY

201100071806  
 Filed for Record in  
 HOLMES COUNTY, OH  
 ANITA HALL, COUNTY RECORDER  
 06-09-2011 At 03:50 pm.  
 SMALL PLAT 40.00  
 OR Book 19 Page 1850 - 1850  
 ORV 226 page 2175

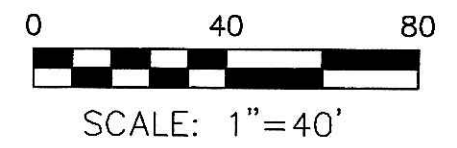

REFERENCES  
 DEED VOL. 279 PAGE 949  
 O.R. VOL. 217 PAGE 1607  
 O.R. VOL. 219 PAGE 2905  
 S.R. 4 - 96  
 BEARINGS FROM PLAT VOL. 19 PAGE 1056

- 5/8" REBAR FOUND UNLESS OTHERWISE NOTED
- 5/8" REBAR SET WITH I.D. CAP I.D. CAP MARKED "BAKER 6938"

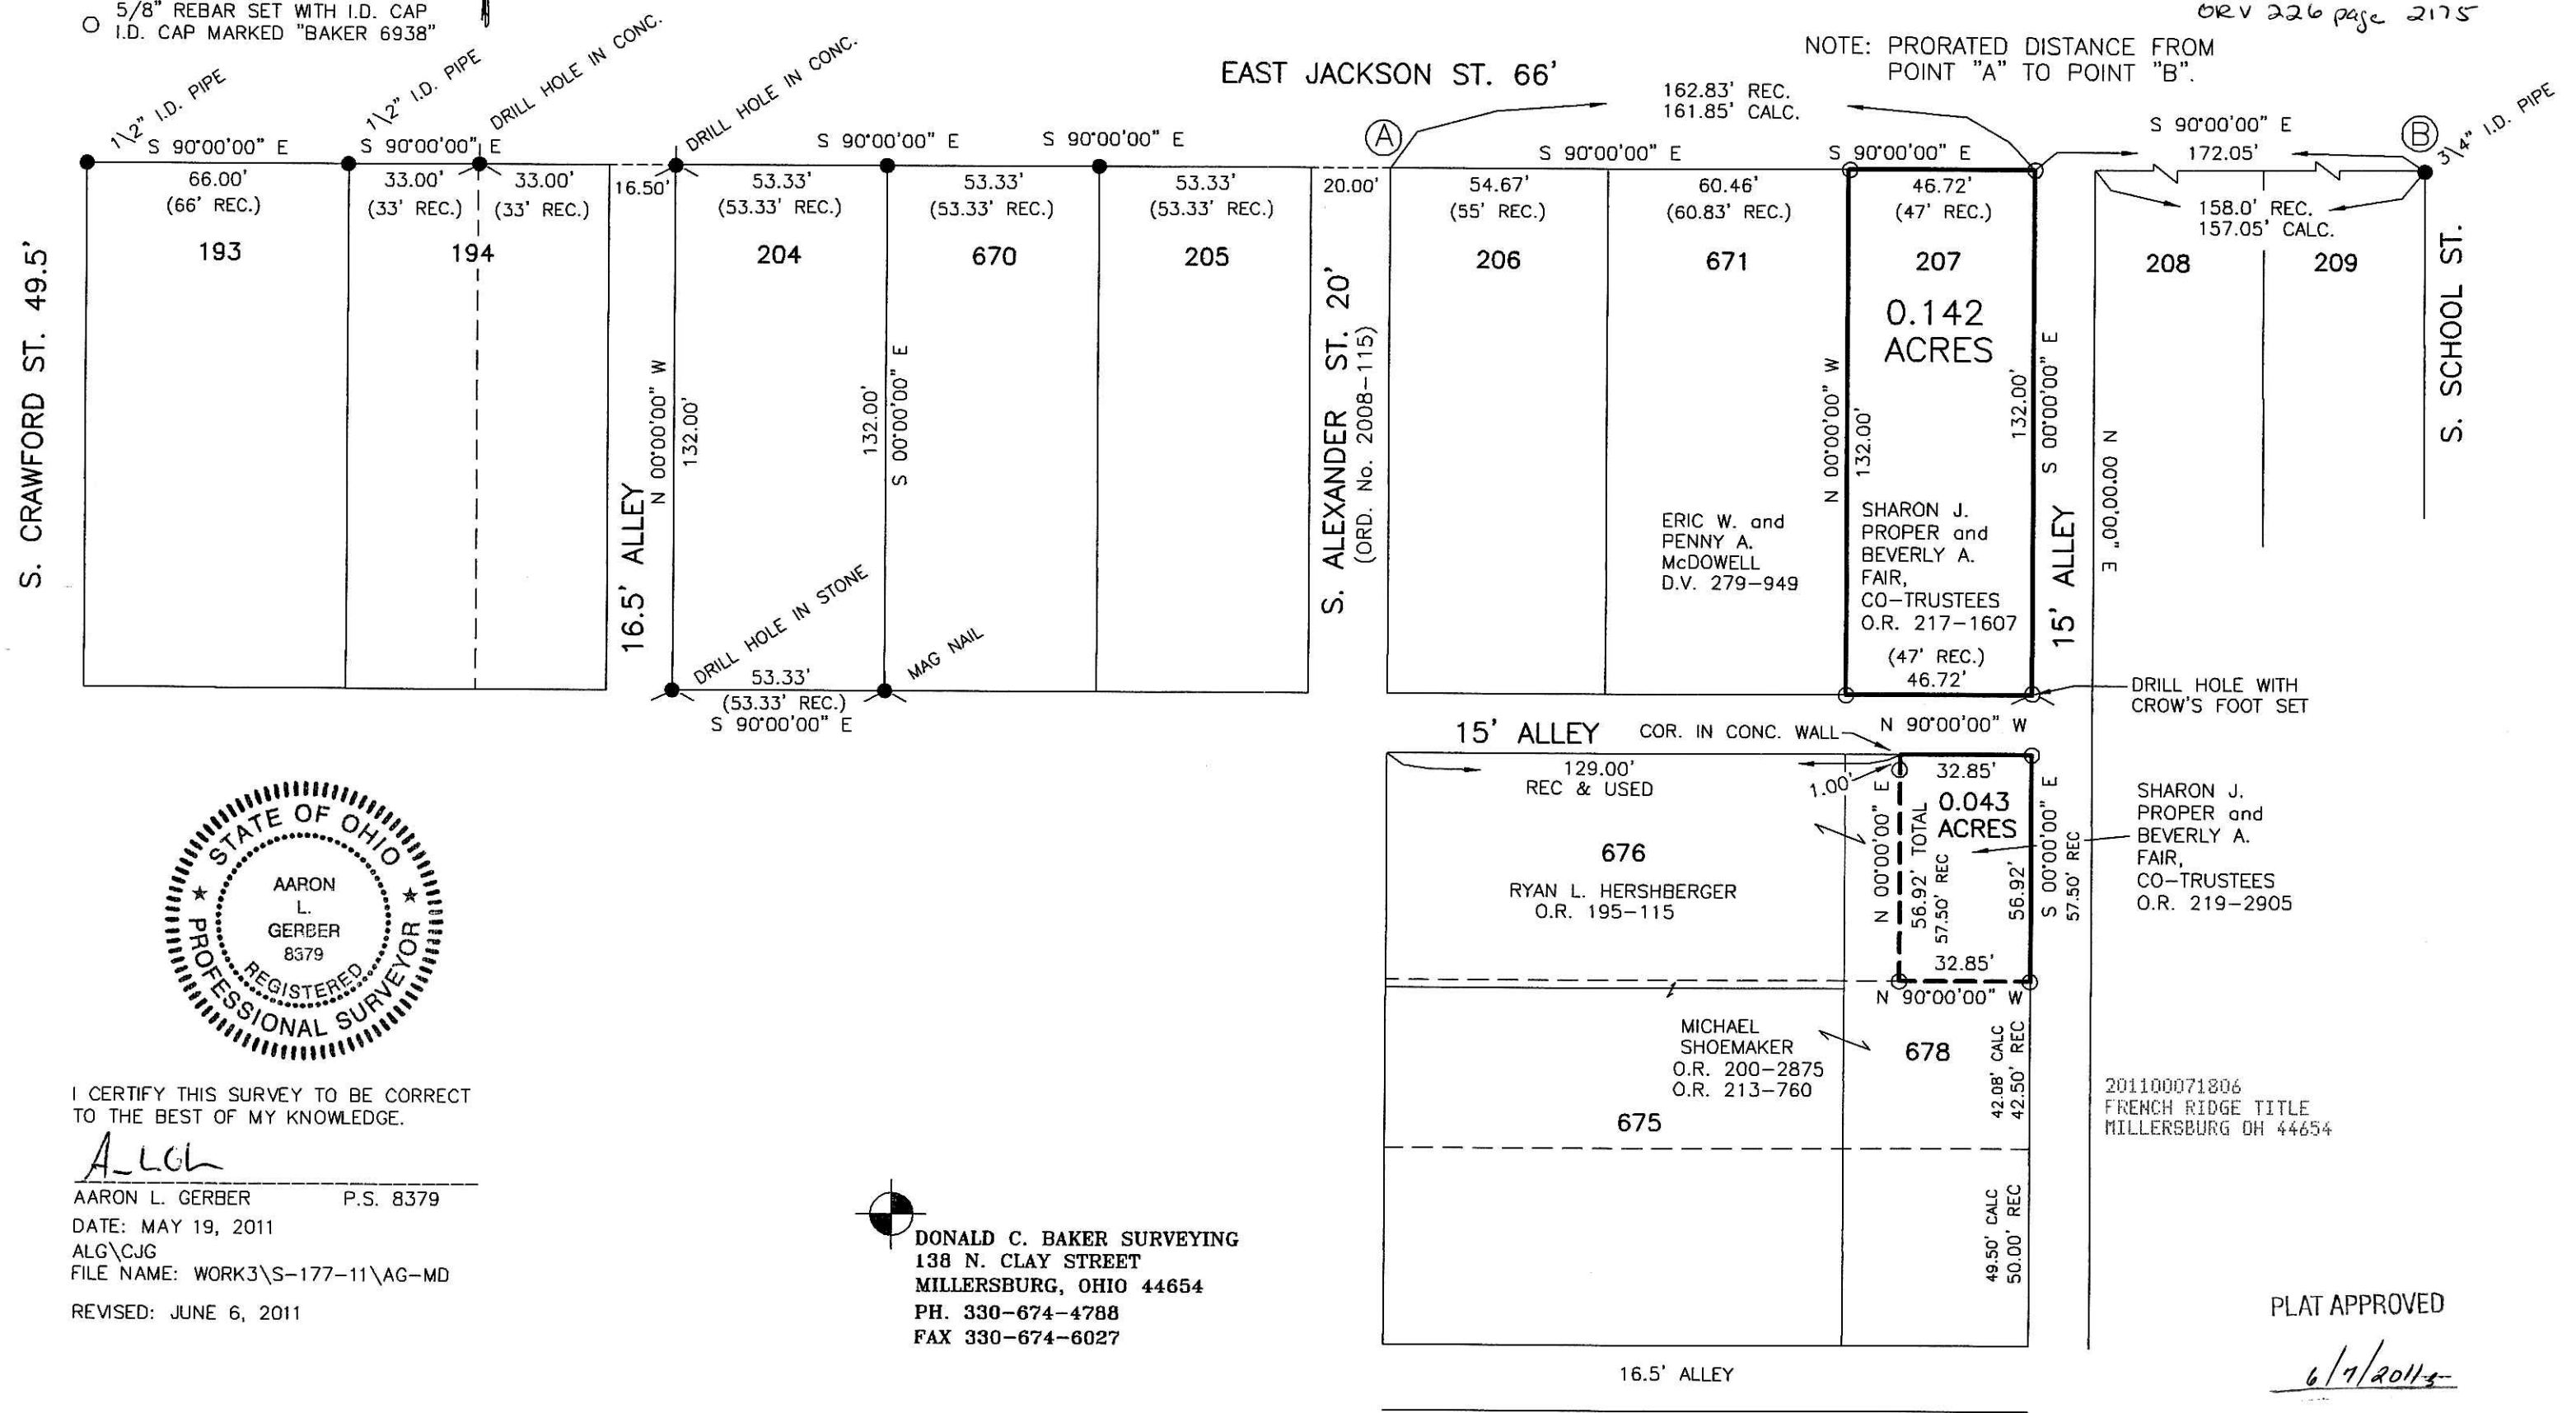

NOTE: PRORATED DISTANCE FROM POINT "A" TO POINT "B".



I CERTIFY THIS SURVEY TO BE CORRECT TO THE BEST OF MY KNOWLEDGE.

*ALG*  
 AARON L. GERBER P.S. 8379  
 DATE: MAY 19, 2011  
 ALG\CJG  
 FILE NAME: WORK3\S-177-11\AG-MD  
 REVISED: JUNE 6, 2011

DONALD C. BAKER SURVEYING  
 138 N. CLAY STREET  
 MILLERSBURG, OHIO 44654  
 PH. 330-674-4788  
 FAX 330-674-6027

201100071806  
 FRENCH RIDGE TITLE  
 MILLERSBURG OH 44654

PLAT APPROVED

*6/7/2011*