

RETRACEMENT SURVEY OF D.V. 279-930
 VILLAGE OF MILLERSBURG
 PART OF OUTLOT 84
 HOLMES COUNTY, OHIO

SURVEYED FOR: KATHY WRIGHT-LAWHEAD



REFERENCES

- DEED VOL. 265 PAGES 122 & 403
- DEED VOL. 279 PAGE 930
- O.R. VOL. 224 PAGE 3277
- PLAT VOL. 5 PAGE 86
- PLAT VOL. 14 PAGE 549
- BEARINGS FROM PLAT VOL. 14 PAGE 549



I CERTIFY THIS SURVEY TO BE CORRECT TO THE BEST OF MY KNOWLEDGE.

E. R. Zaugg
 ERIC R. ZAUGG P.S. 8309
 DATE: JUNE 15, 2011
 ALG\CJG
 FILE NAME: WORK3\S-257-11\ERZ

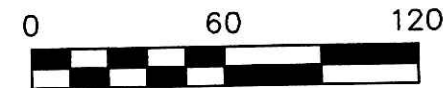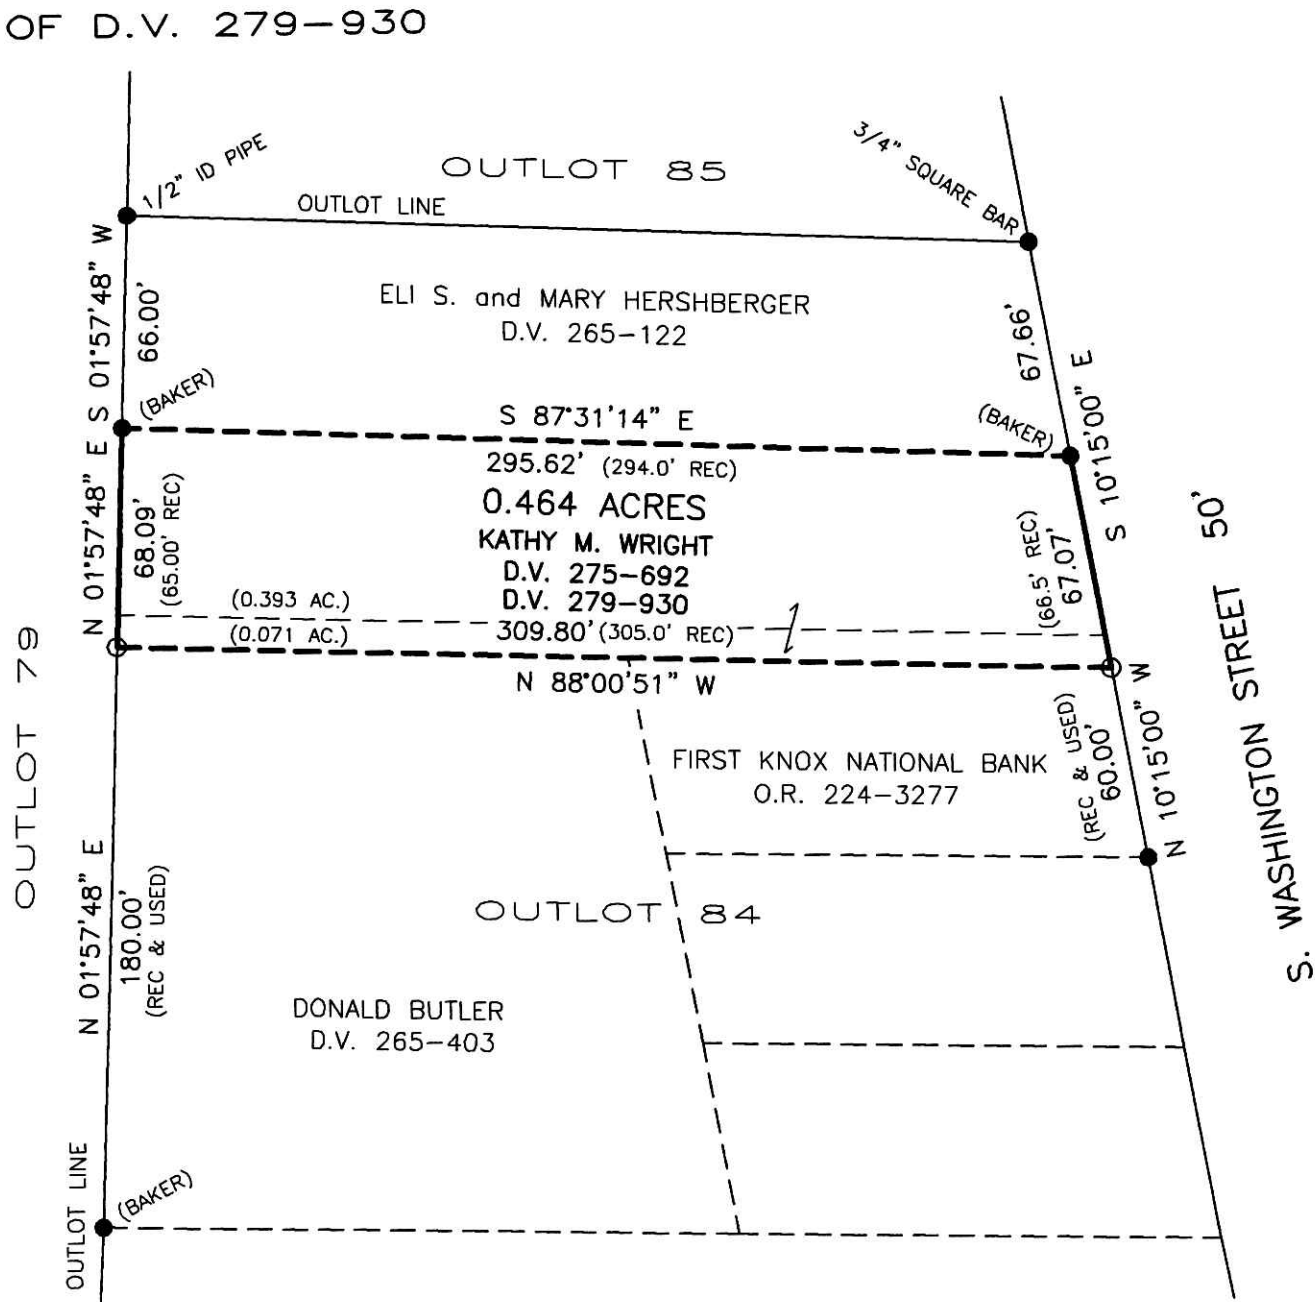

SCALE: 1"=60'

- 5/8" REBAR FOUND UNLESS OTHERWISE NOTED
- 5/8" REBAR SET WITH I.D. CAP. I.D. CAP MARKED "BAKER 6938"

201100072071
 Filed for Record in
 HOLMES COUNTY, OH
 ANITA HALL, COUNTY RECORDER
 06-30-2011 At 01:37 pm.
 SMALL PLAT 40.00
 OR Book 19 Page 1861 - 1861
 ORV 226 pg 3442

APPROVED FOR TRANSFER ONLY
 NO SUBDIVISION PLAT REQUIRED
 (O.R.C. 711. 711.131
 Lot(s) not for record unless
 approved by Board of Health.
 HOLMES CO. PLANNING COMM.
 By JB Date 6-27-11

201100072071
 SERVICE FIRST TITLE AGENCY LTD
 WOOSTER OH 44691

DONALD C. BAKER SURVEYING
 138 N. CLAY STREET
 MILLERSBURG, OHIO 44654
 PH. 330-674-4788
 FAX 330-674-6027

PLAT APPROVED

6/22/2011