


RETRACEMENT SURVEY OF D.V. 158-555,
D.V. 159-246 & D.V. 160-13

Instrument 201100072623 OR Book Page 19 1877

CLARK TOWNSHIP
N.E. QTR. SECTION 16
T-8 N; R-4 W
HOLMES COUNTY, OHIO

201100072623
Filed for Record in
HOLMES COUNTY, OH
ANITA HALL, COUNTY RECORDER
08-11-2011 At 10:06 am.
SMALL PLAT 40.00
OR Book 19 Page 1877 - 1877
ORV 227 pg 2668

SURVEYED FOR: LAURA D. MILLER

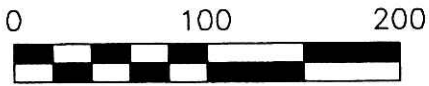


SCALE: 1"=100'

- ▲ R.R. SPIKE FOUND
- 5/8" REBAR FOUND UNLESS OTHERWISE NOTED
- 5/8" REBAR SET WITH I.D. CAP I.D. CAP MARKED "BAKER 6938"

REFERENCES

- DEED VOL. 159 PAGE 246
- DEED VOL. 158 PAGE 555
- DEED VOL. 160 PAGE 13
- DEED VOL. 204 PAGE 403
- DEED VOL. 225 PAGE 17
- O.R. VOL. 123 PAGE 446
- PLAT VOL. 4 PAGE 106
- BEARINGS FROM PLAT VOL. 2 PAGE 365

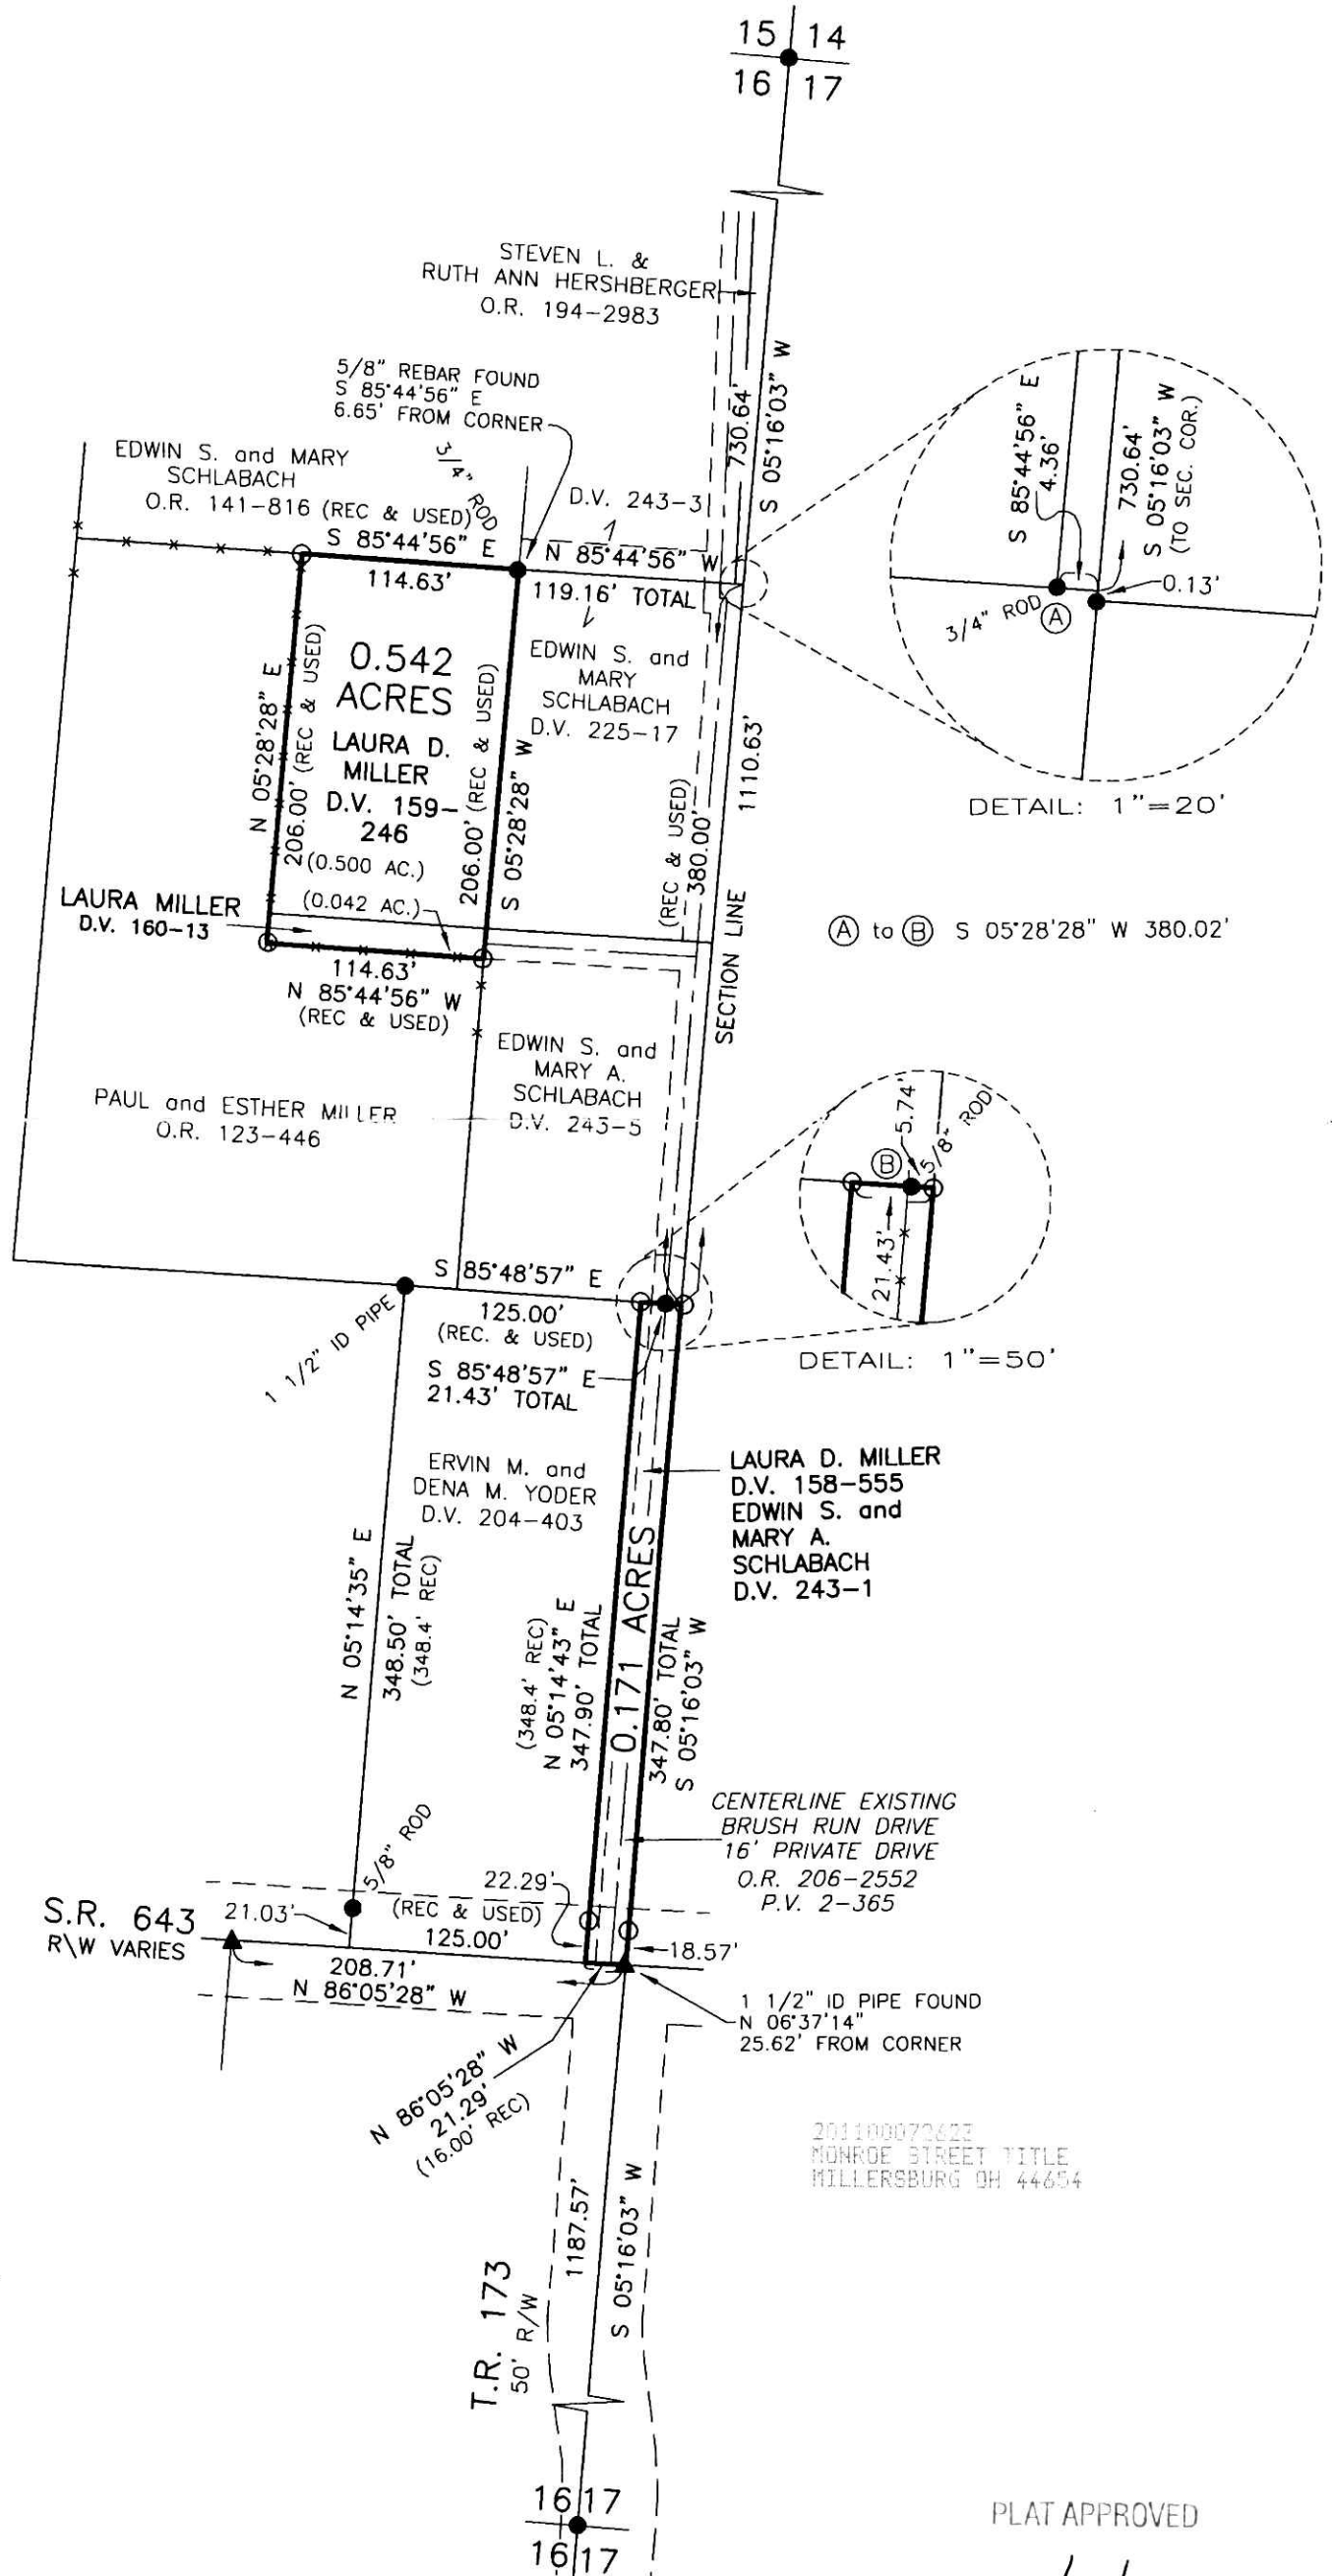

APPROVED FOR TRANSFER ONLY
NO SURVEYING PLAT REQUIRED
(O.R.C. 711.02 & 711.131)
Lot(s) not for record unless
approved by Board of Health,
HOLMES CO. PLANNING COMM.
By *JB* Date *7-26-11*



I CERTIFY THIS SURVEY TO BE CORRECT
TO THE BEST OF MY KNOWLEDGE.
Eric R. Zaugg
ERIC R. ZAUGG P.S. 8309
DATE: JUNE 27, 2011
ERZ\FDB
FILE NAME: WORK3\S-286-11\MLD-ERZ

DONALD C. BAKER SURVEYING
138 N. CLAY STREET
MILLERSBURG, OHIO 44654
PH. 330-674-4788
FAX 330-674-6027

PLAT APPROVED
7/25/2011