



SCALE: 1"=200'

- STONE FOUND
- ▲ R.R. SPIKE FOUND
- 5/8" REBAR FOUND UNLESS OTHERWISE NOTED
- 5/8" REBAR SET WITH I.D. CAP I.D. CAP MARKED "BAKER 6938"



I CERTIFY THIS SURVEY TO BE CORRECT TO THE BEST OF MY KNOWLEDGE.

Donald C. Baker
 DONALD C. BAKER P.S. 6938
 DATE: OCT 25, 2011
 FDB\KES
 FILE NAME: WORK4\S-464-11\MLD

DONALD C. BAKER SURVEYING
 138 N. CLAY STREET
 MILLERSBURG, OHIO 44654
 PH. 330-674-4788
 FAX 330-674-6027

REFERENCES


- O.R. VOL. 23 PAGE 268
- O.R. VOL. 59 PAGE 732
- O.R. VOL. 201 PAGE 1634
- P.V. 17 PAGE 648
- P.V. 19 PAGE 1206
- P.V. 16 PAGE 571
- P.V. 5 PAGE 128
- BEARINGS FROM PLAT VOL. 17 PAGE 648

RICHLAND TOWNSHIP
 N.E. QTR. SECTION 15
 T-8 N; R-8 W
 HOLMES COUNTY, OHIO

SURVEYED FOR: DAVE KAUFMAN REALTY

201100074189
 Filed for Record in
 HOLMES COUNTY, OH
 ANITA HALL, COUNTY RECORDER
 11-23-2011 At 12:09 pm.
 SMALL PLAT 40.00
 DR Book 19 Page 1957 - 1957

OR 229 p 3489

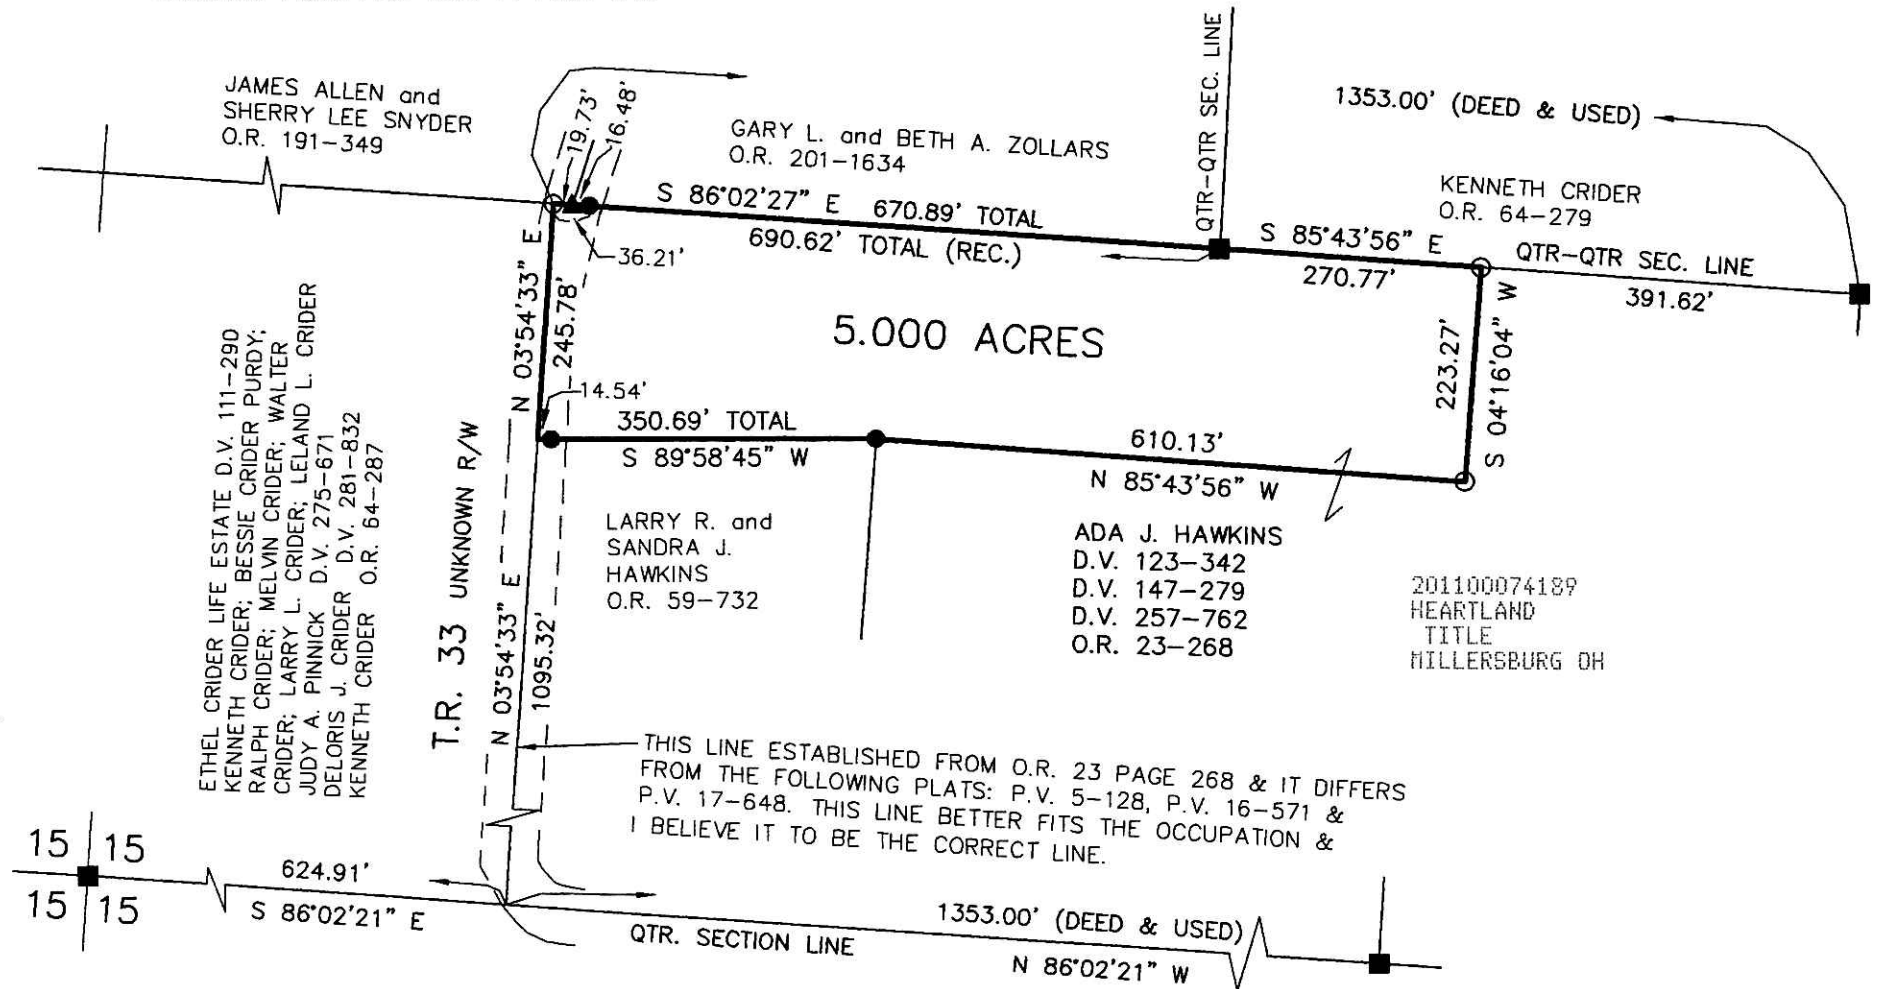

201100074189
 HEARTLAND
 TITLE
 MILLERSBURG OH

PLAT APPROVED

11/10/2011