


WASHINGTON TOWNSHIP  
S.E. QTR. SECTION 13  
T-19 N; R-15 W  
HOLMES COUNTY, OHIO

201200078631  
BARNARD LAW OFFICES  
P.O. BOX 1041  
WOOSTER OH 44691

201200078631  
Filed for Record in  
HOLMES COUNTY, OH  
ANITA HALL, COUNTY RECORDER  
07-23-2012 At 10:29 am.  
SMALL PLAT 40.00  
OR Book 19 Page 2099 - 2099  
**OR 236 p 1587**

SURVEYED FOR: JOHN BRIDENTHAL

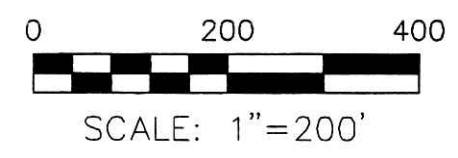

- STONE FOUND
- ▲ R.R. SPIKE FOUND
- 5/8" REBAR FOUND  
UNLESS OTHERWISE NOTED
- 5/8" REBAR SET WITH I.D. CAP  
I.D. CAP MARKED "BAKER 6938"

REFERENCES

- DEED VOL. 262 PAGE 1
- O.R. VOL. 20 PAGE 431
- O.R. VOL. 233 PAGE 1497
- O.R. VOL. 233 PAGE 1499
- O.R. VOL. 233 PAGE 1488
- O.R. VOL. 49 PAGE 377

- PLAT VOL. 8 PAGE 269
- PLAT VOL. 15 PAGE 11
- PLAT VOL. 17 PAGE 438
- PLAT VOL. 19 PAGE 2045


BEARINGS FROM PLAT VOL. 15 PAGE 11



I CERTIFY THIS SURVEY TO BE CORRECT  
TO THE BEST OF MY KNOWLEDGE.

*Donald C. Baker*  
DONALD C. BAKER P.S. 6938  
DATE: MAY 21, 2012  
FDB\CG  
FILE NAME: WORK4\S-241-12

DONALD C. BAKER SURVEYING  
138 N. CLAY STREET  
MILLERSBURG, OHIO 44654  
PH. 330-674-4788  
FAX 330-674-6027

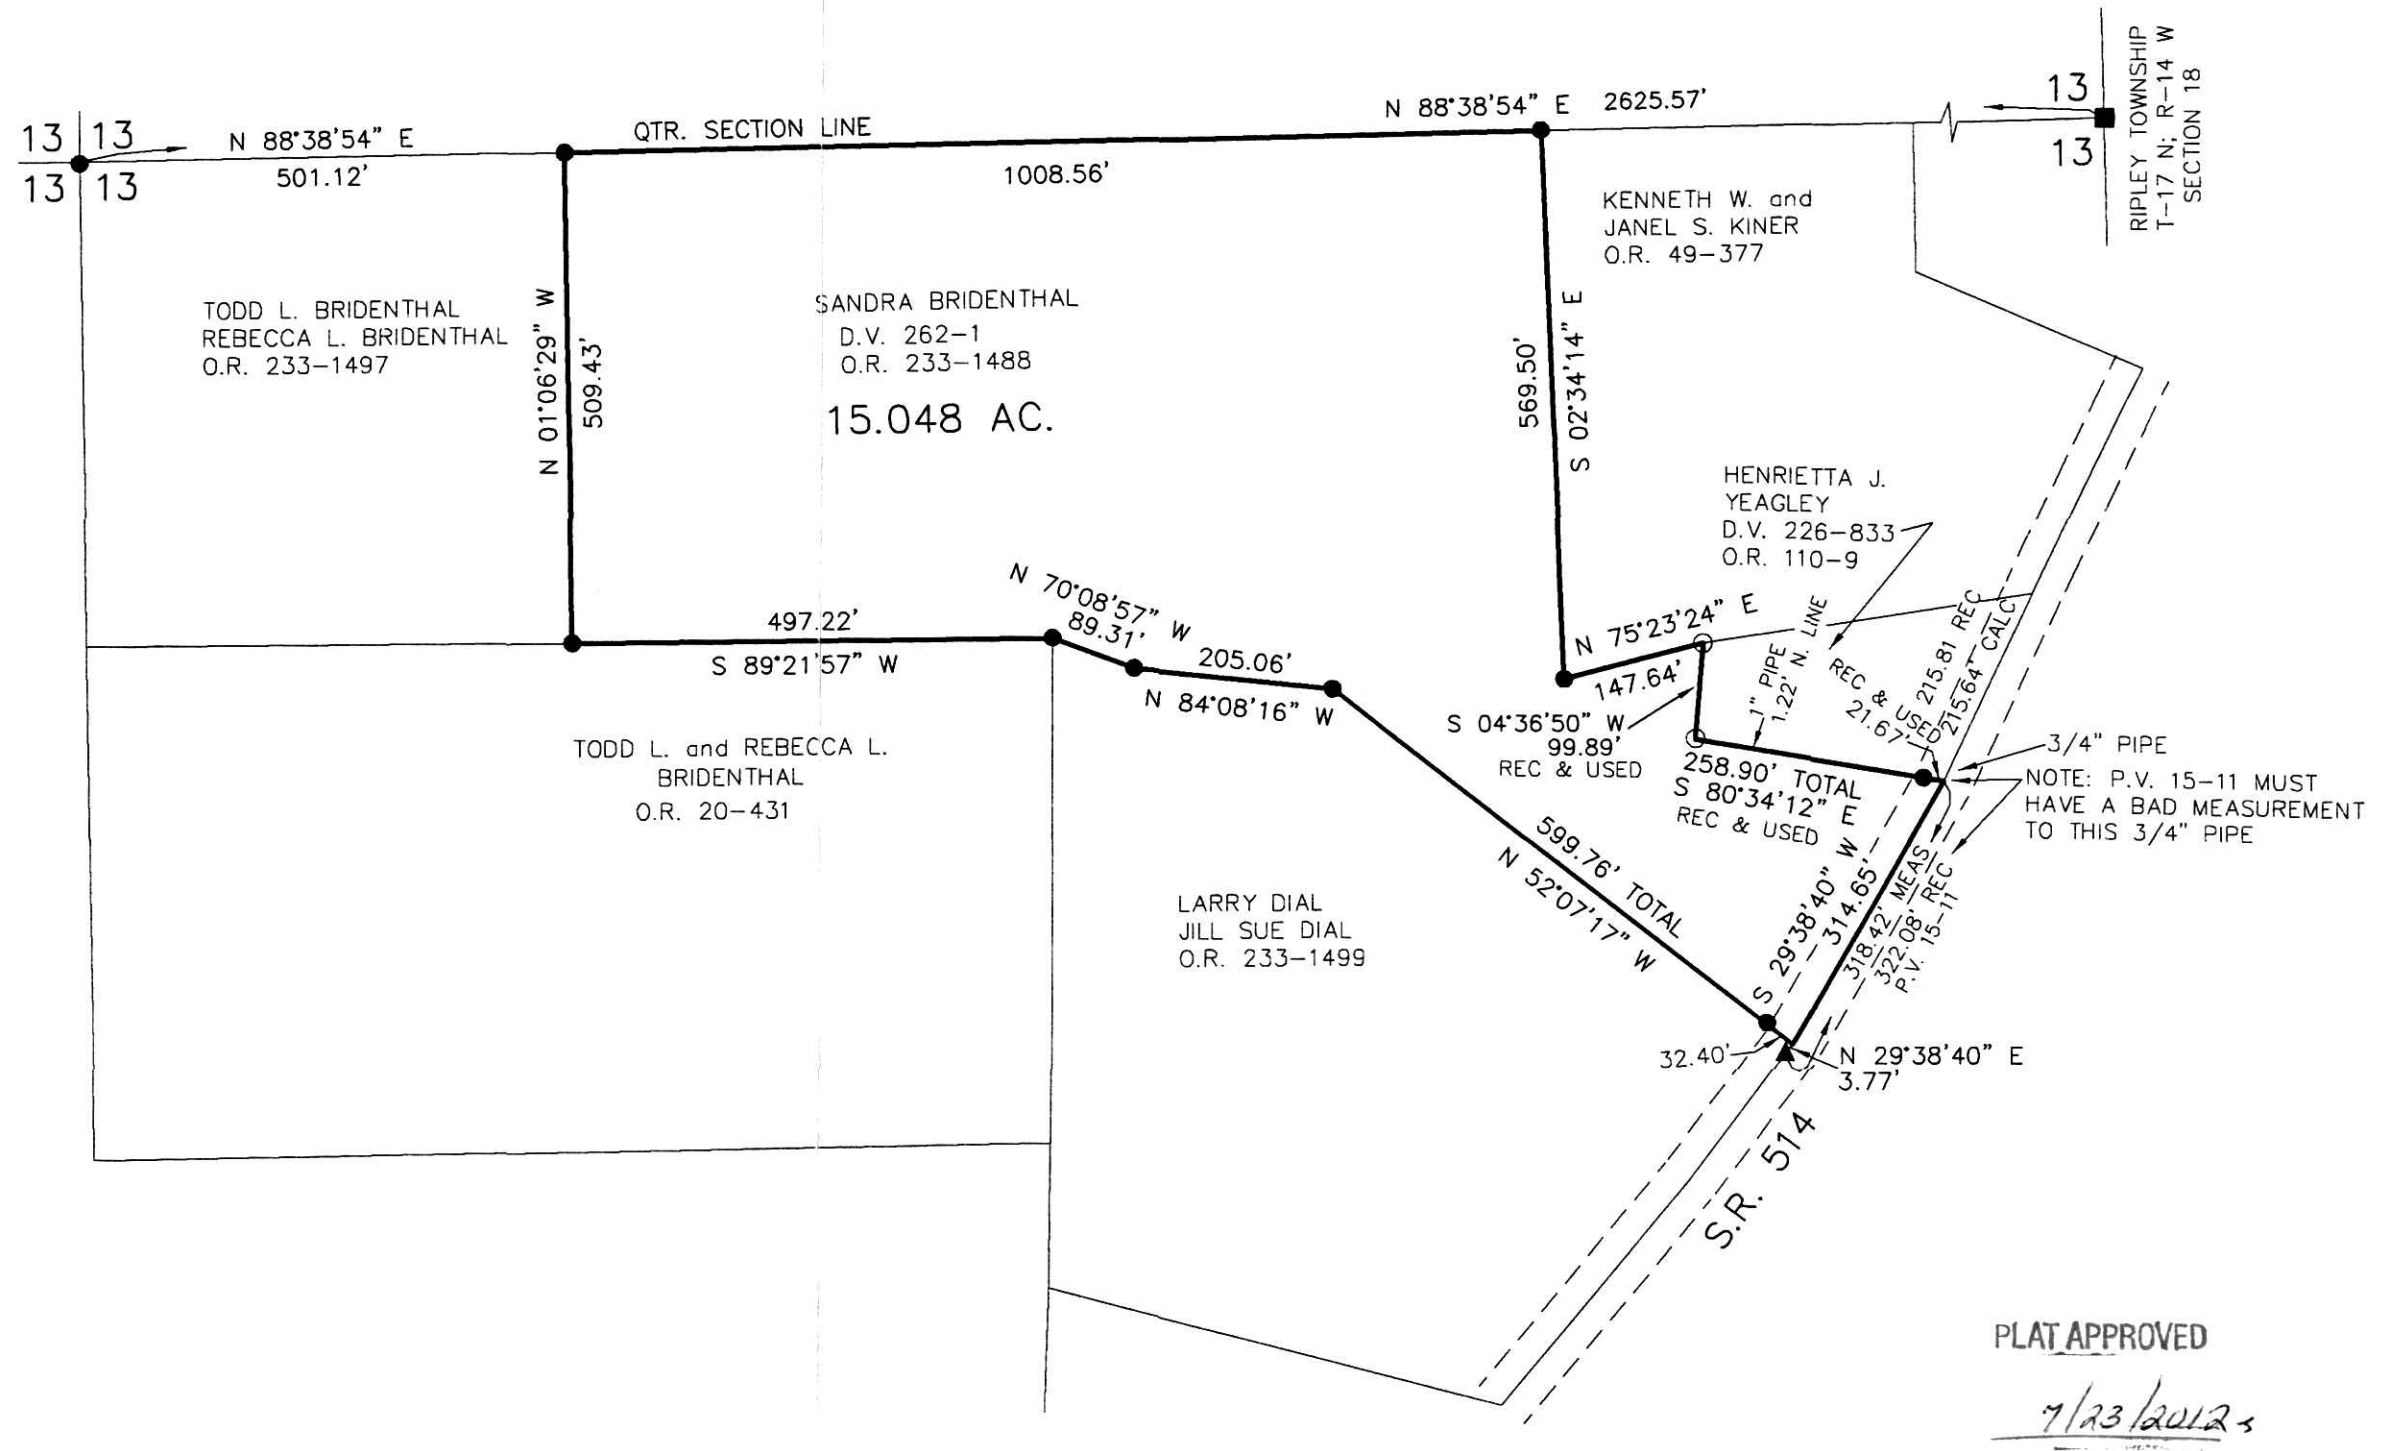

PLAT APPROVED  
*7/23/2012*