

KNOX TOWNSHIP
 S.W. QTR. SECTION 24
 FRACTIONAL SECTION 25
 T-19 N, R-15 W
 FIRST QTR., LOTS 12 & 13
 T-9 N; R-9 W
 HOLMES COUNTY, OHIO

SURVEYED FOR: DONNA J. SMETZER

REFERENCES


DEED VOL. 266 PAGE 138
 DEED VOL. 158 PAGE 516
 DEED VOL. 277 PAGE 787
 O.R. VOL. 81 PAGE 698
 O.R. VOL. 180 PAGE 994
 O.R. VOL. 212 PAGE 2412
 PLAT VOL. 14 PAGE 617
 BEARINGS FROM PLAT VOL. 14 PAGE 617

H.I. SMITH OIL & GAS, INC.
 O.R. 212-2412

Ⓐ UNKNOWN (MARY E. CLINE?) D.V. 97-339

Ⓢ DEED OVERLAP

Instrument 201200079862 OR Book Page 19 2105

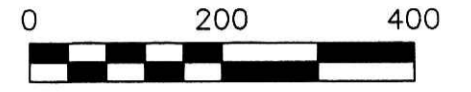


SCALE: 1"=200'

- STONE FOUND
- ▲ R.R. SPIKE FOUND
- 5/8" REBAR FOUND UNLESS OTHERWISE NOTED
- 5/8" REBAR SET WITH I.D. CAP I.D. CAP MARKED "BAKER 6938"

201200079862
 Filed for Record in
 HOLMES COUNTY, OH
 ANITA HALL, COUNTY RECORDER
 08-06-2012 At 02:51 pm
 PLAT MED 43.20
 OR Book 19 Page 2105 - 2105
 OR 236p 2744

201200079862
 CRITCHFIELD, ...
 & JOHNSTON ATTYS
 MILLERSBURG OH

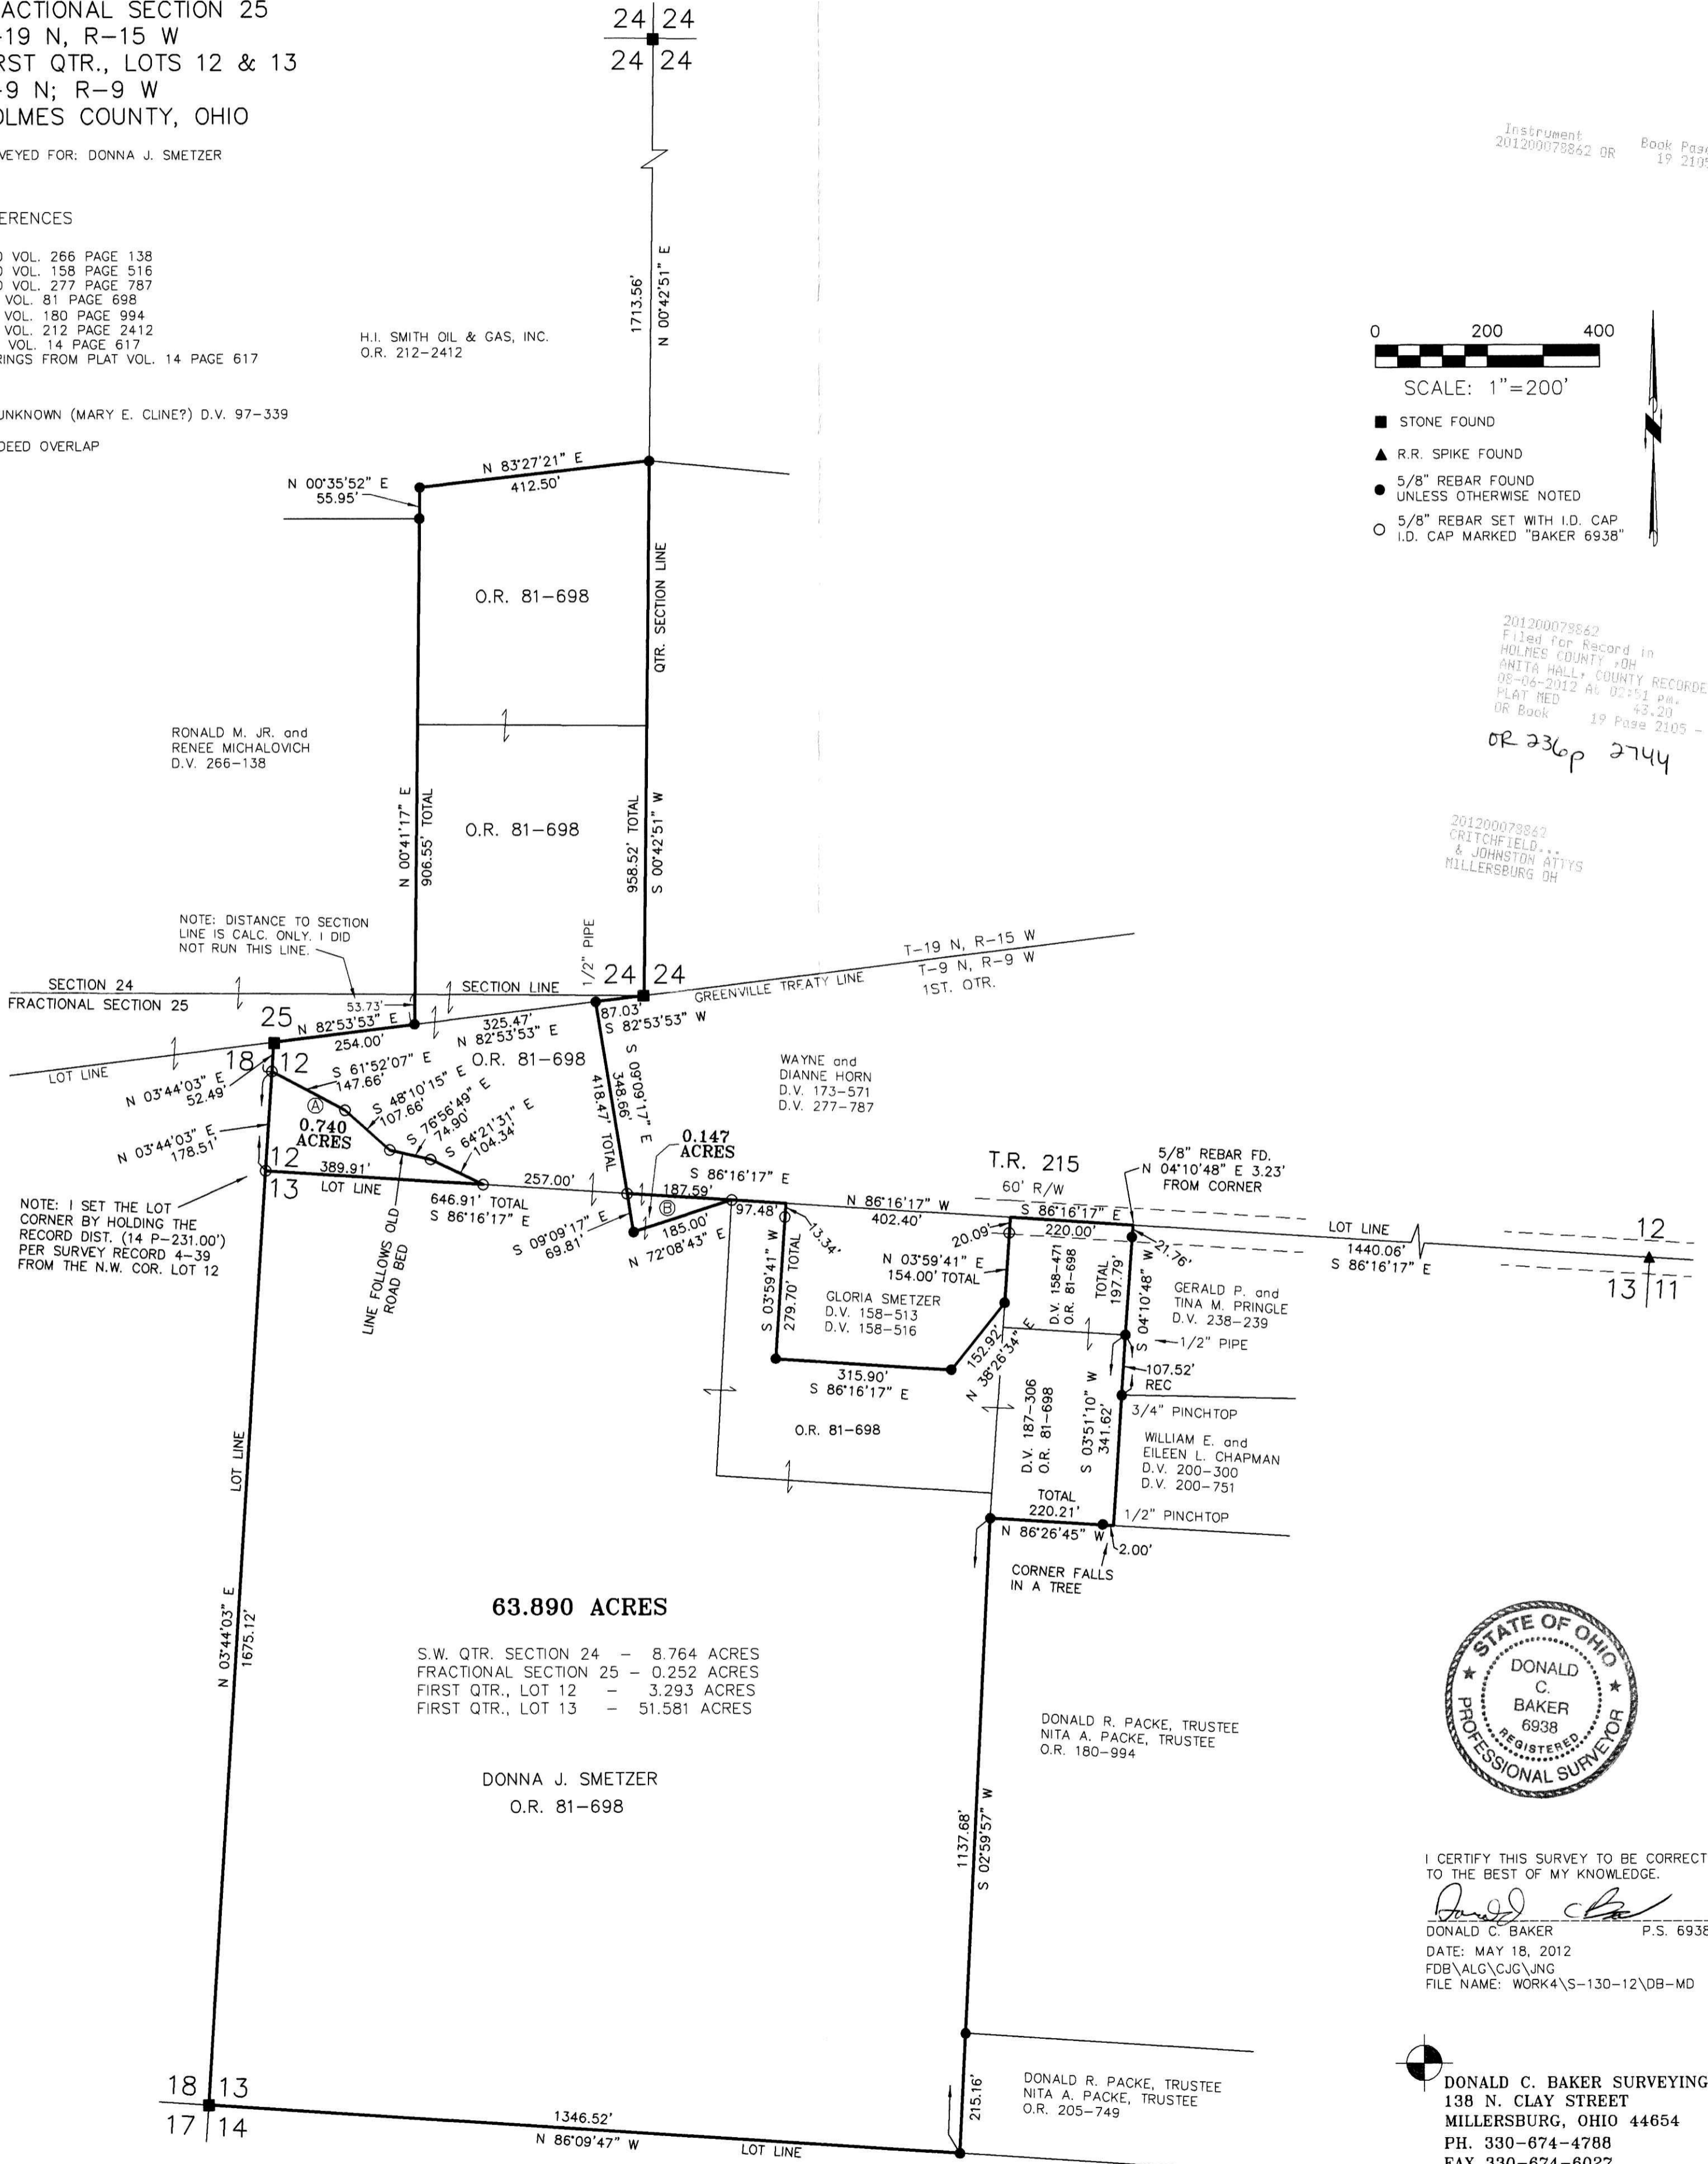

63.890 ACRES

S.W. QTR. SECTION 24 - 8.764 ACRES
 FRACTIONAL SECTION 25 - 0.252 ACRES
 FIRST QTR., LOT 12 - 3.293 ACRES
 FIRST QTR., LOT 13 - 51.581 ACRES

DONNA J. SMETZER
 O.R. 81-698

DONALD R. PACKE, TRUSTEE
 NITA A. PACKE, TRUSTEE
 O.R. 180-994

DONALD R. PACKE, TRUSTEE
 NITA A. PACKE, TRUSTEE
 O.R. 205-749



I CERTIFY THIS SURVEY TO BE CORRECT TO THE BEST OF MY KNOWLEDGE.

Donald C. Baker
 DONALD C. BAKER P.S. 6938

DATE: MAY 18, 2012
 FDB\ALG\CJG\JNG
 FILE NAME: WORK4\S-130-12\DB-MD

DONALD C. BAKER SURVEYING
 138 N. CLAY STREET
 MILLERSBURG, OHIO 44654
 PH. 330-674-4788
 FAX 330-674-6027

PLAT APPROVED

7/31/2012