



- ✕ SPIKE FOUND
- 5/8" REBAR W/ I.D. CAP FOUND 'SHAMP'
- ✕ MONUMENT SPIKE SET
- 5/8" REBAR SET WITH I.D. CAP MARKED SJL INC

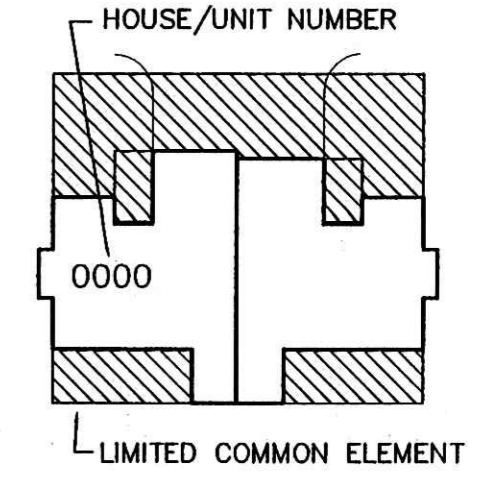

201200079687
 Filed for Record in
 HOLMES COUNTY, OH
 ANITA HALL, COUNTY RECORDER
 09-25-2012 AT 04:04 PM
 PLAT MED 43.20
 OR Book 19 Page 2133 - 2133
 OR 238 pg 302

LOT 1052 15.605 AC.
 - PHASE 1 0.905 AC.
 - PHASE 2 0.319 AC.
 RESIDUE 14.381 AC.

201200079687
 HEARTLAND TITLE
 MILLERSBURG OH 4465

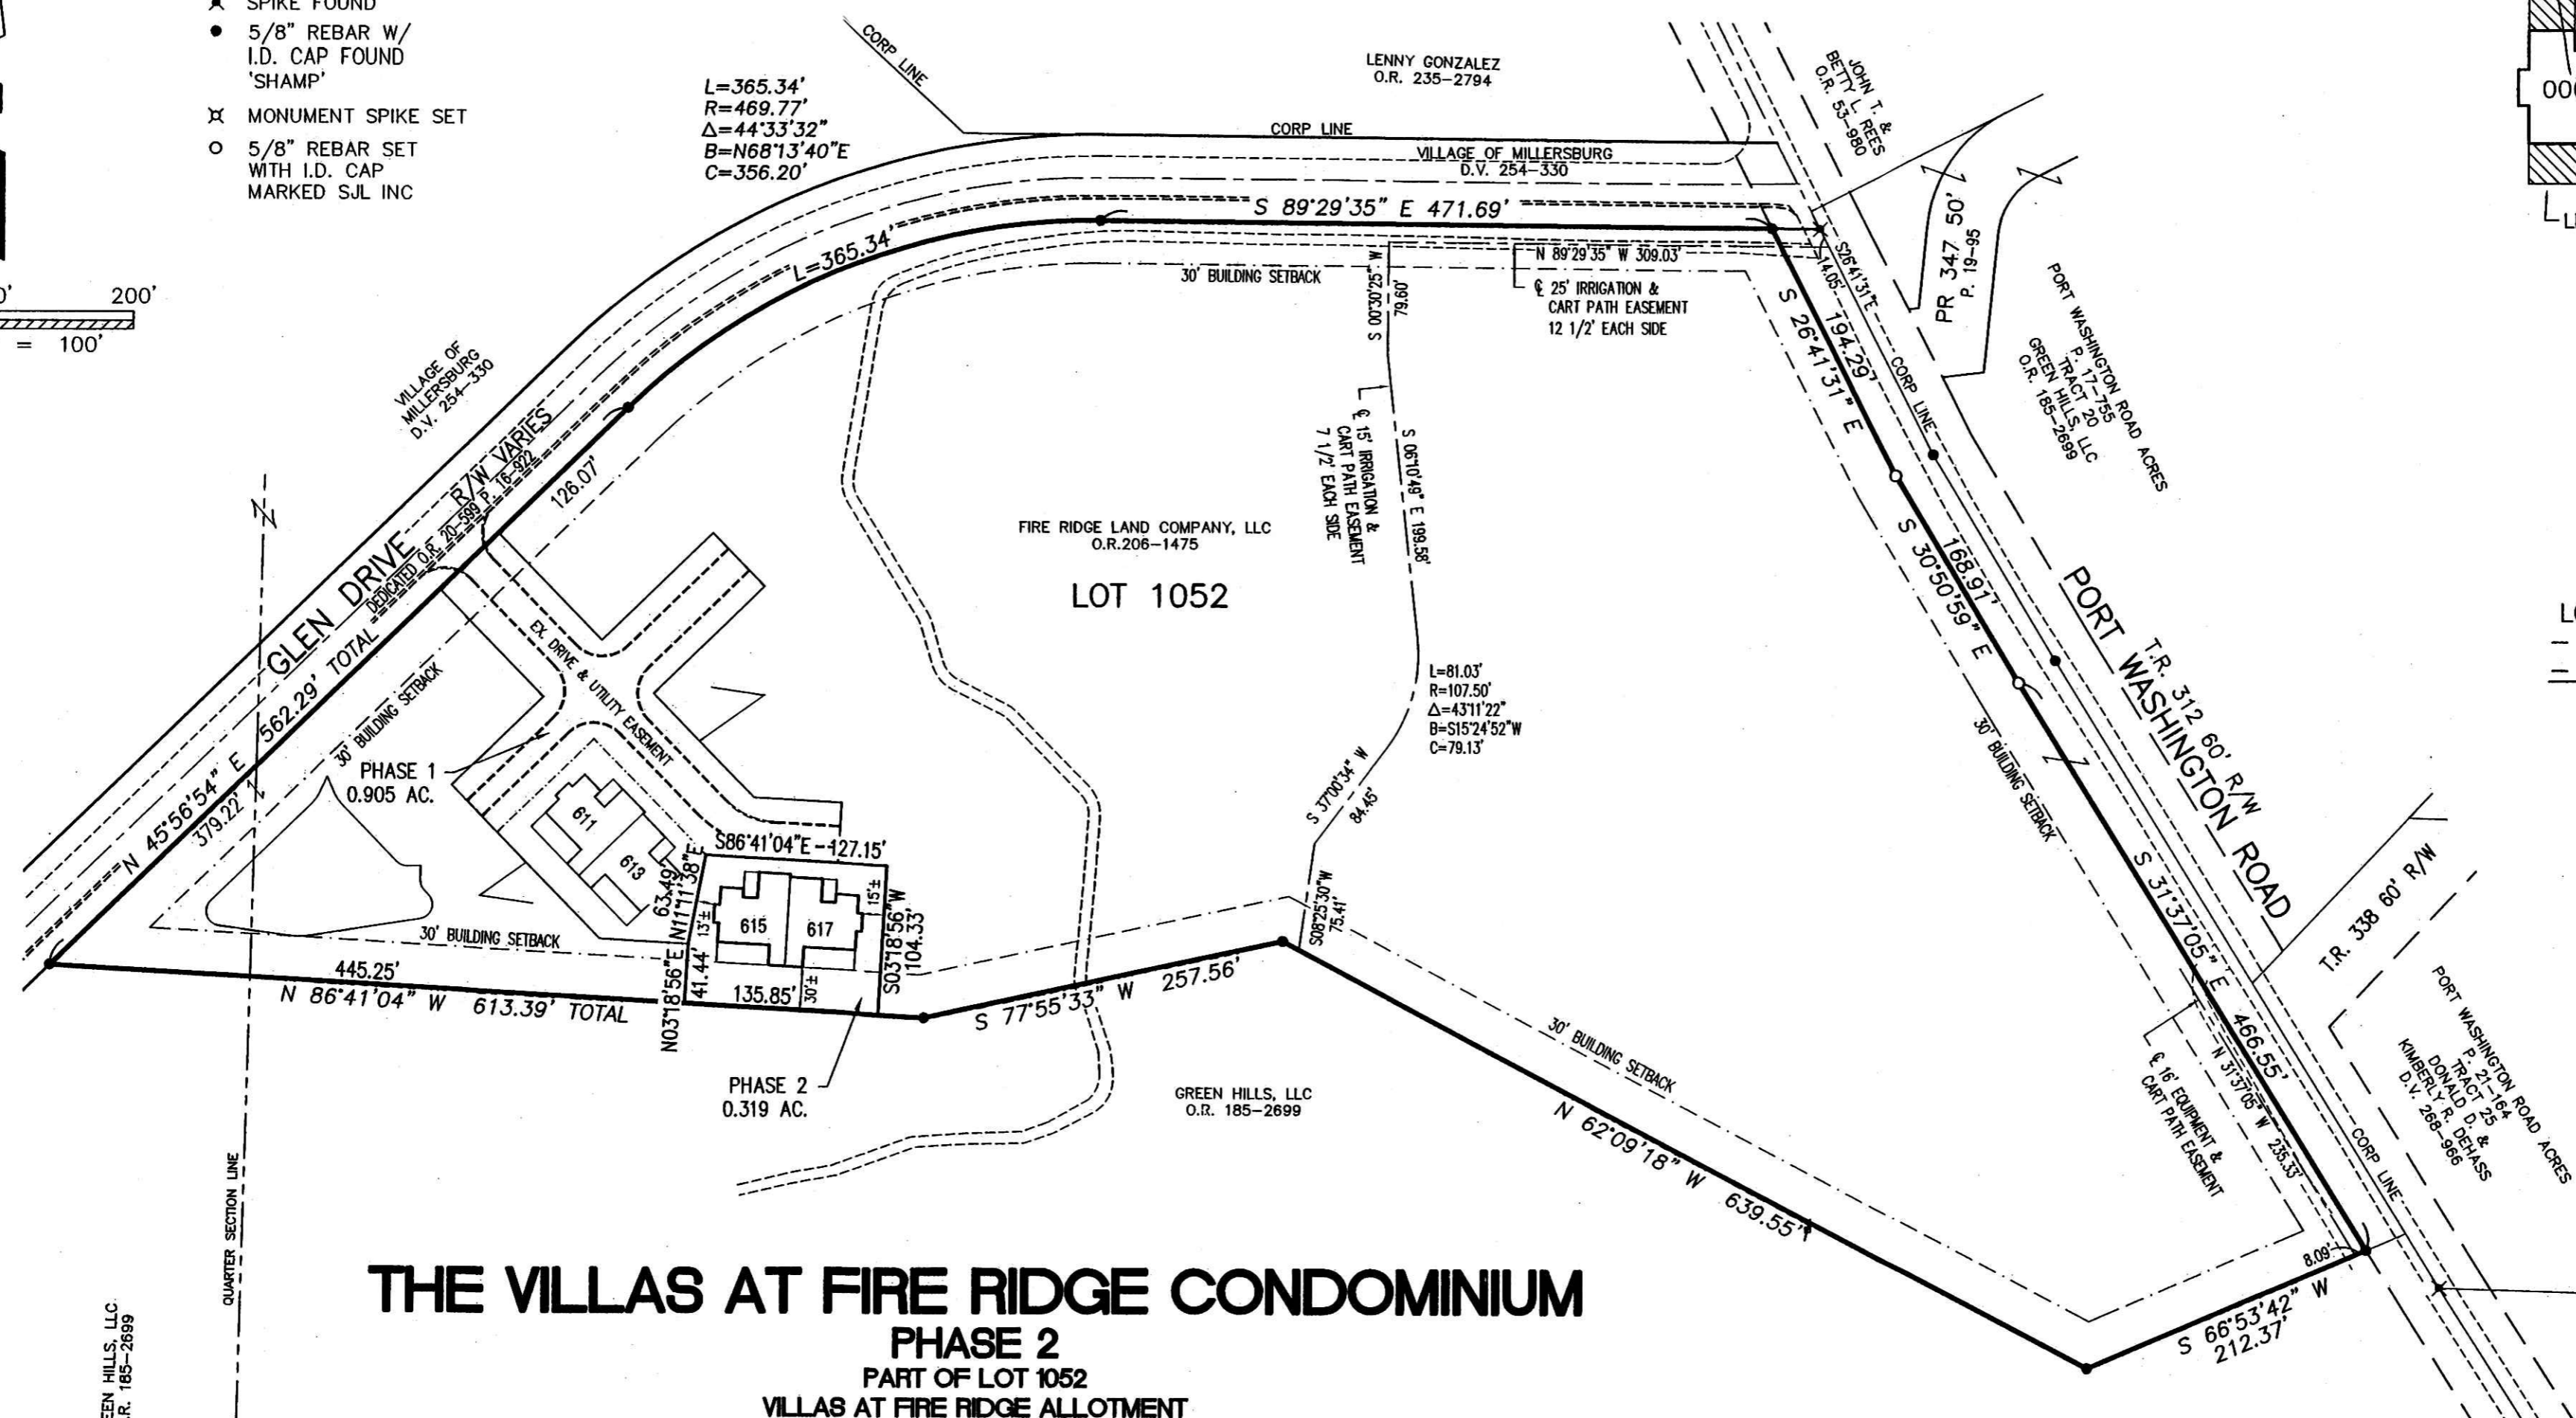

THE VILLAS AT FIRE RIDGE CONDOMINIUM
PHASE 2
 PART OF LOT 1052
 VILLAS AT FIRE RIDGE ALLOTMENT
 PLAT VOL. 19, PG. 1665
VILLAGE OF MILLERSBURG
 HOLMES COUNTY, OHIO

LEGEND

UNIT	PLAN	LIVING	BASEM'T	GARAGE	TOTALS
615	BARRINGTON	1694 SF.	1694 SF.	572 SF.	3960 SF.
617	BARRINGTON	1694 SF.	-----	528 SF.	2222 SF.

REFERENCE SURVEY
 Survey of a 16.172 AC. parcel by Jim Shamp of Heartland Surveying, Inc.

ENGINEER'S DECLARATION: I declare that this plan was prepared from an actual survey. That the same shows graphically, insofar as possible, the location of the boundaries, the layout, location and dimensions of units and of the buildings, the location and layout of limited common elements, the location and layout of common elements, and the location of appurtenant easements, if any.

SURVEYOR'S DECLARATION: I declare that this plan was prepared from an actual survey. That the same shows graphically, insofar as possible, the location of the boundaries, the layout, location and dimensions of units and of the buildings, the location and layout of limited common elements, the location and layout of common elements, and the location of appurtenant easements, if any.



TRANSFER NOT NECESSARY
 DATE September 29, 2012
 AUDITOR Jackie Meeker
 JW 2 of 2 9/25/2012 JWS

Mark E. Purdy 9-13-12
 Mark E. Purdy, P.S. 7307 Date

William P. Whyte 9-13-12
 William P. Whyte, P.E. 71532 Date

SHAFFER, JOHNSTON, LICHTENWALTER & ASSOCIATES, INC.
 Consulting Engineers & Surveyors
 3477 Commerce Parkway, Suite C
 Wooster, Ohio 44691
 TEL (330) 345-6377 FAX (330) 345-6725 EMAIL sjl@sjl-inc.com

DRAWN C. Feb	CHECKED	SCALE 1" = 100'	DATE 09/10/12
DWG NO: EW-2332BB	JOB NO: EW-2332BB	SHEET 1 OF 1	