



SCALE: 1"=200'


- STONE FOUND
- ▲ R.R. SPIKE FOUND
- 5/8" REBAR FOUND UNLESS OTHERWISE NOTED
- △ R.R. SPIKE SET
- 5/8" REBAR SET WITH I.D. CAP I.D. CAP MARKED "BAKER 6938"



WALNUT CREEK TOWNSHIP  
1ST. QTR., LOT 1  
T-9 N; R-5 W  
HOLMES COUNTY, OHIO

SURVEYED FOR: DON GINGERICH

201200079693  
Filed for Record in  
HOLMES COUNTY, OH  
ANITA HALL, COUNTY RECORDER  
09-26-2012 At 09:06 am.  
SMALL PLAT 40.00  
OR Book 19 Page 2134 - 2134  
ORV 238 pg 330

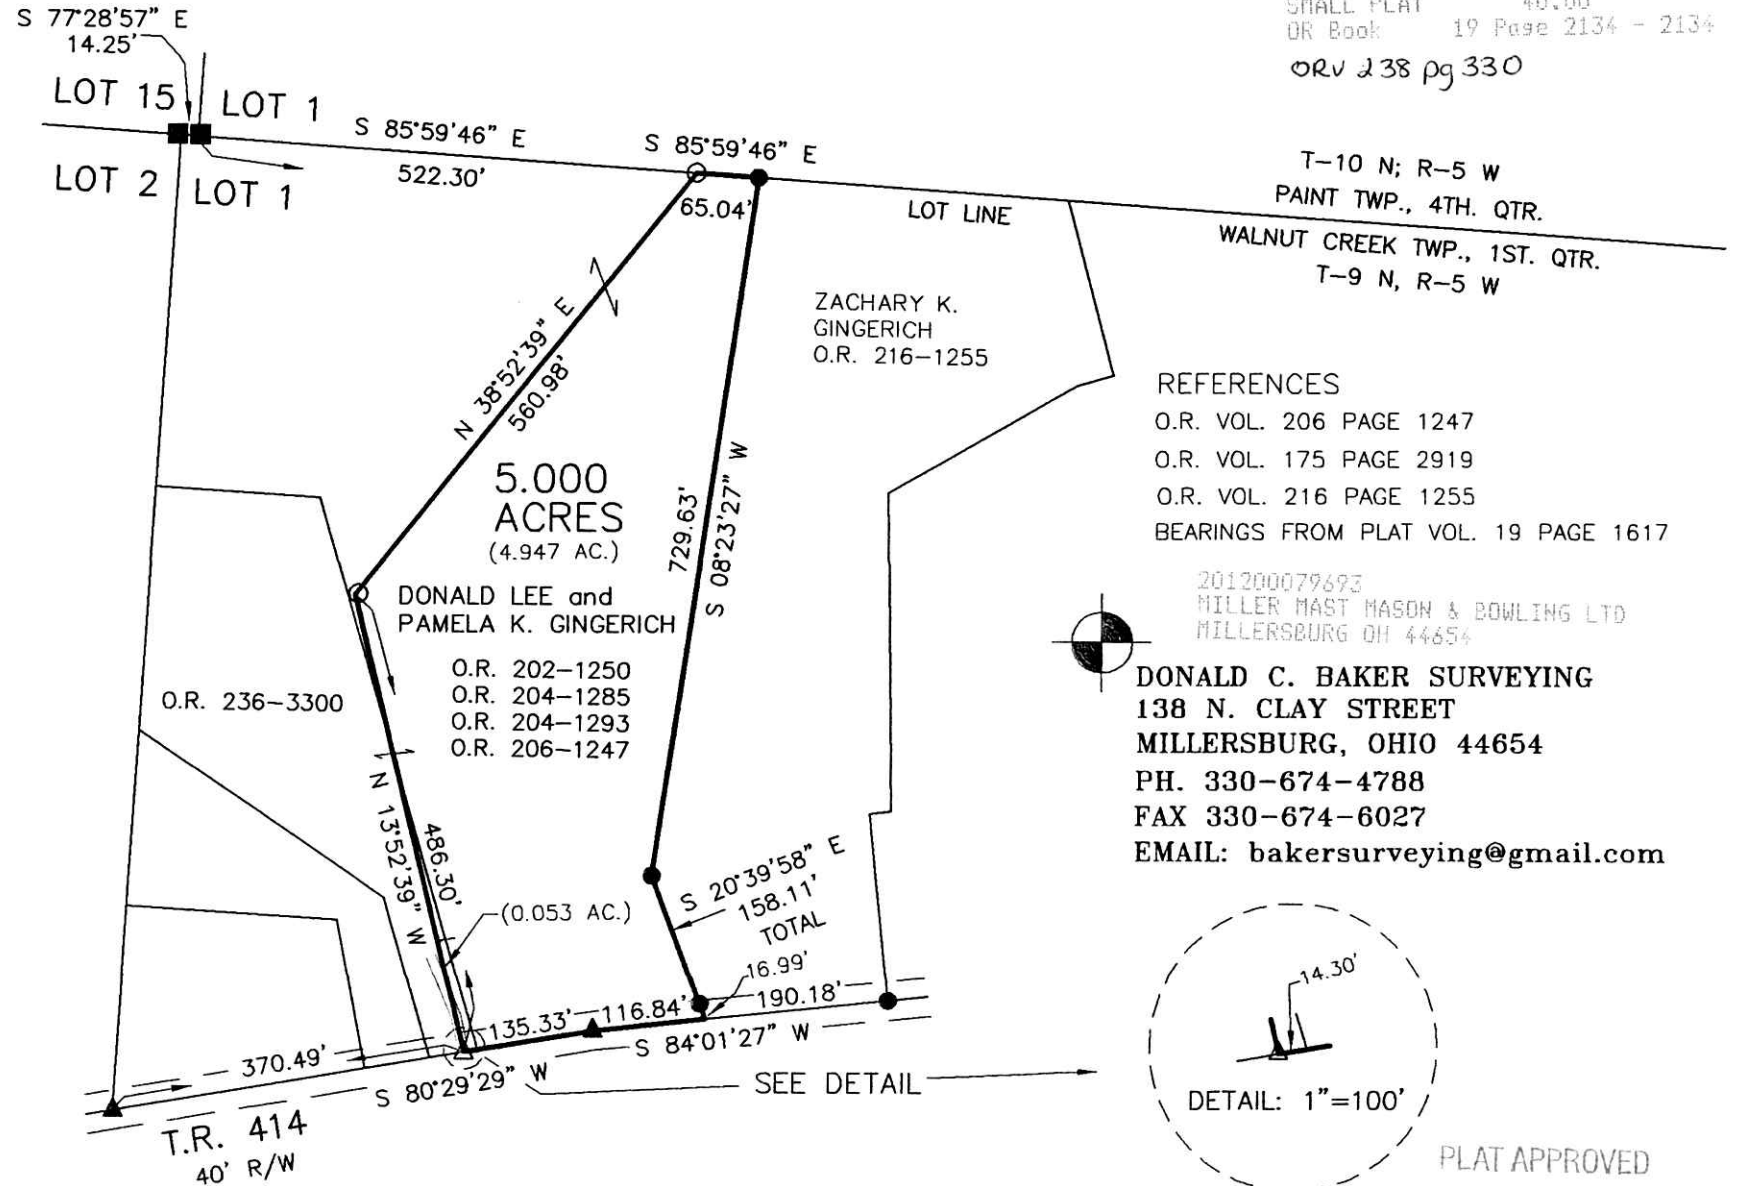

I CERTIFY THIS SURVEY TO BE CORRECT TO THE BEST OF MY KNOWLEDGE.

*A-L-G*

AARON L. GERBER P.S. 8379

DATE: AUGUST 15, 2012

ALG\CJG

FILE NAME: WORK5-2012\S-358-12\AG-MD