

Instrument 201300082612 OR Book Page 19 2237

201300082612 CRITCHFIELD... & JOHNSTON ATTYS MILLERSBURG OH


APPROVED FOR TRANSFER ONLY NO SUBDIVISION PLAT REQUIRED

(O.R.C. 711.001 & 711.131) Lot(s) not for building unless approved by Board of Health HOLMES CO. PLANNING COMMISSION

By *JB* Date 3-25-13

KNOX TOWNSHIP S.W. QTR. SECTION 30 T-19 N; R-15 W HOLMES COUNTY, OHIO

SURVEYED FOR:

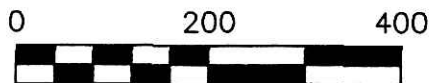

SCALE: 1"=200'

- ▲ R.R. SPIKE FOUND
- 5/8" REBAR FOUND UNLESS OTHERWISE NOTED
- 5/8" REBAR SET WITH I.D. CAP I.D. CAP MARKED "BAKER 6938"



I CERTIFY THIS SURVEY TO BE CORRECT TO THE BEST OF MY KNOWLEDGE.

*Donald C. Baker*


DONALD C. BAKER P.S. 6938

DATE: FEB. 21, 2013

KES\CJG

COMP. FILE: WORK4\S-25-13

S-85-13

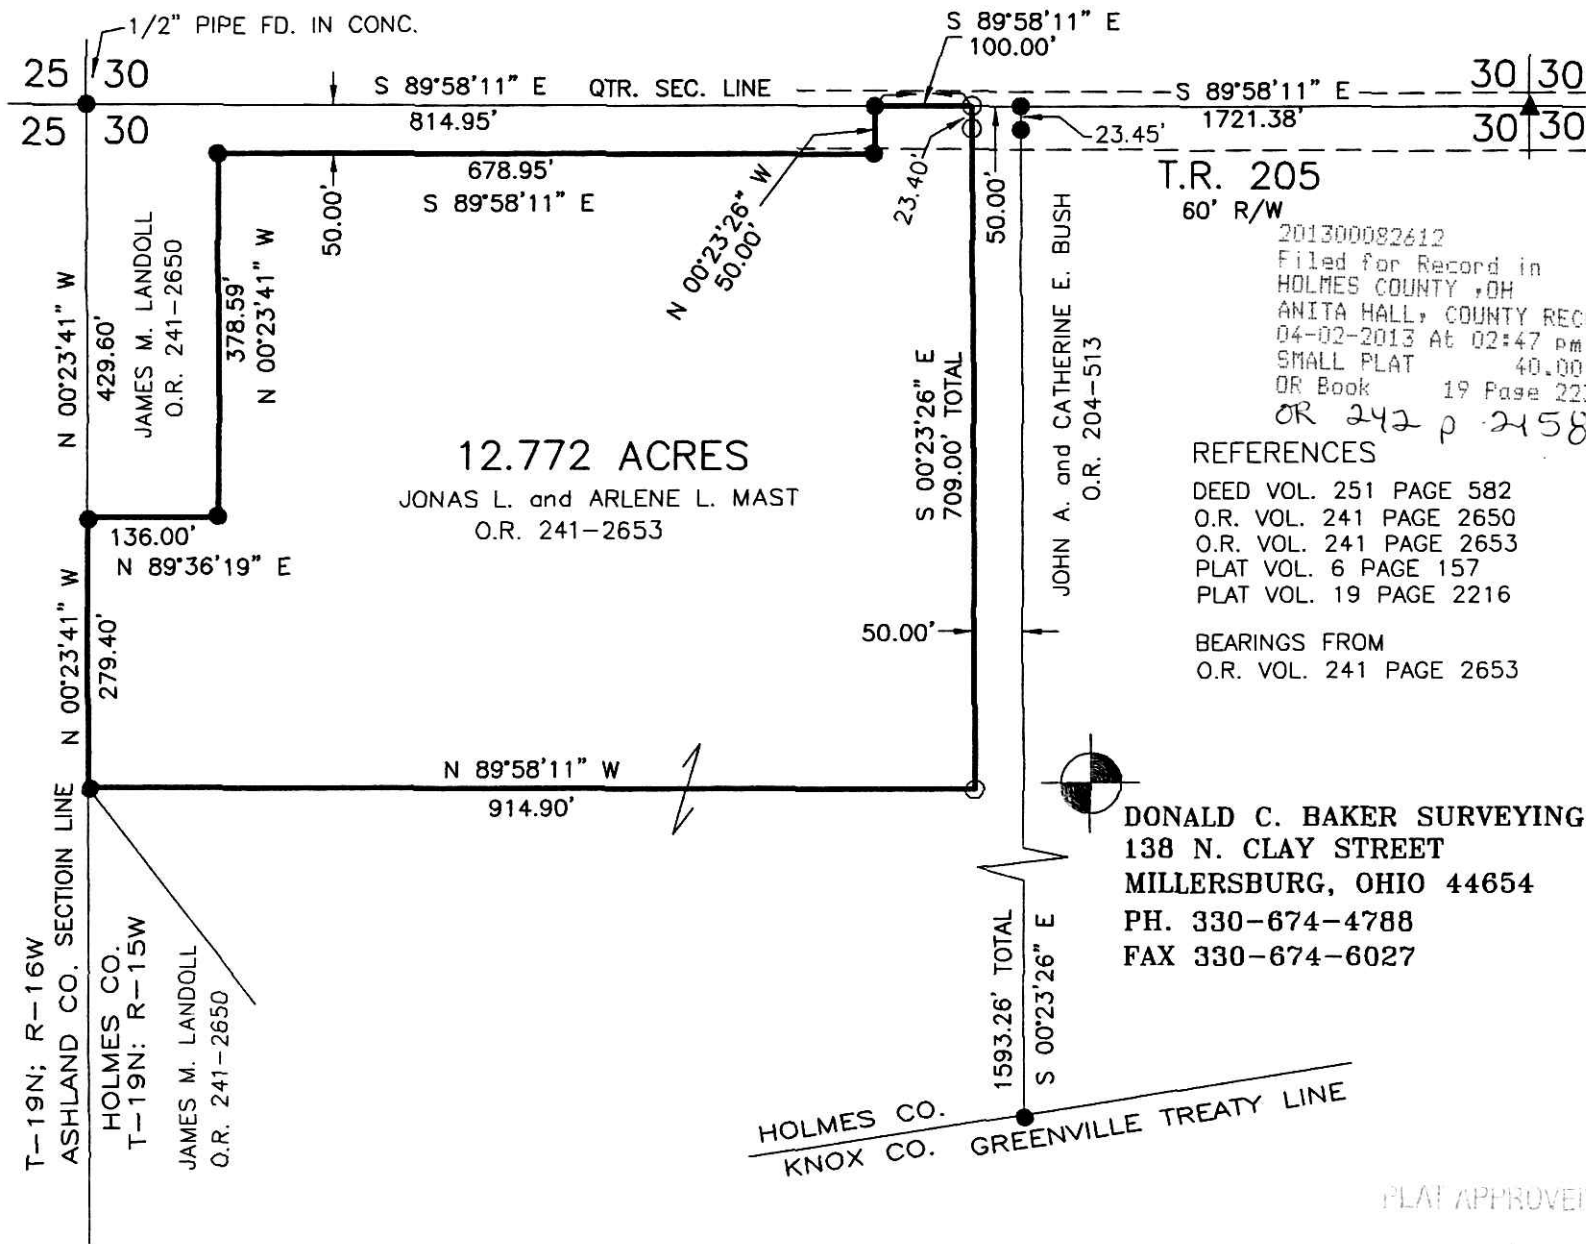

PLAT APPROVED

3/22/2013