

CLARK TOWNSHIP  
 N.W. QTR. SECTION 18  
 T-8 N; R-5 W  
 HOLMES COUNTY, OHIO

Instrument 201300084475 DR Book Page 19 2300

SURVEYED FOR: AARON MILLER



SCALE: 1" = 200'


- 5/8" REBAR FOUND UNLESS OTHERWISE NOTED
- 5/8" REBAR SET WITH I.D. CAP I.D. CAP MARKED "BAKER 6938"

201300084475  
 Filed for Record in  
 HOLMES COUNTY, OH  
 ANITA HALL, COUNTY RECORDER  
 07-25-2013 At 01:25 pm.  
 SMALL PLAT 40.00  
 DR Book 19 Page 2300 - 2300  
 ORV 245 PG 2075

REFERENCES

DEED VOL. 275 PAGE 163  
 DEED VOL. 230 PAGE 125  
 PLAT VOL. 14 PAGE 709  
 BEARINGS FROM PLAT VOL. 14 PAGE 709

201300084475  
 MONROE STREET TITLE CO  
 MILLERSBURG OH 44654

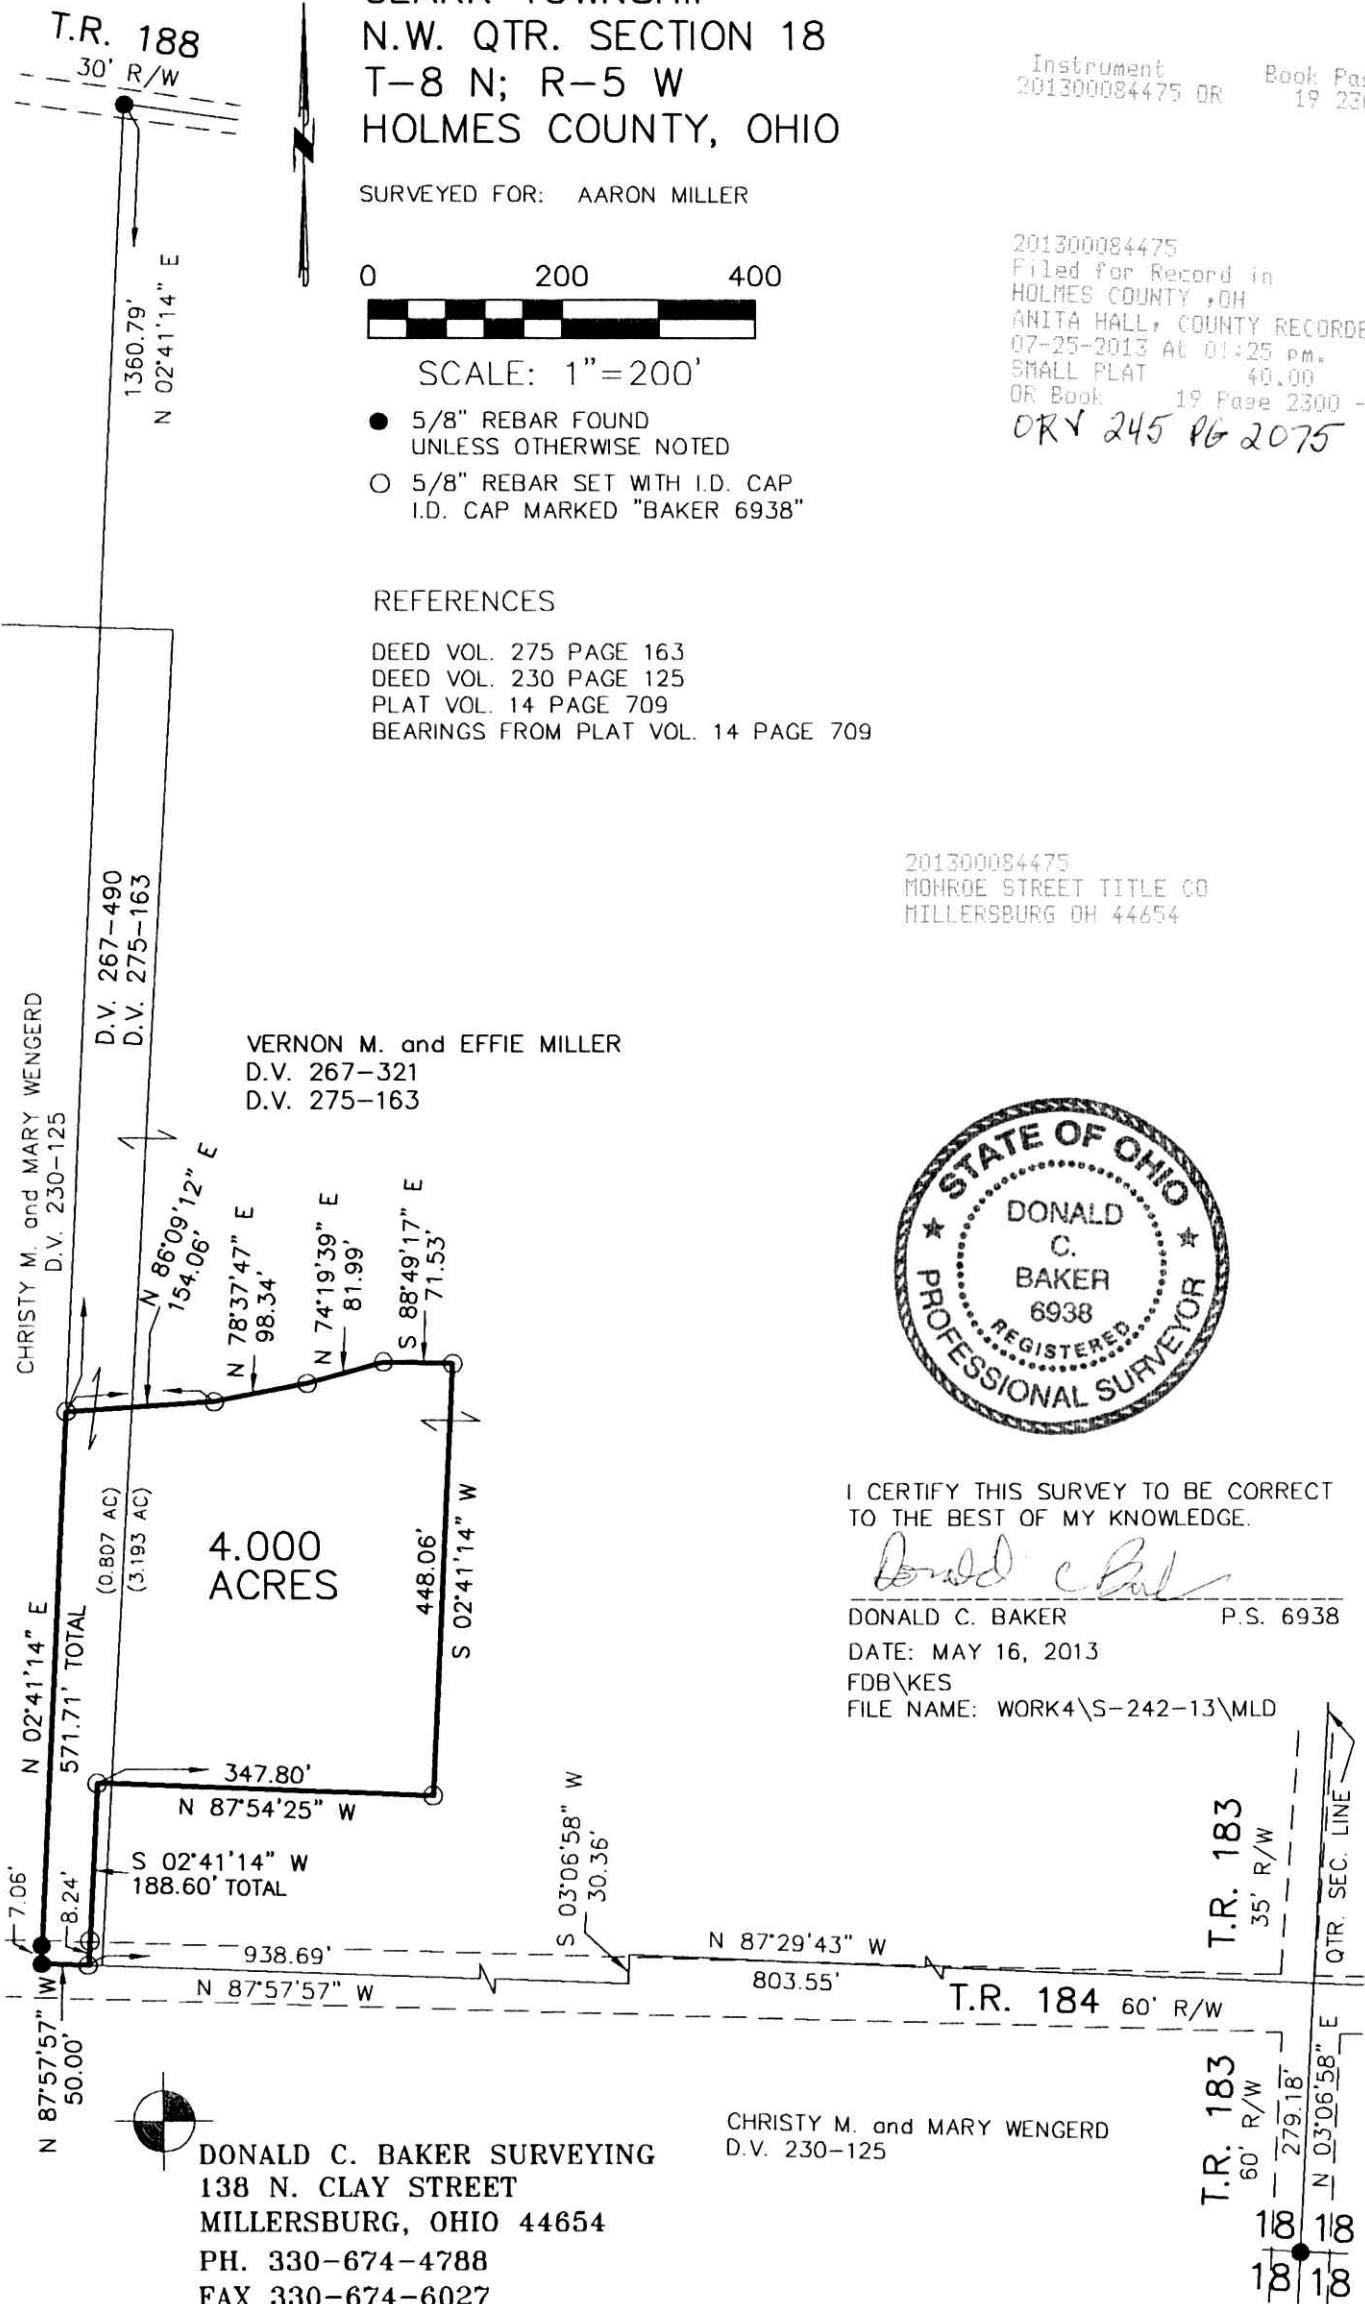

I CERTIFY THIS SURVEY TO BE CORRECT TO THE BEST OF MY KNOWLEDGE.

*Donald C. Baker*

DONALD C. BAKER P.S. 6938

DATE: MAY 16, 2013

FDB\KES

FILE NAME: WORK4\S-242-13\MLD

DONALD C. BAKER SURVEYING  
 138 N. CLAY STREET  
 MILLERSBURG, OHIO 44654  
 PH. 330-674-4788  
 FAX 330-674-6027

CHRISTY M. and MARY WENGERD  
 D.V. 230-125

PLAT APPROVED

6/3/2013