

201400086870
 B: 19 P: 2405
 FILED FOR RECORD IN
 HOLMES COUNTY, OH
 ANITA HALL, COUNTY RECORDER
 01/09/2014 09:31 AM
 SMALL PLAT - 49.00
 PAGES: 1
 ORV 247 Pg 4155

Lot 40

Lot 25

Ferman R. Miller & Linda Miller
 OR 213/1367

Ferman R. Miller & Linda Miller
 DV 271/218

Leroy E Yoder & Carol D. Yoder
 OR 235/156


James J. & Rebekah J. Mast
 OR 222/584
 (PV 10/849)

Iva E. Swartzentruber
 OR 235/150
 2.229 Ac.

Amy Sue Miller, Trustee
 OR 201/547
 (R.H. Hunsinger survey 9/13/1976)

Donald D. Vogt & Evelyn Maxine Vogt, Co-Trustees
 OR 241/2882

Marlin D. Mast
 OR 246/3831

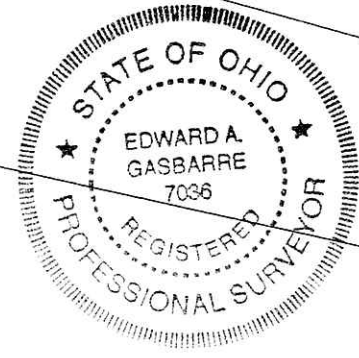

I believe this survey to be correct
 to the best of my knowledge.

Edward A. Gasbarre 12/16/13
 Edward A. Gasbarre, P.S. 7036 Date

APPROVED FOR TRANSFER ONLY
 NO SUBDIVISION PLAT REQUIRED
 (O.R.C. 711.001 & 711.131)
 Lot(s) not for building unless
 approved by Board of Health.
 HOLMES CO. PLANNING COMMISSION
 By *[Signature]* Date 1-8-14

PLAT APPROVED
 1/6/2014

Iva Swartzentruber Survey
 Paint Township
 3rd. Qtr., Lot 25, T-10N, R-4W
 United States Military District
 Holmes County, Ohio

Legend

○ set	⊗ set previously	● found	△ - Spike or magnail set
5/8"x30" Steel Rod W/Yellow I.D. Cap			▲ - Spike or magnail found
Marked "Gasbarre Wooster, Ohio"			X-X Fence Line Evident
● - Iron/Steel monument found			R - Record Dimension
Described in Drawing			M - Measured Dimension
□ - Stone monument found			U - Used Record Dimension

Scale 1" = 100'

Basis of Bearings Common with plat volume 19, page 1266.
 Drawing: 213122.dwg
 December 16, 2013

R.W. **Gasbarre** & Associates, Inc.
 Professional Land Surveying
 401 South Market St. - P.O. Box 44
 Wooster, Ohio 44691
 PH 330-264-9499

