


ORV 248 page 316



Tx: 4002477

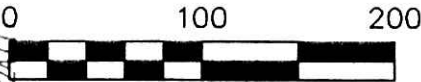

SCALE: 1"=100'


- STONE FOUND
- 5/8" REBAR FOUND
UNLESS OTHERWISE NOTED
- 5/8" REBAR SET WITH I.D. CAP
I.D. CAP MARKED "BAKER 6938"

RESURVEY OF O.R. 223 PG. 147
HARDY TOWNSHIP
1ST. QTR., LOT 27
T-9 N; R-7 W
HOLMES COUNTY, OHIO

SURVEYED FOR: ROBERT SCHMUCKER

REFERENCES

- DEED VOL. 257 PAGE 417
- O.R. VOL. 223 PAGE 147
- PLAT VOL. 13 PAGE 171
- PLAT VOL. 19 PAGE 618
- PLAT VOL. 19 PAGE 990
- BEARINGS FROM
PLAT VOL. 19 PAGE 990

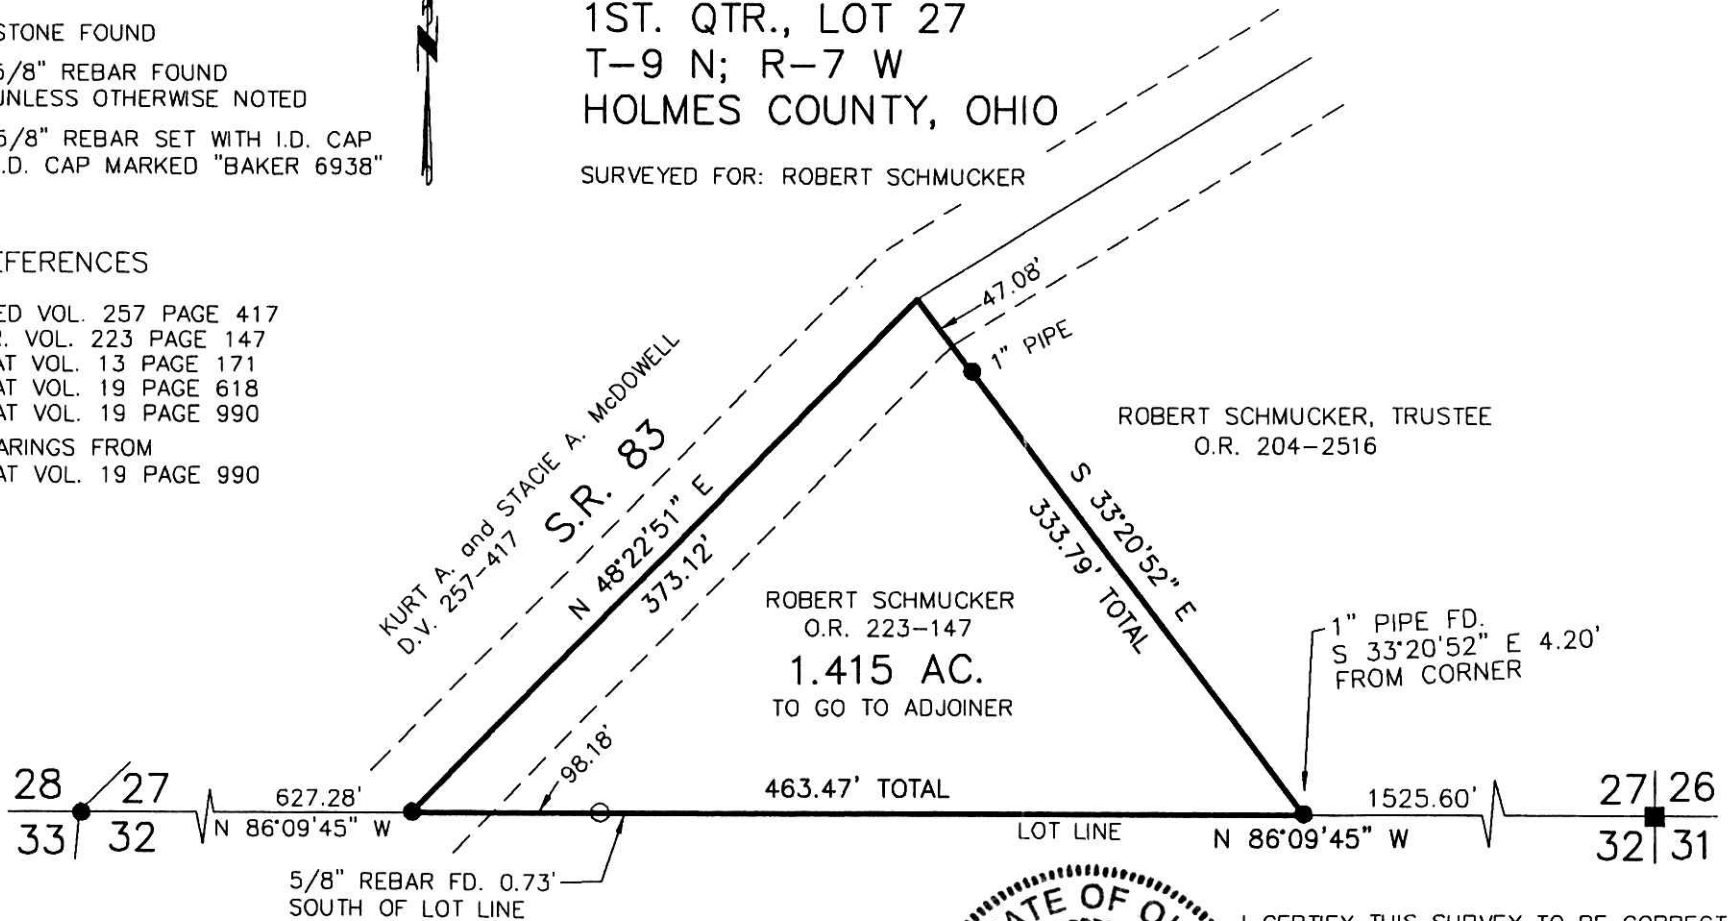

DONALD C. BAKER SURVEYING
138 N. CLAY STREET
MILLERSBURG, OHIO 44654
PH. 330-674-4788
FAX 330-674-6027

PLAT APPROVED

2/25/2014



I CERTIFY THIS SURVEY TO BE CORRECT TO THE BEST OF MY KNOWLEDGE.

Donald C. Baker
DONALD C. BAKER P.S. 6938
DATE: JAN. 22, 2014
FDB\KES
FILE NAME: WORK4\S-511-13