

201400087624

B: 19 P: 2440

FILED FOR RECORD IN
HOLMES COUNTY, OH
ANITA HALL, COUNTY RECORDER
03/03/2014 2:42 PM
SMALL PLAT - 40.00
PAGES: 1

ORY 248 PG 332

8 0 0 3 6 4 3
Tx: 4002482

BUILDING DATA

UNIT NO.	PLAN	LVING	BASEMENT	TOTAL	GARAGE
3	CAMBRIDGE SERIES, BERKSHIRE	1460 S.F.	1408 S.F.	2868 S.F.	523 S.F.
4	CAMBRIDGE SERIES, KINGSTON	1733 S.F.	1676 S.F.	3409 S.F.	576 S.F.



2" Post Taper Typ.

Front Elevation

1/4"=1'

BUILDING 2, UNIT 4
KINGSTON PLAN

BUILDING 2, UNIT 3
BERKSHIRE PLAN




Rear Elevation

1/4"=1'

BUILDING 2, UNIT 3
BERKSHIRE PLAN

BUILDING 2, UNIT 4
KINGSTON PLAN

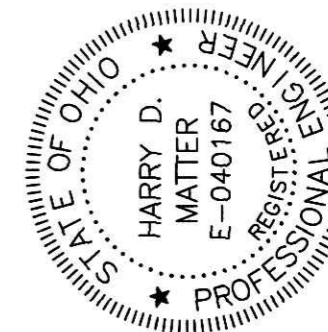

THE BELOW LICENSED PROFESSIONAL ENGINEER CERTIFIES THAT TO THE BEST OF HIS KNOWLEDGE AND BELIEF THIS PLAT GRAPHICALLY SHOWS ALL THE PARTICULARS OF THE BUILDINGS AS CONSTRUCTED.

Harry D. Matter
HARRY D. MATTER, REGISTERED PROFESSIONAL ENGINEER E-040167 DATE 1/31/14

THE BELOW LICENSED PROFESSIONAL SURVEYOR CERTIFIES THAT TO THE BEST OF HIS KNOWLEDGE AND BELIEF THIS PLAT ACCURATELY REFLECTS THE LOCATION OF IMPROVEMENTS AND RECORDED EASEMENTS.

Robert D. Allison
ROBERT D. ALLISON, REGISTERED PROFESSIONAL SURVEYOR 6589 DATE 1/30/2014

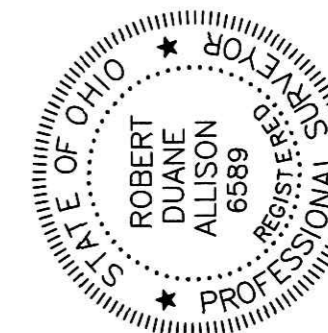


EXHIBIT B-2

THE COVE AT WALNUT CREEK
MILLER-HOPE DEVELOPMENT
WALNUT CREEK, OHIO
44687

NOTES

DATE	5/16/13
1ST FLOOR	SOFT
2ND FLOOR	SOFT
LOWER LEVEL	SOFT
TOTAL	SOFT
GARAGE	SOFT
BONUS	SOFT
DESIGNER	
JOB NO.	

"THE CAMBRIDGE-REVISED"
MILLER-HOPE
WALNUT CREEK, OHIO
44687

SHEET NO.
1 OF 3