


Building #12 Main Floor  
1611 S.F.  
1/4"=1'

TRANSFER NOT NECESSARY  
DATE March 3 2014  
AUDITOR Jackie McKee JS

201400087628  
B: 19 P: 2444  
FILED FOR RECORD IN  
HOLMES COUNTY, OH  
ANITA HALL, COUNTY RECORDER  
03/03/2014 2:42 PM  
SMALL PLAT - 40.00  
PAGES: 1  
ORV 248 Pg 332

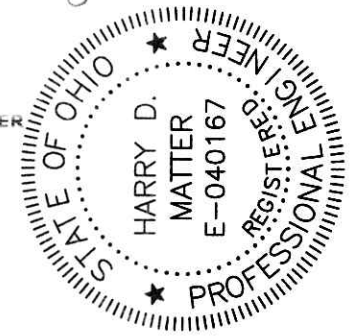


THE BELOW LICENSED PROFESSIONAL ENGINEER CERTIFIES THAT TO THE BEST OF HIS KNOWLEDGE AND BELIEF THIS PLAN GRAPHICALLY SHOWS ALL THE PARTICULARS OF THE BUILDINGS AS CONSTRUCTED.

Harry D. Matter  
HARRY D. MATTER, REGISTERED PROFESSIONAL ENGINEER E-040167 DATE 1/31/14

THE BELOW LICENSED PROFESSIONAL SURVEYOR CERTIFIES THAT TO THE BEST OF HIS KNOWLEDGE AND BELIEF THIS PLAN ACCURATELY REFLECTS THE LOCATION OF IMPROVEMENTS AND RECORDED EASEMENTS.

Robert D. Allison  
ROBERT D. ALLISON, REGISTERED PROFESSIONAL SURVEYOR 6589 DATE 1/30/2014

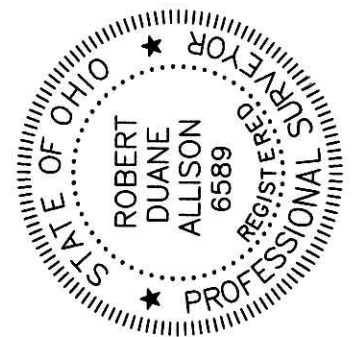

NOTES

DATE	4/29/13
1ST FLOOR	SQFT
2ND FLOOR	SQFT
LOWER LEVEL	SQFT
TOTAL	SQFT
GARAGE	SQFT
BONUS	SQFT
DESIGNER	
JOB NO.	

"THE PRINCETON-REVISED"  
MILLER-HOPE  
WALNUT CREEK, OHIO  
44687

THE COVE AT WALNUT CREEK  
MILLER-HOPE DEVELOPMENT  
WALNUT CREEK, OHIO  
44687

GARAGE  
1" = 10'  
GARAGE - 1789 SQFT

BUILDING 12, UNIT 28

FIRST FLOOR

SERENITY PLAN  
1" = 10'  
LIVING - 1611 SQFT

BUILDING 12, UNIT 27

EXHIBIT B-3

SHEET NO.  
2 OF 3