



- ▲ R.R. SPIKE FOUND
- 5/8" REBAR FOUND UNLESS OTHERWISE NOTED
- △ R.R. SPIKE SET
- 5/8" REBAR SET WITH I.D. CAP I.D. CAP MARKED "BAKER 6938"

REFERENCES

- O.R. VOL. 237 PAGE 2373
- O.R. VOL. 197 PAGE 2225
- O.R. VOL. 208 PAGE 1525
- O.R. VOL. 202 PAGE 556
- O.R. VOL. 183 PAGE 848
- PLAT VOL. 2 PAGE 458
- PLAT VOL. 8 PAGE 81
- PLAT VOL. 14 PAGE 305
- PLAT VOL. 7 PAGE 319
- PLAT VOL. 11 PAGE 192
- PLAT VOL. 19 PAGE 2123
- BEARINGS FROM PLAT VOL. 2 PAGE 458

WALNUT CREEK TOWNSHIP
 S.W. QTR. SECTION 24
 S.E. QTR. SECTION 25
 T-9 N; R-4 W
 HOLMES COUNTY, OHIO
 SURVEYED FOR: KAUFMAN REALTY

201400090359
 8:19 P. 2554
 FILED FOR RECORD IN
 HOLMES COUNTY, OH
 ANITA HALL, COUNTY RECORDER
 09/09/2014 2:23 PM
 PLAT NO. 4430
 PAGES: 1
 ORV 350 Pg 77

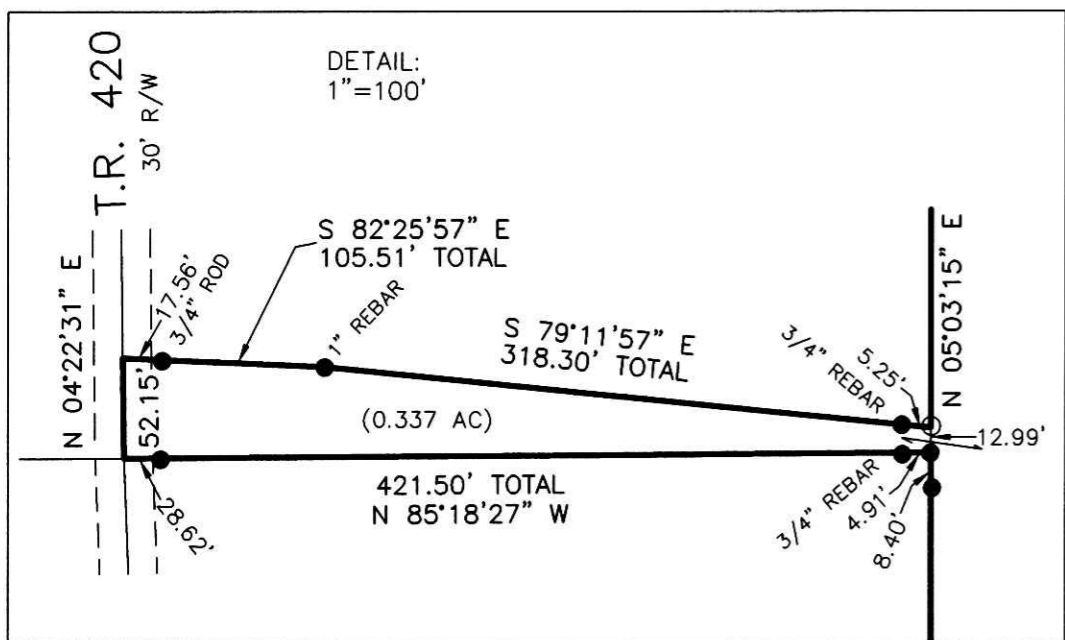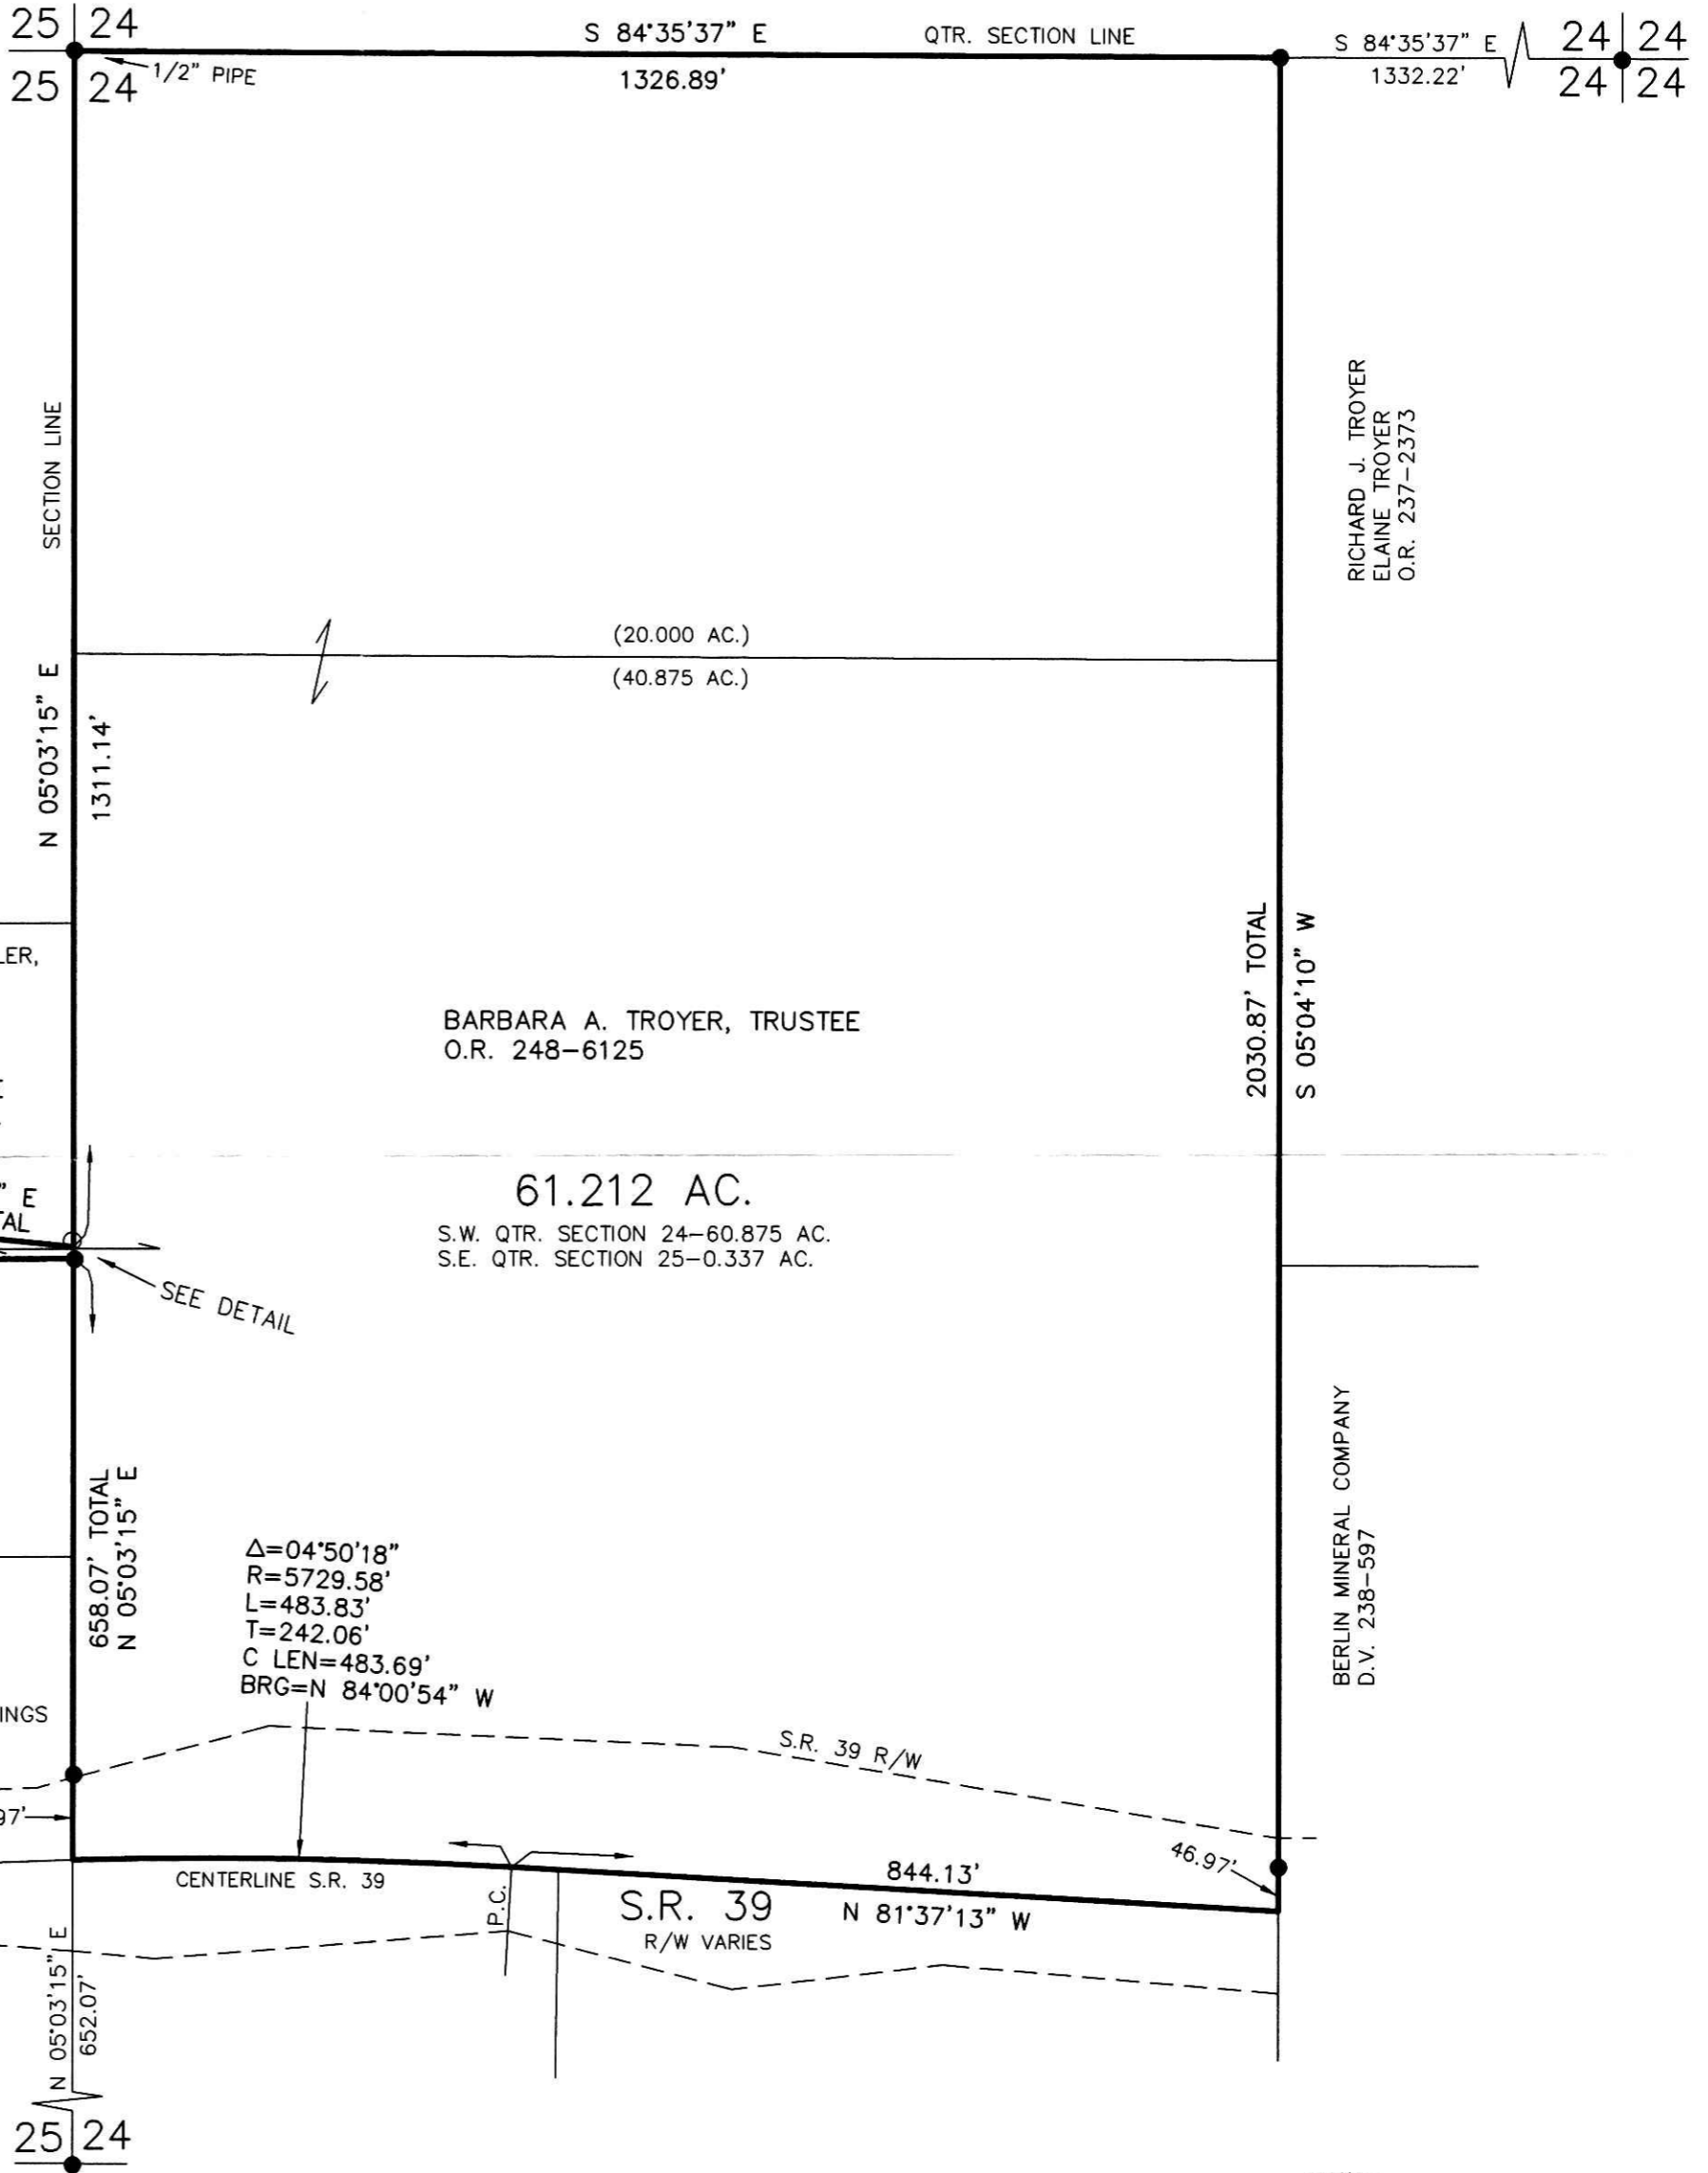

DONALD C. BAKER SURVEYING
 138 N. CLAY STREET
 MILLERSBURG, OHIO 44654
 PH. 330-674-4788
 FAX 330-674-6027

I CERTIFY THIS SURVEY TO BE CORRECT TO THE BEST OF MY KNOWLEDGE.
Donald C. Baker
 DONALD C. BAKER P.S. 6938
 DATE: JULY 31, 2014
 FDB/KES
 FILE NAME: WORK4\S-281-14\DB-MD

APPROVED FOR TRANSFER ONLY
 NO SUBDIVISION PLAT REQUIRED
 (O.R.C. 711.001 & 711.131)
 Lot(s) not for building unless approved by Board of Health.
 HCP
 HOLMES CO. PLANNING COMMISSION
 By: *[Signature]* Date: 8-18-14

PLAT APPROVED
 8/13/2014

