


8 0 1 0 2 4 3  
Tx:4007712

BUILDING DATA

UNIT NO.	PLAN	LIVING	BASEMENT	TOTAL	GARAGE
7	CAMBRIDGE SERIES, BERKSHIRE	1546 S.F.	1490 S.F.	3036 S.F.	547 S.F.
8	CAMBRIDGE SERIES, KINGSTON	1732 S.F.	1676 S.F.	3408 S.F.	592 S.F.

201400091438  
B: 19 P: 2596  
FILED FOR RECORD IN  
HOLMES COUNTY, OH  
ANITA HALL, COUNTY RECORDER  
11/21/2014 3:24 PM  
SMALL PLAT, 40.00  
PAGE 1

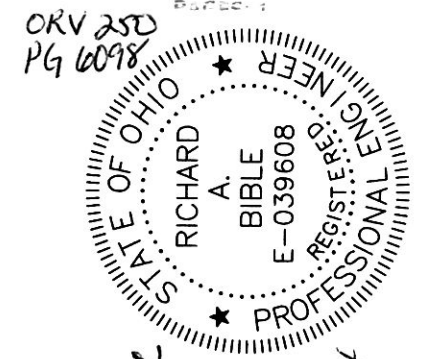

BUILDING 4, UNIT 8  
KINGSTON PLAN

BUILDING 4, UNIT 7  
BERKSHIRE PLAN



BUILDING 4, UNIT 7  
BERKSHIRE PLAN


BUILDING 4, UNIT 8  
KINGSTON PLAN

THE BELOW LICENSED PROFESSIONAL ENGINEER CERTIFIES THAT TO THE BEST OF HIS KNOWLEDGE AND BELIEF THIS PLAT GRAPHICALLY SHOWS ALL THE PARTICULARS OF THE BUILDINGS AS CONSTRUCTED.

*Richard A. Bible*  
RICHARD A. BIBLE, REGISTERED PROFESSIONAL ENGINEER E-039608 DATE 10/23/14

THE BELOW LICENSED PROFESSIONAL SURVEYOR CERTIFIES THAT TO THE BEST OF HIS KNOWLEDGE AND BELIEF THIS PLAT ACCURATELY REFLECTS THE LOCATION OF IMPROVEMENTS AND RECORDED EASEMENTS.

*Robert D. Allison*  
ROBERT D. ALLISON, REGISTERED PROFESSIONAL SURVEYOR 6589 DATE 10/23/2014

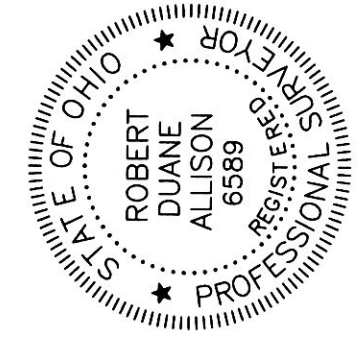

NOTES

DATE	9/12/14
1ST FLOOR	SQFT
2ND FLOOR	SQFT
LOWER LEVEL	SQFT
TOTAL	SQFT
GARAGE	SQFT
BONUS	SQFT
DESIGNER	
JOB NO.	

MILLER-HOPE  
WALNUT CREEK, OHIO  
44687

SHEET NO.  
1 OF 3

THE COVE AT WALNUT CREEK  
MILLER-HOPE DEVELOPMENT  
WALNUT CREEK, OHIO  
44687